


EASTRIDGE LANDING SUBDIVISION, PHASE V


ARTHUR, ONTARIO

TOWNSHIP OF WELLINGTON NORTH

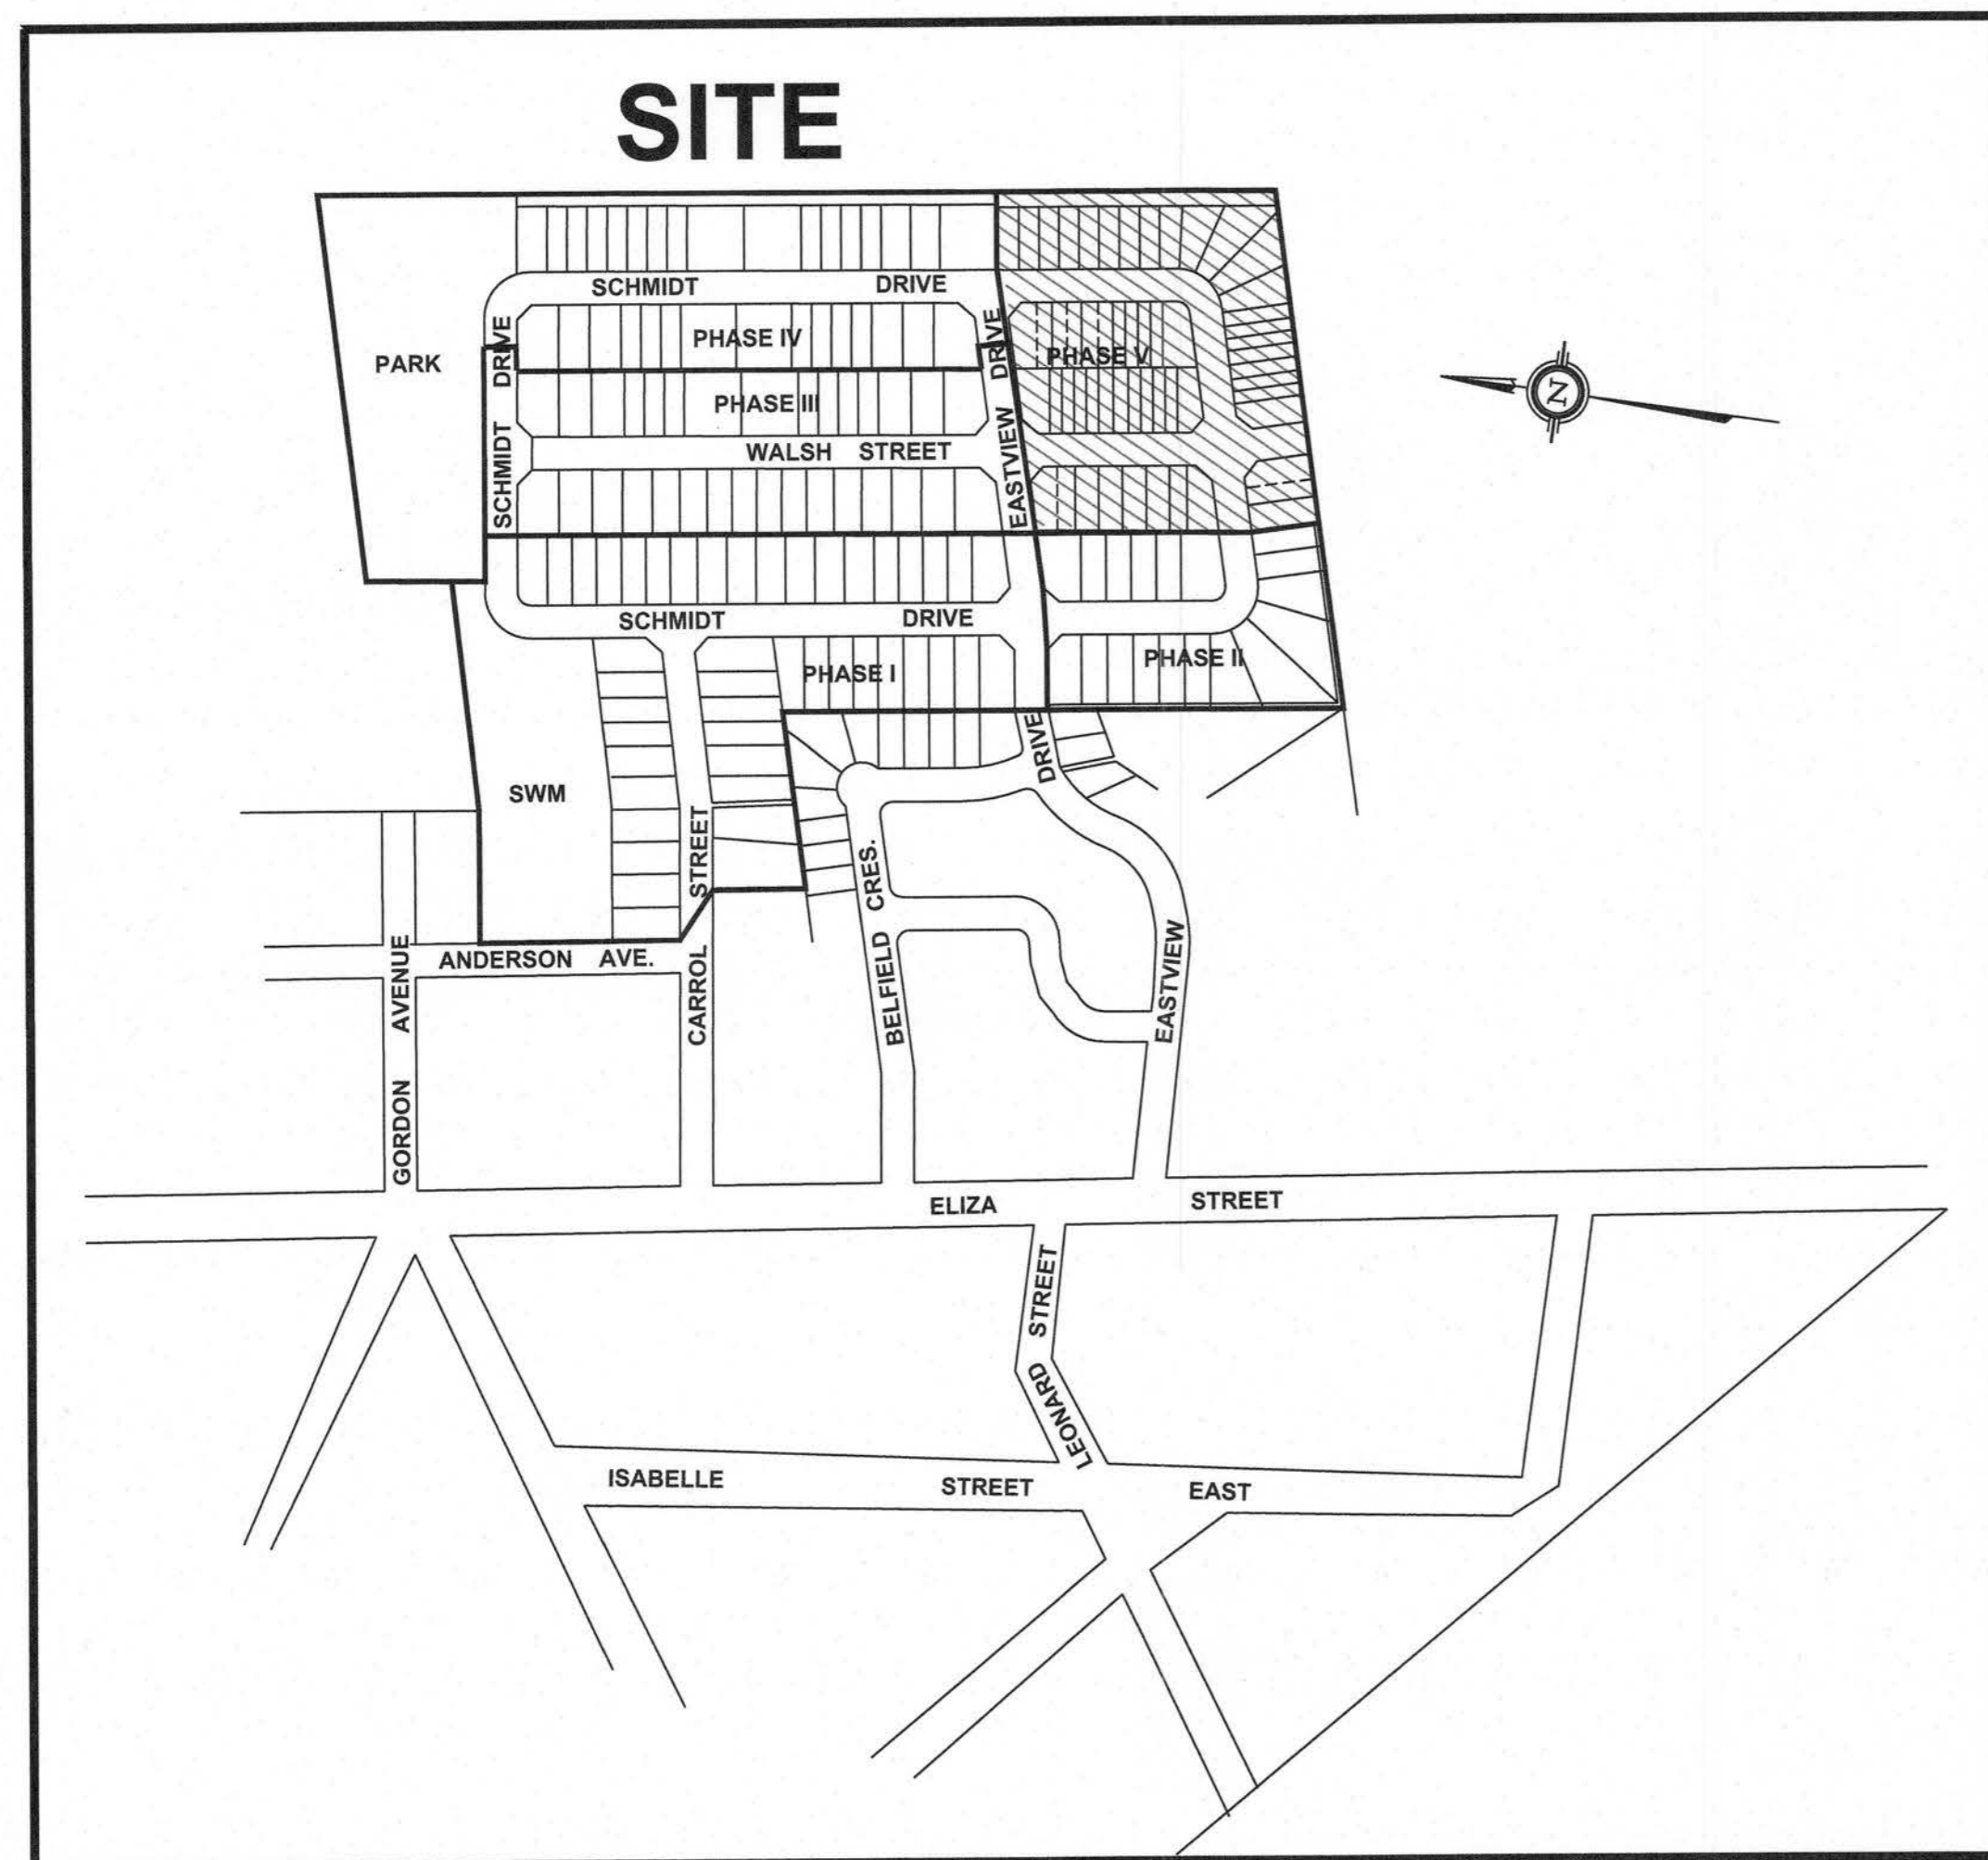

LIST OF DRAWINGS

PLAN	DESCRIPTION	LOCATION
GSP-1	GENERAL SERVICING PLAN	
PRE-1	EXISTING CONDITIONS PLAN	
PD-1	POST-DEVELOPMENT STORM DRAINAGE AREAS	
SA-1	SANITARY SEWER DRAINAGE PLAN	
GCP	GENERAL OVERALL LOT GRADING CONTROL PLAN	
GCP-1	LOT GRADING CONTROL PLAN	
GCP-2	LOT GRADING CONTROL PLAN	
GCP-3A	LOT GRADING CONTROL PLAN	
ECP	OVERALL EROSION CONTROL PLAN	
PP-1	PLAN and PROFILE	SCHMIDT DRIVE 1+000 TO 1+220
PP-2	PLAN and PROFILE	WALSH STREET 1+000 TO 1+300
PP-3	PLAN and PROFILE	WALSH STREET 1+200 TO 1+500
PP-4	PLAN and PROFILE	EASTVIEW DRIVE 1+000 TO 1+120
PP-5	PLAN and PROFILE	SCHMIDT DRIVE 1+180 TO 1+480
PP-6	PLAN and PROFILE	SCHMIDT DRIVE 1+480 TO 1+720
DET-1	DETAILS PLAN	
SWM-1	STORMWATER MANAGEMENT POND	

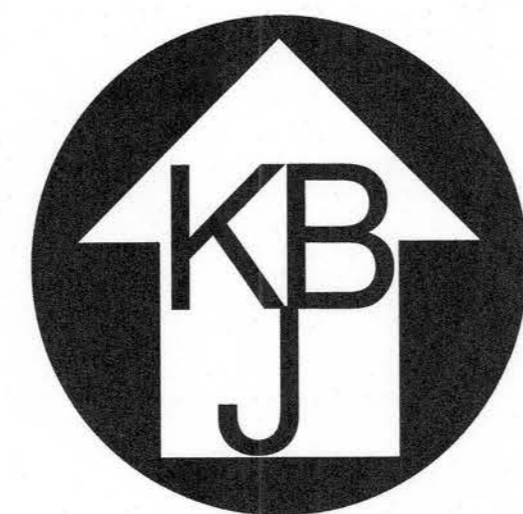


K. J. BEHM AND ASSOCIATES INC.

CONSULTING ENGINEERS

55 ERB STREET EAST, SUITE 101, WATERLOO, ONTARIO, N2J 4K8

PHONE (519) 742 3510 FAX (519) 742 3462

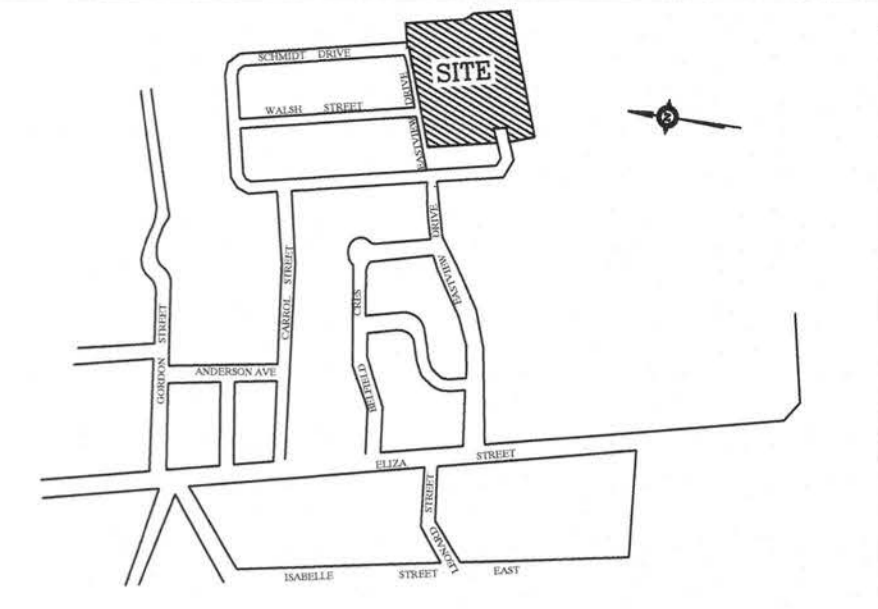

SITE LOCATION N.T.S.

BENCH MARKS:
 1. TOP OF STORM MANHOLE IN BOULEVARD AT SOUTHWEST CORNER OF ELBA STREET AND GORDON STREET ELEV 462.0
 2. TOP OF SANITARY MANHOLE IN CUL-DE-SAC ON FARRER STREET. ELEV 462.31
 3. TOP OF SANITARY MANHOLE AT EXISTING EAST LIMIT OF EASTVIEW AVENUE. ELEV 464.27

- LEGEND:**
- 464.50 EXISTING CONTOURS
 - PROPOSED ELEVATIONS
 - EXISTING ELEVATIONS
 - DRAINAGE DIRECTION
 - DC DROP CURB
 - ILD IN-LINE DRAIN
 - DRIVEWAY LOCATION
 - TP TACTILE PLATES
 - LUIF LOWEST UNDERSIDE FOOTING (DUE TO SHALLOW SANITARY SERVICE)
 - PROPOSED GROUND ELEVATION @ FRONT AND REAR OF BUILDINGS
 - TRANSFORMER
 - CABLE TV VAULT
 - CABLE TV PEDESTAL
 - S/L STREETLIGHT
 - JB JUNCTION BOX
 - LC-A LIGHTING PEDESTAL
 - FIBRE OPTICS VAULT
 - BB BELL BOXES
 - 8+ W WIGHTMAN VAULTS & GPS

- NOTES:**
- 1) ALL DRAINAGE TO BE DIRECTED TO SIDE AND REAR LOT SWALES
 - 2) DESIRABLE SWALE DEPTH = 230mm
MINIMUM SWALE DEPTH = 150mm
MAXIMUM SWALE DEPTH = 1000mm
 - 3) MAXIMUM DRIVEWAY GRADIENT = 6%
 - 4) MAXIMUM SIDE SLOPE 3:1
 - 5) ALL REAR YARD CATCHBASINS TO BE INSTALLED WITH FRAME & GRATE (OPSD 400.110)
 - 6) DRIVEWAYS TO BE LOCATED NO CLOSER THAN 1.5M FROM HYDRANTS, STREET LIGHTS AND TRANSFORMERS.
 - 7) ALL ROOF WATER TO DISCHARGE TO GROUND SURFACE.
 - 8) CHAIN LINK FENCE TO BE PER OPSD 972.130 AND OPSD 772. NO GATES IN FENCE ARE PERMITTED. FENCE TO BE LOCATED 0.10m ON TOWNSHIP PROPERTY.
 - 9) POST AND RAIL FENCE TO BE PER OPSD 971.101 AND OPSD 772. NO GATES IN FENCE ARE PERMITTED. FENCE TO BE LOCATED 0.10m ON TOWNSHIP PROPERTY.
 - 10) LOTS 42-64 INCLUSIVE: REAR YARD AREAS TO BE GRADED TO PROMOTE SHEET FLOW ONTO ADJACENT PROPERTY TO THE EAST OF THE SITE. MAXIMIZE FRONT YARD AND ROOFTOP DRAINAGE TO THE INTERNAL STREET
 - 11) FRONT & REAR BUILDING ELEVATIONS TO BE ADJUSTED AT BUILDING PERMIT ACCORDING TO THE BUILDING LOCATION ON THE SITE.
 - 12) DRIVEWAY CHANGED BLOCK 31 10/08/22 KJB
 - 13) LOT NUMBERING CHANGED FOR PHASE IV 20/12/21 KJB
 - 14) REAR LOTS 16-21 CHANGED 06/06/21 KJB
 - 15) STORM SEWER BLOCKS 30 & 31 CHANGED 06/06/21 KJB
 - 16) GENERAL REVISIONS 15/02/21 KJB
 - 17) GENERAL REVISIONS 28/12/20 KJB
 - 18) GENERAL REVISIONS 16/12/20 KJB
 - 19) GENERAL REVISIONS 22/06/20 KJB
 - 20) GENERAL REVISIONS 15/03/20 KJB
 - 21) GENERAL REVISIONS 22/06/20 KJB
 - 22) GENERAL REVISIONS 15/03/20 KJB
 - 23) GENERAL REVISIONS 09/05/19 KJB
 - 24) GENERAL REVISIONS 13/03/19 KJB
 - 25) EX. LOT CORNER ELEVATIONS ADDED 21/11/18 KJB
 - 26) GENERAL REVISIONS 25/06/18 KJB
 - 27) GENERAL REVISIONS 22/02/18 KJB
 - 28) GENERAL REVISIONS 01/30/18 KJB
 - 29) GENERAL REVISIONS 02/11/17 KJB
 - 30) GENERAL REVISIONS 14/02/17 KJB
 - 31) GENERAL REVISIONS 30/09/16 KJB
 - 32) REARYARD SWALE & STORM SEWER ADDED ON LOTS 73-78 23/08/16 KJB
 - 33) GENERAL REVISIONS DATE INTL.

REVISIONS

No.	DESCRIPTION	DATE	INTL.


CHECKED: APPROVED:



K. J. BEHM AND ASSOCIATES INC.
 CONSULTING ENGINEERS
 55 ERB STREET EAST, SUITE 101
 WATERLOO, ONTARIO N2J 4K8
 PHONE: (519) 742-3510 FAX: (519) 742-3462

EASTRIDGE LANDING
SUBDIVISION PHASE III, IV, V
 ARTHUR, ONTARIO

LOT GRADING CONTROL PLAN

DRAWN: WDH SCALE: 1 : 500 DWG. No.: GCP-1
 DESIGN: KJB DATE: APRIL, 2016
 CHECKED: KJB PROJECT No.: 070119

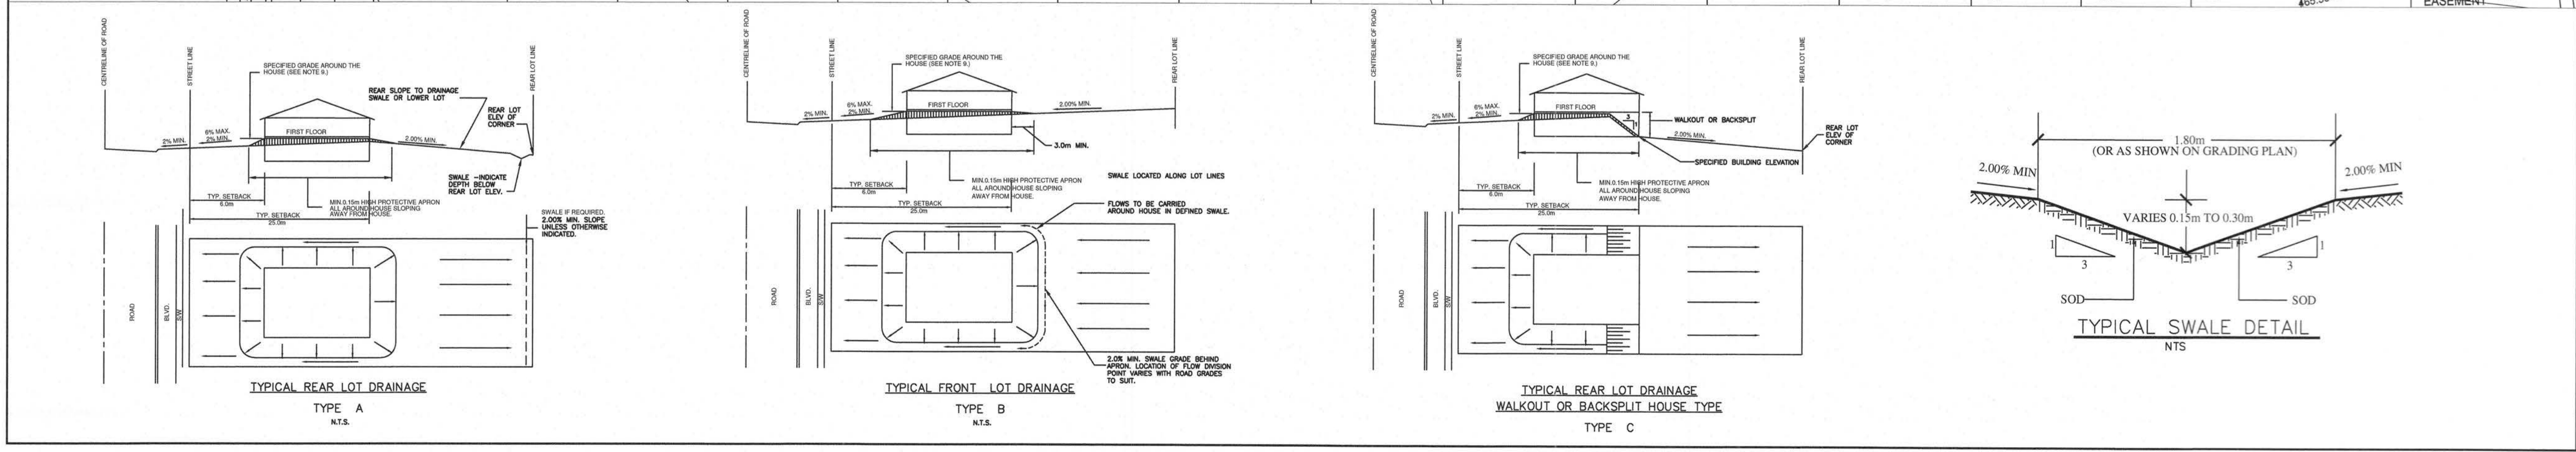

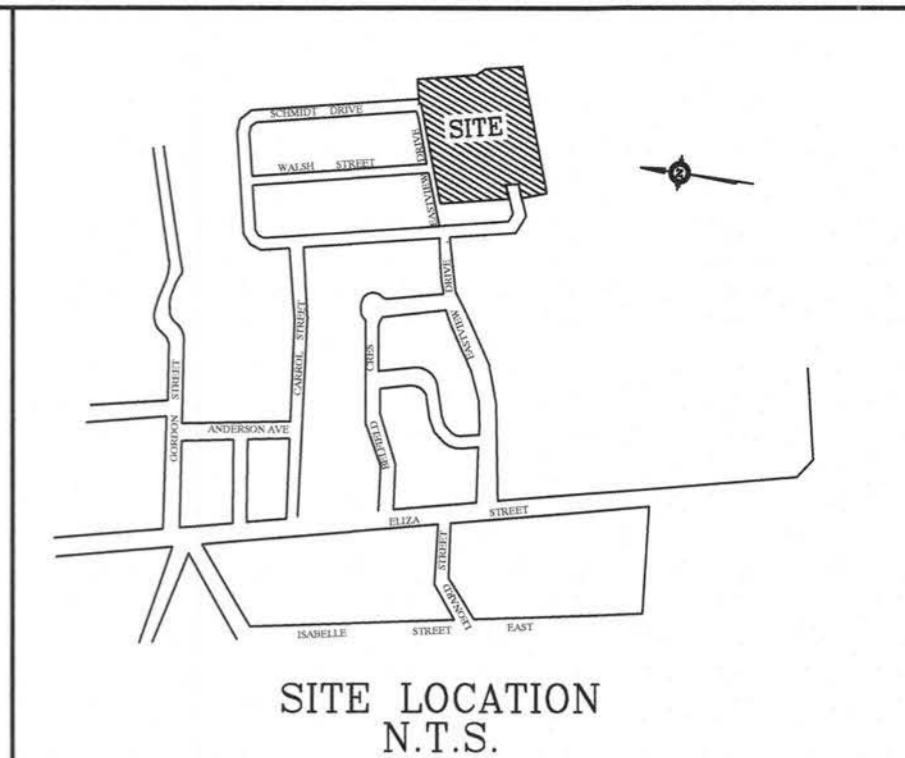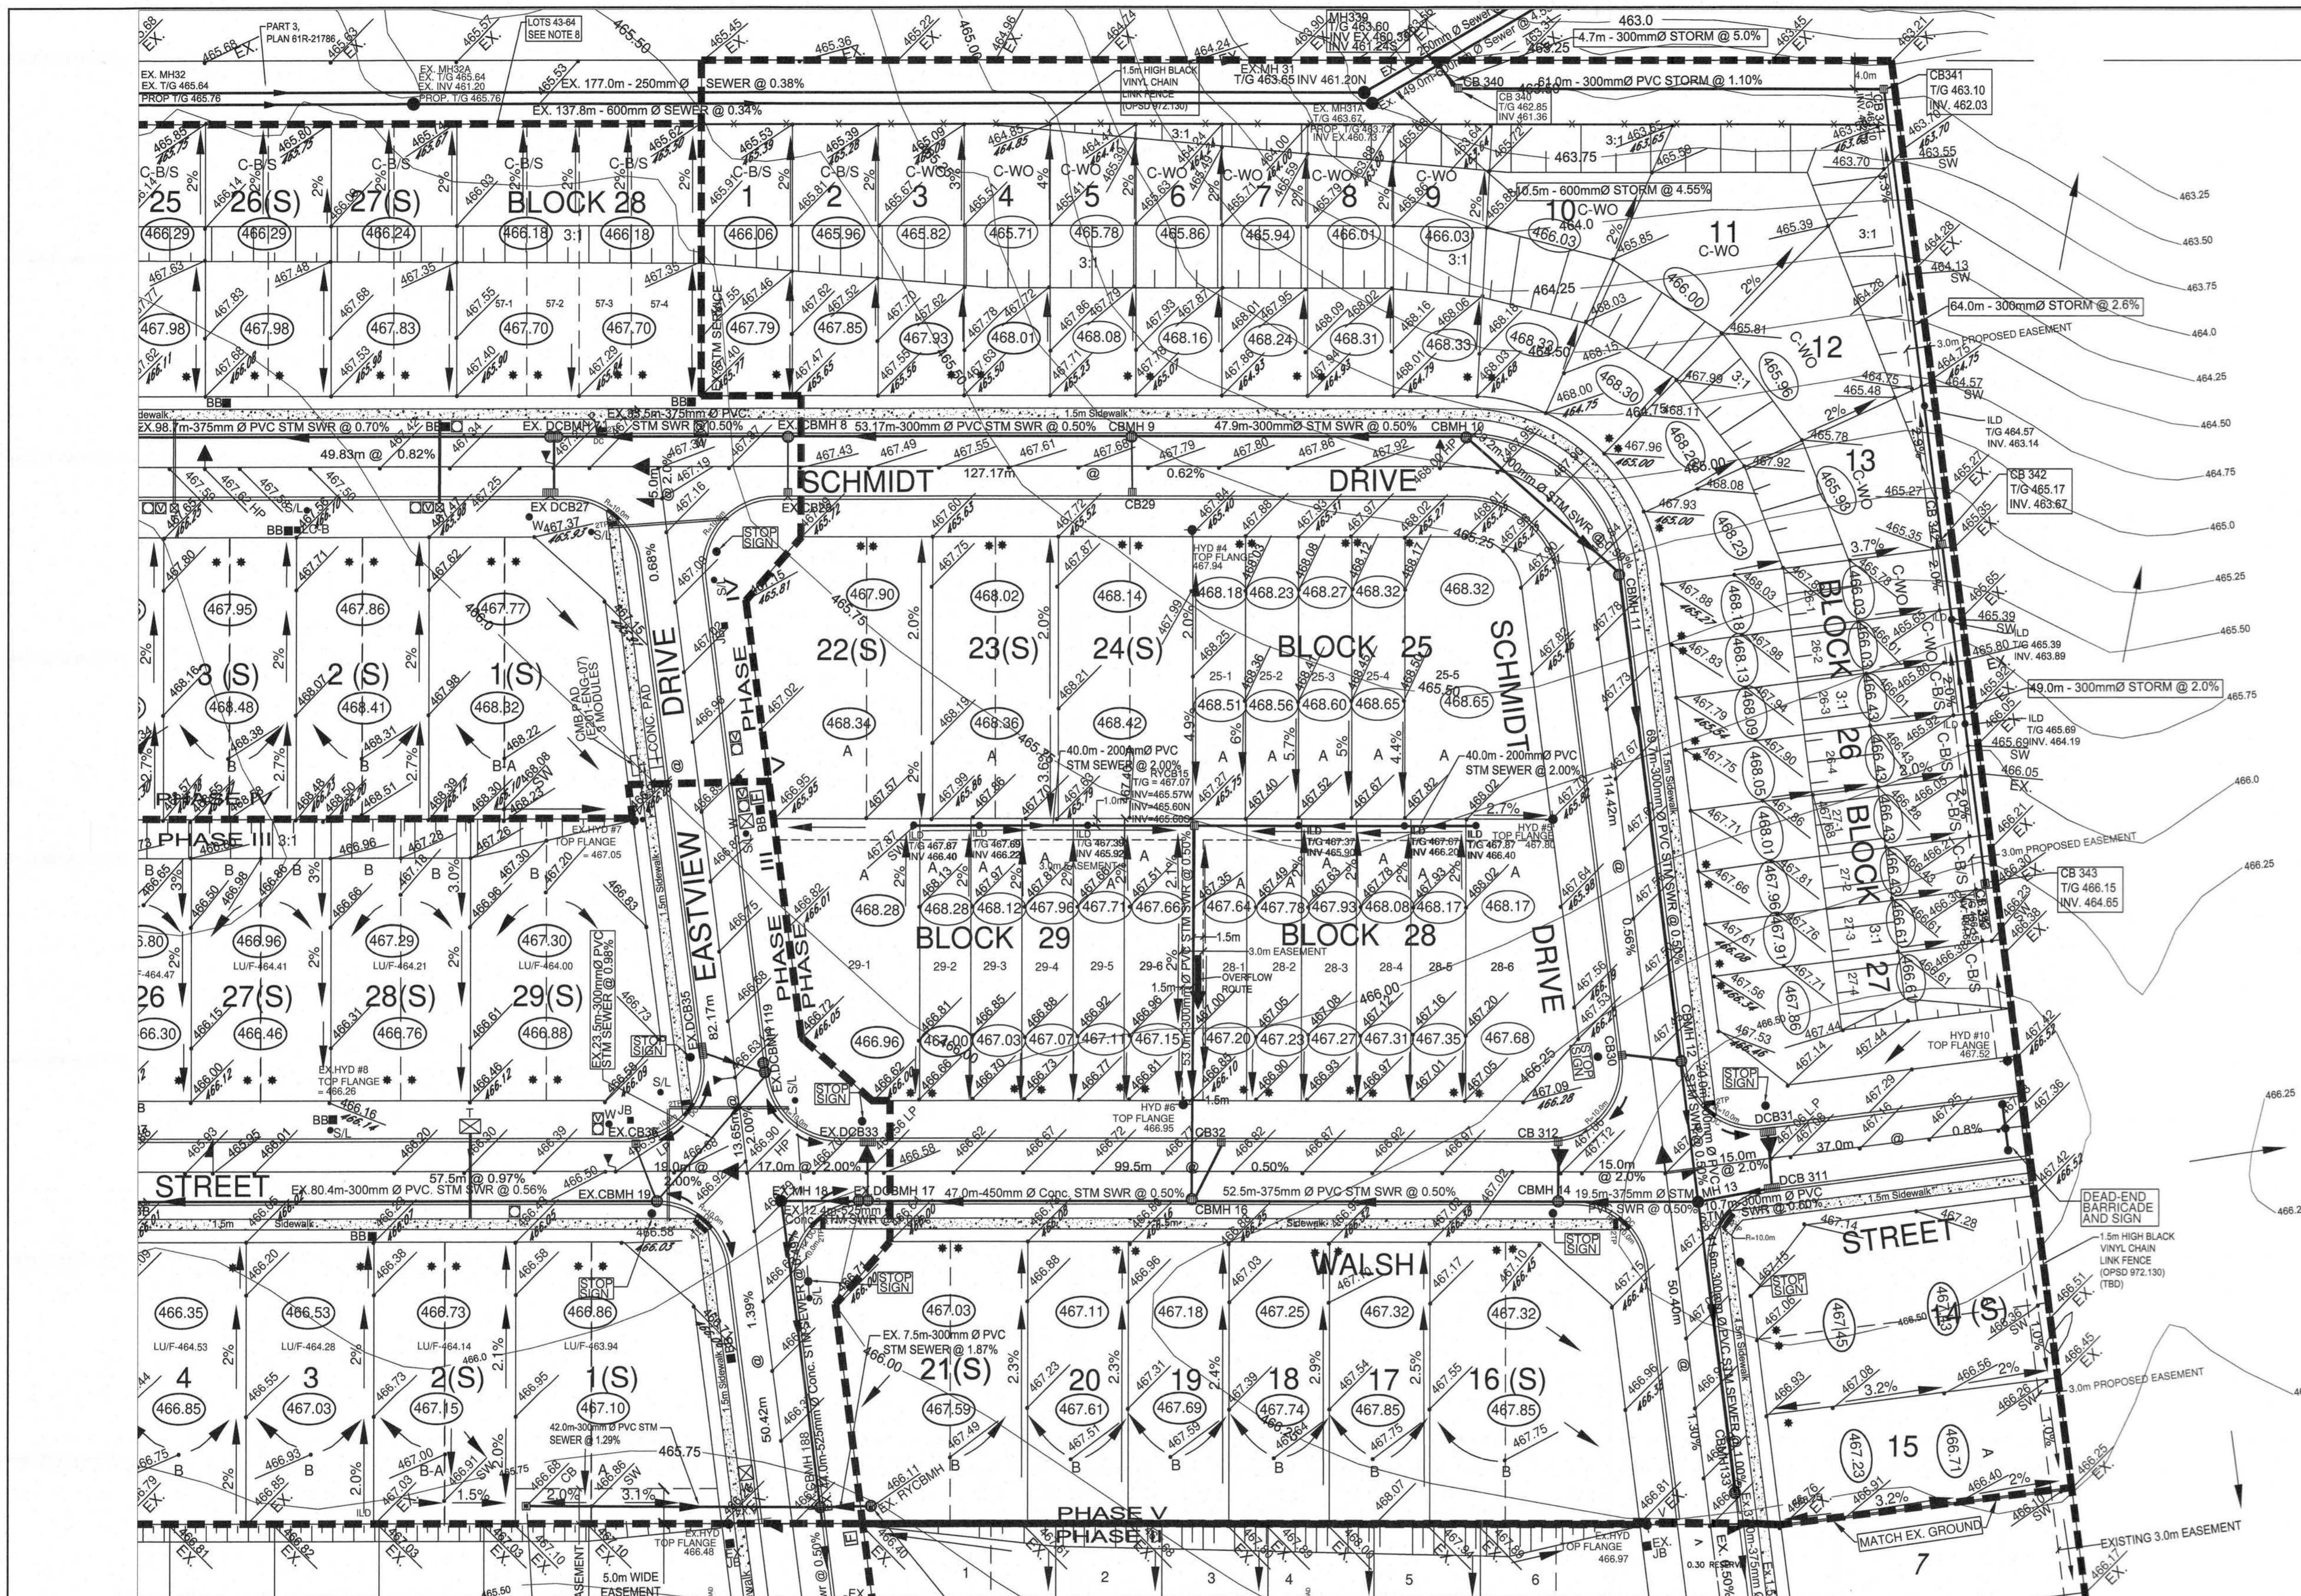


BENCH MARKS:
 1. TOP OF STORM MANHOLE IN BOULEVARD AT SOUTHWEST CORNER OF ELIZA STREET AND GORDON STREET ELEV. 462.00
 2. TOP OF SANITARY MANHOLE IN OUL-DE-SAC ON FAREL STREET, ELEV. 462.31
 3. TOP OF SANITARY MANHOLE AT EXISTING EAST LIMIT OF EASTVIEW AVENUE, ELEV. 464.27

- LEGEND:**
- 464.50 — EXISTING CONTOURS
 - 466.30 — PROPOSED ELEVATIONS
 - 467.98 — EXISTING ELEVATIONS
 - DRAINAGE DIRECTION
 - DROP CURB
 - LD — IN-LINE DRAIN
 - DRIVEWAY LOCATION
 - TACTILE PLATES
 - LOWEST UNDERSIDE FOOTING (DUE TO SHALLOW SANITARY SERVICE)
 - PROPOSED GROUND ELEVATION @ FRONT AND REAR OF BUILDING
 - TRANSFORMER
 - CABLE TV VAULT
 - CABLE TV PEDESTAL
 - STREET LIGHT
 - JIB
 - LIGHTING PEDESTAL
 - FIBRE OPTICS VAULT
 - BELL BOXES
 - WIGHTMAN VAULTS & GP'S

- NOTES**
- 1) ALL DRAINAGE TO BE DIRECTED TO SIDE AND REAR LOT SWALES
 - 2) DESIRABLE SWALE DEPTH = 230mm
MINIMUM SWALE DEPTH = 150mm
MAXIMUM SWALE DEPTH = 1000mm
 - 3) MAXIMUM DRIVEWAY GRADIENT = 8%
MAXIMUM SIDE SLOPE 3:1
 - 4) ALL REAR YARD CATCHBASINS TO BE INSTALLED WITH FRAME & GRATE (OPSD 400.110)
 - 5) DRIVEWAYS TO BE LOCATED NO CLOSER THAN 1.5M FROM HYDRANTS, STREET LIGHTS AND TRANSFORMERS
 - 6) ALL ROOF WATER TO DISCHARGE TO GROUND SURFACE.
 - 7) CHAIN LINK FENCE TO BE PER OPSD 972.130 AND OPSD 772. NO GATES IN FENCE ARE PERMITTED. FENCE TO BE LOCATED 0.10m ON TOWNSHIP PROPERTY. POST AND WIRE FENCE TO BE PER OPSD 971.101. NO GATES IN FENCE ARE PERMITTED. FENCE TO BE LOCATED 0.10m ON TOWNSHIP PROPERTY.
 - 8) LOTS 43-64 INCLUSIVE: REAR YARD AREAS TO BE GRADED TO PROMOTE SHEET FLOW ONTO ADJACENT PROPERTY TO THE EAST OF THE SITE. MAXIMIZE FRONT YARD AND ROOFTOP DRAINAGE TO THE INTERNAL STREET.
 - 9) FRONT & REAR BUILDING ELEVATIONS TO BE ADJUSTED AT BUILDING PERMIT ACCORDING TO THE BUILDING LOCATION ON THE SITE

No.	DESCRIPTION	DATE	INTL.
20	LOT NUMBERING CHANGED FOR PHASE IV	20/12/21	KJB
19	REAR LOTS 16-21 CHANGED	06/06/21	KJB
18	STORM SEWER BLOCKS 30 & 31 CHANGED	06/06/21	KJB
17	GENERAL REVISIONS	15/02/21	KJB
16	GENERAL REVISIONS	28/12/20	KJB
15	GENERAL REVISIONS	16/12/20	KJB
14	GENERAL REVISIONS	22/06/20	KJB
13	GENERAL REVISIONS	15/03/20	KJB
12	GENERAL REVISIONS	22/06/20	KJB
11	GENERAL REVISIONS	15/03/20	KJB
10	GENERAL REVISIONS	09/05/19	KJB
9	GENERAL REVISIONS	13/03/19	KJB
8	EX. LOT CORNER ELEVATIONS ADDED	21/11/18	KJB
7	GENERAL REVISIONS	25/06/18	KJB
6	GENERAL REVISIONS	22/02/18	KJB
5	GENERAL REVISIONS	01/30/18	KJB
4	GENERAL REVISIONS	02/11/17	KJB
3	GENERAL REVISIONS	14/02/17	KJB
2	GENERAL REVISIONS	30/09/16	KJB
1	REAR YARD SWALE & STORM SEWER ADDED ON LOTS 73-78	23/08/16	KJB

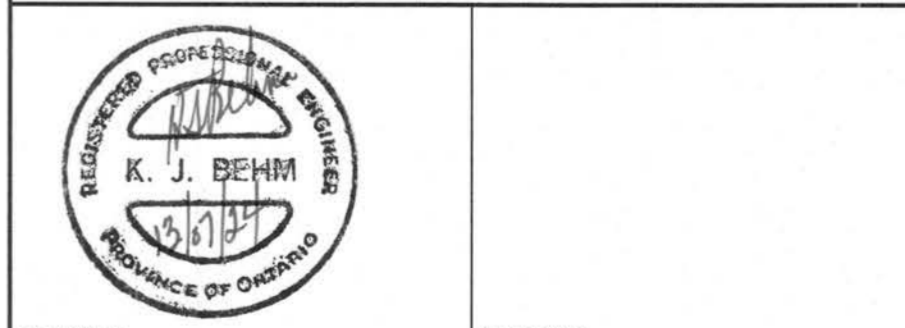



CHECKED: _____ APPROVED: _____
K. J. BEHM AND ASSOCIATES INC.
 CONSULTING ENGINEERS
 55 ERB STREET EAST, SUITE 101
 WATERLOO, ONTARIO N2J 4K8
 PHONE (519) 742-3510 FAX (519) 742-3462

**EASTRIDGE LANDING
 SUBDIVISION PHASE III, IV, V
 ARTHUR, ONTARIO**

**LOT GRADING
 CONTROL PLAN**

DRAWN	WDH	SCALE	1 : 500	DWG. No.
DESIGN	KJB	DATE	APRIL, 2016	GCP-2
CHECKED	KJB	PROJECT No.	070119	

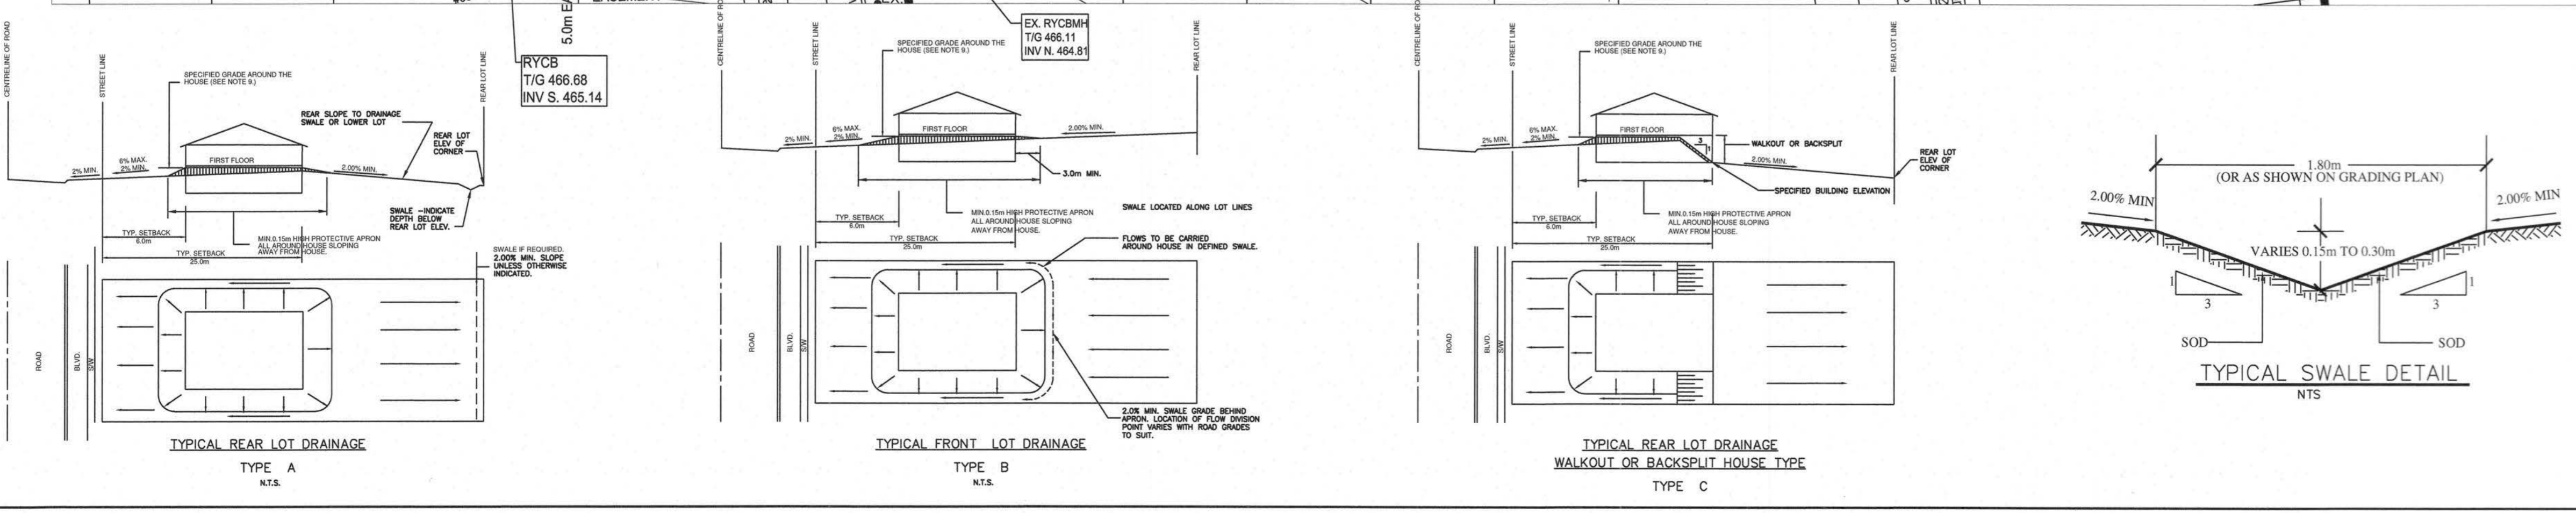

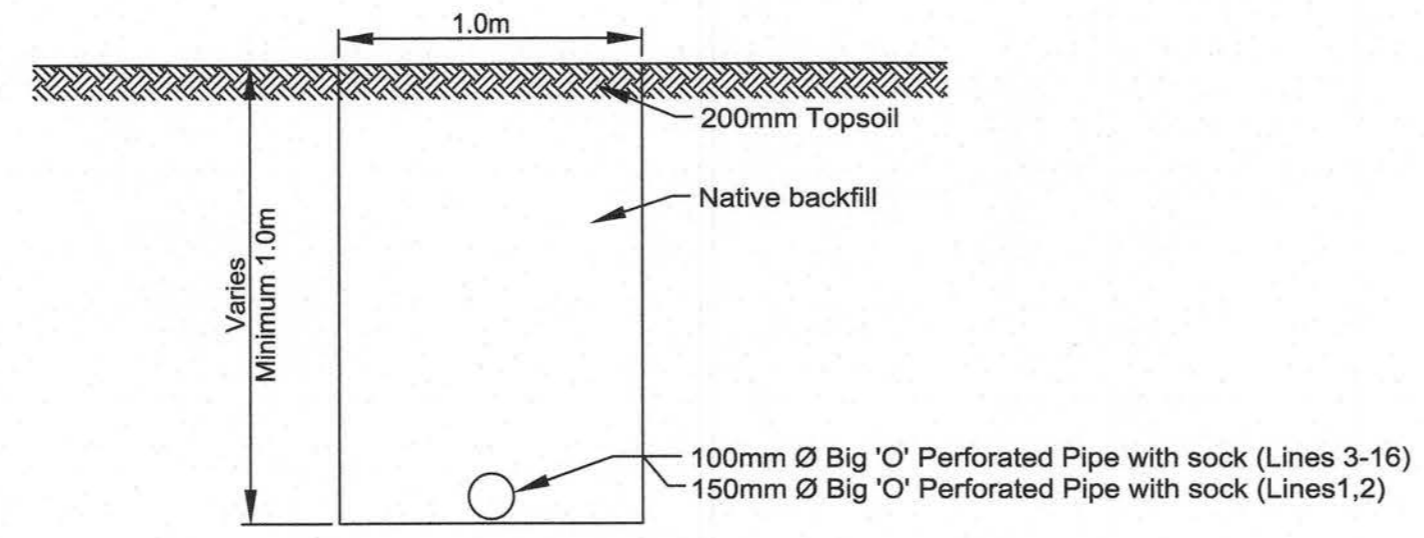

DRAINAGE TILE DETAIL
LINES 1-16
NTS


EXISTING SEWAGE LAGOON (CELL No. 1)

PARK NOTES

- THIS GRADING PLAN SHALL BE UPDATED FOLLOWING THE DESIGN OF THE FINAL PARK DEVELOPMENT PLAN, BY THE TOWNSHIP.
- BOULEVARD TREES ALONG THE FRONTAGE OF THE PARK TO BE DETERMINED FOLLOWING THE DESIGN OF THE FINAL PARK DEVELOPMENT PLAN.
- UNDERGROUND SERVICES (SEWER, WATER) FOR THE PARK TO BE DETERMINED FOLLOWING THE DESIGN OF THE FINAL PARK DEVELOPMENT PLAN.
- CHAIN LINK FENCE SHALL BE PER OPSD 972.130 WITH:
 - TERMINAL POSTS - 3 1/2", .120 WALL HDG WITH POST CAP.
 - LINE POSTS - 1 7/8", .100 WALL HDG
 - TOP RAIL - 1 1/16", .100 WALL HDG
 - MESH - 2" DIAMOND, 9 GAUGE HDG
 - END SECTIONS TO BE BRACED ON A DIAGONAL - 1 5/8" OD HDG
 - MAXIMUM POST SPACING - 3.0m
 - BOTTOM WIRE TO BE SINGLE STRAND TENSION WIRE FASTENED TO MESH OF 500mm O.C. AND 40mm-75mm FROM GROUND SURFACE.
 - NO GATES ARE PERMITTED IN CHAIN LINK FENCE.


5) POST & WIRE FENCE

- 8" x 8" CEDAR ANCHOR POSTS TO BE SPACED @ 20.0m MAXIMUM INTERVALS ANCHORED 1.2m INTO GROUND.
- STEEL LINE POSTS TO BE SPACED @ 5.0m MAXIMUM INTERVALS BETWEEN CEDAR POSTS ANCHORED 1.2m INTO GROUND (3 STEEL LINE POSTS MAXIMUM)
- TOP OF POSTS TO BE 100mm ABOVE TOP FENCE WIRE.
- FENCE WIRES SHALL BE SPACED 150mm VERTICALLY APART EXCEPT TOP 3 WIRES @ 190mm VERTICALLY AND BOTTOM 3 WIRES @ 125mm VERTICALLY
- BOTTOM WIRE TO BE 120mm ABOVE GROUND SURFACE.

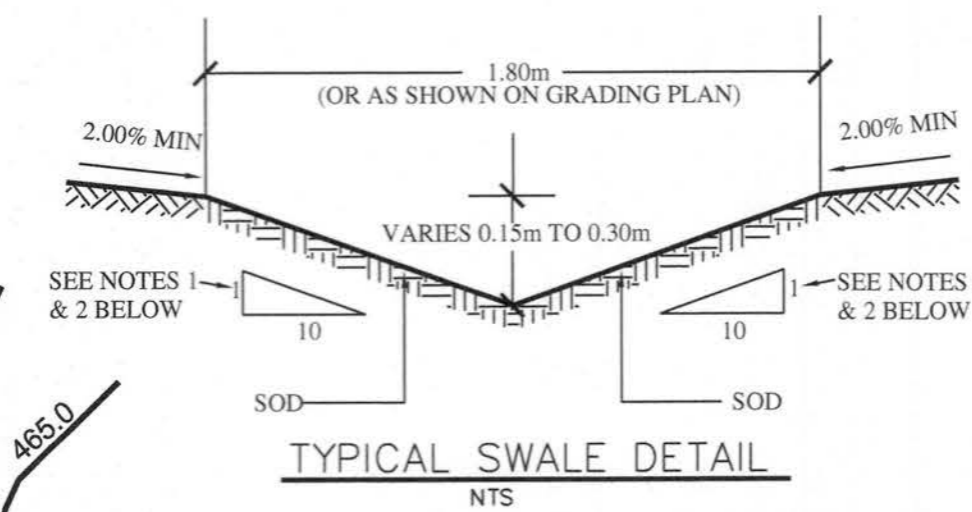

TYPICAL SWALE DETAIL
NTS

NOTES
1) SIDE SLOPES ON SWALE ALONG SOUTH SIDE OF PARK TO BE 10:1.
2) SIDE SLOPES ON SWALE ALONG WEST AND NORTH SIDE OF PARK TO BE 3:1.

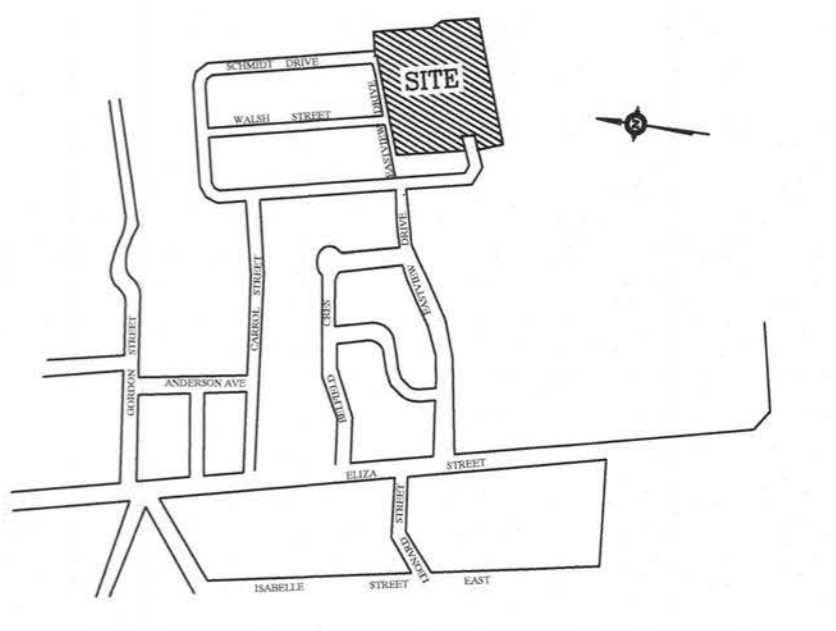

BENCH MARKS:

- TOP OF STORM MANHOLE IN BOULEVARD AT SOUTHWEST CORNER OF ELIZA STREET AND GORDON STREET ELEV 462.29
- TOP OF SANITARY MANHOLE IN COL-DE-SAC ON FARREL STREET. ELEV 462.31
- TOP OF SANITARY MANHOLE AT EXISTING EAST LIMIT OF EASTVIEW AVENUE. ELEV 464.27


LEGEND:

- 464.50 EXISTING CONTOURS
- PROPOSED ELEVATIONS
- 463.00 EXISTING ELEVATIONS
- DRAINAGE DIRECTION
- DC DROP CURB
- ILD IN-LINE DRAIN
- DRIVEWAY LOCATION
- TP TACTILE PLATES
- LOWEST UNDERSIDE FOOTING (DUE TO SHALLOW SANITARY SERVICE)
- PROPOSED GROUND ELEVATION @ FRONT AND REAR OF BUILDINGS
- TRANSFORMER
- CABLE TV VAULT
- CABLE TV PEDESTAL
- STREETLIGHT
- JUNCTION BOX
- LC-A LIGHTING PEDESTAL
- FIBRE OPTICS VAULT
- BELL BOXES
- WIGHTMAN VAULTS & GP'S

NOTES

- ALL DRAINAGE TO BE DIRECTED TO SIDE AND REAR LOT SWALES
- DESIRABLE SWALE DEPTH = 230mm
MINIMUM SWALE DEPTH = 150mm
MAXIMUM SWALE DEPTH = 1000mm
- MAXIMUM DRIVEWAY GRADIENT = 6%
- MAXIMUM SIDE SLOPE 3:1
- ALL REAR YARD GATEBASINS TO BE INSTALLED WITH FRAME & GRATE (OPSD 400.110)
- DRIVEWAYS TO BE LOCATED NO CLOSER THAN 1.5M FROM HYDRANTS, STREET LIGHTS AND TRANSFORMERS.
- ALL ROOF WATER TO DISCHARGE TO GROUND SURFACE.
- CHAIN LINK FENCE TO BE PER OPSD 972.130 AND OPS 772. NO GATES IN FENCE ARE PERMITTED. FENCE TO BE LOCATED 0.10m ON TOWNSHIP PROPERTY.
- POST AND WIRE FENCE TO BE PER OPSD 971.101. NO GATES IN FENCE ARE PERMITTED. FENCE TO BE LOCATED 0.10m ON TOWNSHIP PROPERTY.
- LOTS 43-64 INCLUSIVE: REAR YARD AREAS TO BE GRADED TO PROMOTE SHEET FLOW ONTO ADJACENT PROPERTY TO THE EAST OF THE SITE. MAXIMIZE FRONT YARD AND ROOFTOP DRAINAGE TO THE INTERNAL STREET
- FRONT & REAR BUILDING ELEVATIONS TO BE ADJUSTED AT BUILDING PERMIT ACCORDING TO THE BUILDING LOCATION ON THE SITE

No.	DESCRIPTION	DATE	INTL.
20	LOT NUMBERING CHANGED FOR PHASE IV	20/12/21	KJB
19	REAR LOTS 16-21 CHANGED	06/06/21	KJB
18	STORM SEWER BLOCKS 30 & 31 CHANGED	06/06/21	KJB
17	GENERAL REVISIONS	15/02/21	KJB
16	GENERAL REVISIONS	28/12/20	KJB
15	GENERAL REVISIONS	16/12/20	KJB
14	GENERAL REVISIONS	22/06/20	KJB
13	GENERAL REVISIONS	15/03/20	KJB
12	GENERAL REVISIONS	22/06/20	KJB
11	GENERAL REVISIONS	15/03/20	KJB
10	GENERAL REVISIONS	09/05/19	KJB
9	GENERAL REVISIONS	13/03/19	KJB
8	EX. LOT CORNER ELEVATIONS ADDED	21/11/18	KJB
7	GENERAL REVISIONS	25/05/18	KJB
6	GENERAL REVISIONS	22/02/18	KJB
5	GENERAL REVISIONS	01/30/18	KJB
4	GENERAL REVISIONS	02/11/17	KJB
3	GENERAL REVISIONS	14/02/17	KJB
2	GENERAL REVISIONS	30/05/16	KJB
1	REAR YARD SWALE & STORM SEWER ADDED ON LOTS 73-78	23/08/16	KJB

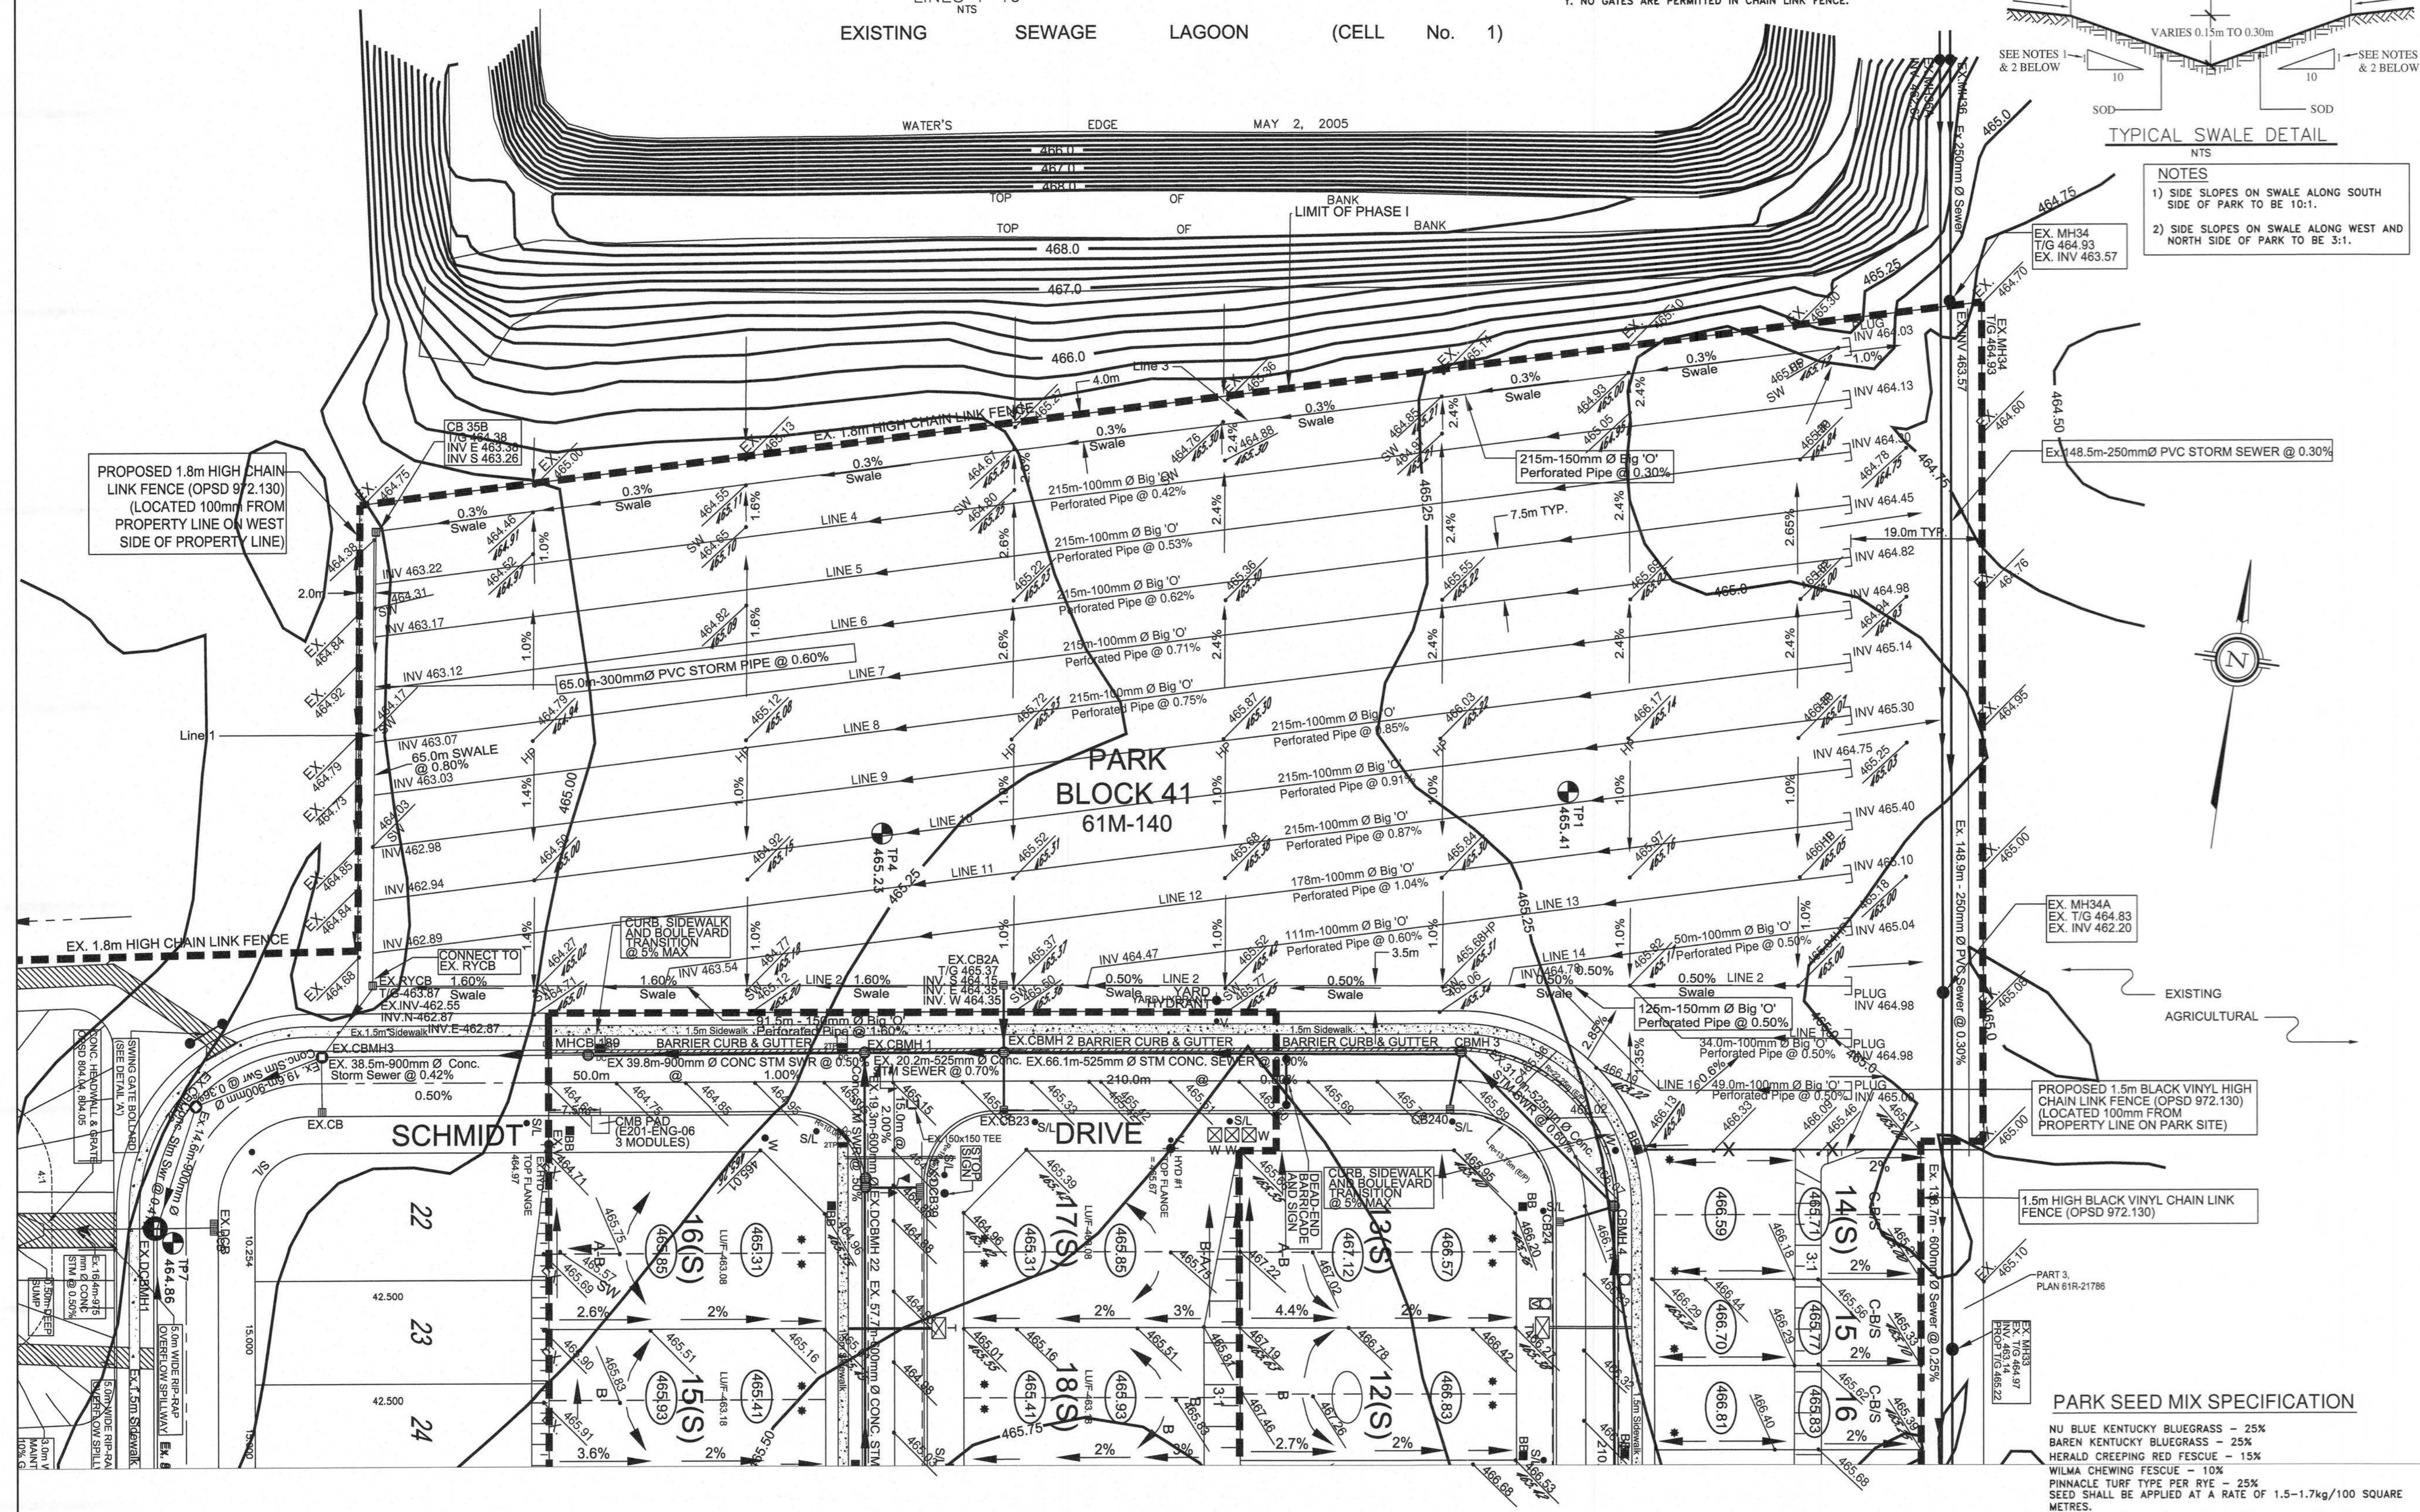

PARK SEED MIX SPECIFICATION

NU BLUE KENTUCKY BLUEGRASS - 25%
 BAREN KENTUCKY BLUEGRASS - 25%
 HERALD CREEPING RED FESCUE - 15%
 WILMA CHEWING FESCUE - 10%
 PINNACLE TURF TYPE PER RYE - 25%
 SEED SHALL BE APPLIED AT A RATE OF 1.5-1.7kg/100 SQUARE METRES.
 ALL TOPSOIL SHALL BE IN CONFORMANCE WITH OPSS802.

REGULATED PROFESSIONAL ENGINEER
 K. J. BEHM
 PROFESSIONAL ENGINEER


CHECKED: [Signature] APPROVED: [Signature]

K. J. BEHM AND ASSOCIATES INC.
 CONSULTING ENGINEERS
 55 ERB STREET EAST, SUITE 101
 WATERLOO, ONTARIO N2J 4K8
 PHONE (519) 742-3510 FAX (519) 742-3462

EASTRIDGE LANDING
 SUBDIVISION PHASE III, IV, V
 ARTHUR, ONTARIO

LOT GRADING CONTROL PLAN
 PARK

DRAWN	WDH	SCALE	1 : 500	DWG. No.
DESIGN	KJB			GCP-3A
CHECKED	KJB	DATE	FEB 2013	
PROJECT No.	070119			

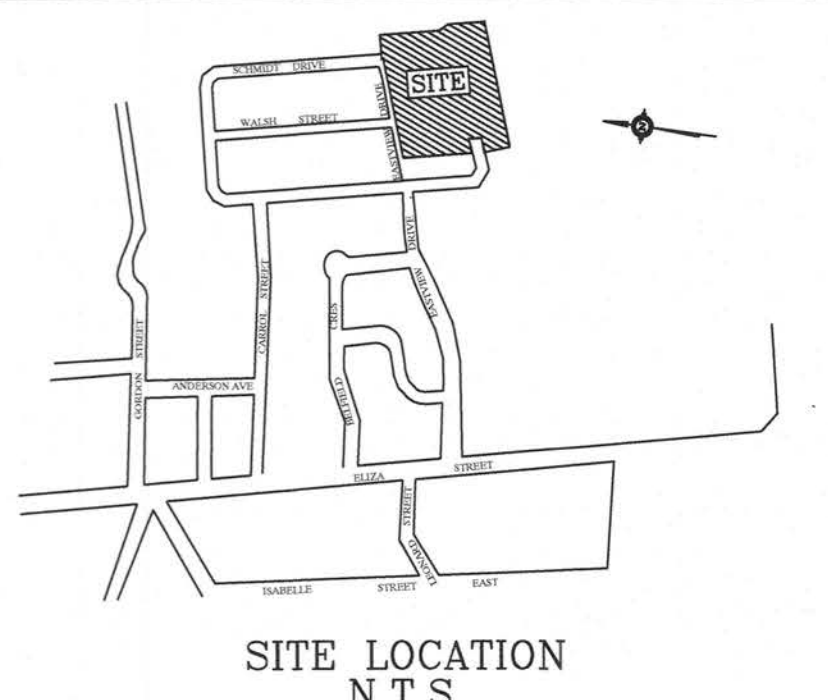

- BENCH MARKS:**
- TOP OF STORM MANHOLE IN BOULEVARD AT SOUTHWEST CORNER OF ELIZA STREET AND GORDON STREET ELEV 482.03
 - TOP OF SANITARY MANHOLE IN CUL-DE-SAC ON FARREL STREET. ELEV 482.27
 - TOP OF SANITARY MANHOLE AT EXISTING EAST LIMIT OF EASTVIEW AVENUE. ELEV 484.27

- NOTES:**
- 150mm Watermain shall be C900 PVC Class 150 (DR18) @ 1.373 with Ring-Tite joints and 12 gauge 7 strand copper with plastic coating and shall be connected to the storm pump connection. Watermain and services shall be installed minimum 2.0 m below finished grade above the main or service.
 - Watermain fittings - Ductile Iron, mechanical joint, LAWMA C110 approved, pressure rating 1000 kPa. -PVC bends and tees to be used with mechanical joint restraints per Township standards.
 - Watermain valves shall be Mueller Wedge Gate Valve per AWWA C-550, Mechanical joint. Valve extensions to be provided where required.
 - Watermain Valve Boxes shall be HD300, 3 plate No.8 round base screw type as manufactured by GIBBY'S CRUX FOUNDRIES INC., Cambridge, Ontario.
 - Hydrants shall be Conoco Valve Century Type Compression with "Storz" pump connection. All hydrants to be painted red with black "Storz" cap.
 - Water services to be 25mm single pex pipe.
 - Anodes: DZP-24, 10.9 kg shall be installed on all connections to existing iron watermain. DZP-12, 5.4 kg shall be installed on all iron fittings, valves, main stops, curb stops, etc.
 - Main stops, curb stops, unions, service boxes and restraints shall be in accordance with the Township of Wellington North Specifications.
 - Sanitary sewer shall be 200mm PVC-SDR35 meeting the current ASTM D3034 Specifications and CSA-B182.2.
 - Sanitary Services shall be 125mm PVC-SDR28 meeting the current CSA-B182.2 Specifications. Service connections to be at a minimum grade of 2% All connections to new mains shall have manufactured tees. All new connections to existing mains shall use stainless steel straps and sockets or Kor-N-Tee.
 - Sanitary sewer mainline fittings shall be PVC-SDR35 meeting the current ASTM D3034-13 Specifications and CSA B182.4.
 - Storm sewers 375mm and less shall be either Concrete (reinforced) or PVC Ultra-Rib, as per CSA-B182.4. Storm sewers greater than 375mm shall be concrete (reinforced).
 - All storm services shall be 100mm PVC-SDR28 and connected to mainline with prefabricated tee or "Kor-N-Tee", minimum 1% gradient.
 - All catchbasin heads (200mm Single, 300mm Double) shall be PVC-SDR35. Sidelway leads to rear yard catchbasins to be PVC SDR 35.
 - All sewer pipes and watermain to be installed in Class "B" bedding per OPSD 802.01 and 802.03.
 - Pavement design for all roads shall be: 450mm Granular "B" road base 150mm Granular "A" road base 50mm H-4 Binder Course Asphalt 50mm H-3 Surface Course Asphalt 600mm TOTAL DEPTH
 - Concrete Curbs and sidewalks shall be poured using 30Mpa strength @ 28 days. All watermain and sewers to be tested in accordance with Township of Wellington North Specifications or as noted in the Contract Documents.
 - Concrete Curbs to be mountable as per OPSD 600.10
 - Water Service Boxes to be located at streetline and not in driveways, if possible.
 - Sump Pumps to discharge to storm services.
 - Driveways shall be: 450mm Granular "B" 150mm Granular "A" 50mm H-3C Modified Fine Asphalt
 - All structures shall allow for an adjustment of between 100mm-200mm with modulus. All external joints shall be wrapped with 150mm Densotop or equivalent Control Fabric.
 - Road Section to be in accordance with Township Standard Drawing R1 (see section Control Fabric).
 - Tactile Warning Plates shall be installed in sidewalk at curb intersections as per OPSD 300.03 and OPSD 300.03.3.
 - Sidewalk ramps at curb intersections shall be 8% maximum gradient.
 - Where storm services and water services conflict with mainline pipes, storm services to go over watermain and water services to go under storm sewer with 0.5m clearance.
 - All catchbasin manholes to have 300mm deep sump. All catchbasins to have 600mm deep sump.
 - Where storm sewer runs along curb line and has been backfilled with approved granular leads to rear yard catchbasins (to be 0.0m of 150mm granular wrapped perforated autodon required upstream of all catchbasins and catchbasin manholes and in both directions in the area of the road. Subdrains to be 80mm @ 1000 or approved equivalent to storm sewer. Subdrains to be backfilled with native soils, a continuous 150mm sump to be provided along curbside.

No.	DESCRIPTION	DATE	INTL.
16	PIPE MATERIALS ADDED	26/01/23	KJB
15	AS-CONSTRUCTED U/G SERVICES PHASE IV	06/11/22	KJB
14	DRIVEWAY CHANGED BLOCK 31	10/08/22	KJB
13	LOT NUMBERING CHANGED FOR PHASE IV	20/12/21	KJB
12	STORM SEWER REMOVED LOTS 16-21 PHASE V	06/08/21	KJB
11	STORM SEWER BLOCKS 30 & 31 CHANGED	05/08/21	KJB
10	GENERAL REVISIONS	15/02/21	KJB
9	AS-CONSTRUCTED U/G SERVICES PHASE III	28/12/20	KJB
8	GENERAL REVISIONS	22/06/20	KJB
7	GENERAL REVISIONS	15/03/20	KJB
6	GENERAL REVISIONS	19/05/19	KJB
5	GENERAL REVISIONS	07/01/19	KJB
4	GENERAL REVISIONS	30/11/18	KJB
3	GENERAL REVISIONS	22/02/18	KJB
2	GENERAL REVISIONS	14/02/17	KJB
1	GENERAL REVISIONS	23/08/16	KJB

- LEGEND:**
- S— STORM SEWER & SERVICES
 - S— SANITARY SEWER & SERVICES
 - W— WATERMAIN, SERVICES, VALVES, HYDRANTS
 - ⊠— TRANSFORMER
 - ⊞— CABLE TV VAULT
 - ⊞— CABLE TV PEDESTAL
 - S/L— STREETLIGHT
 - JB— JUNCTION BOX
 - LC-A— LIGHTING PEDESTAL
 - F— FIBRE OPTICS VAULT
 - BB— BELL BOXES
 - W— WIGHTMAN VAULTS & GP'S

Geotechnical Information (per CMT Engineering Inc., June, 2005)

TP1-Topsoil 0.25m, Sandy Silt Till 2.85m, Clayey Silt Till 1.4m
 TP2-Topsoil 0.25m, Sandy Silt Till 3.95m
 TP3-Topsoil 0.30m, Clayey Silt Till 4.30m
 TP4-Topsoil 0.25m, Sandy Silt Till 3.75m
 TP5-Topsoil 0.30m, Sandy Silt Till 4.20m
 TP6-Topsoil 0.25m, Sandy Silt Till 1.75m, Clayey Silt Till 2.80m
 TP7-Topsoil 0.25m, Sandy Silt Till 4.25m
 TP8-Topsoil 0.20m, Sandy Silt Till 4.30m
 TP9-Topsoil 0.40m, Sandy Silt Till 4.60m
 TP10-Topsoil 0.25m, Clayey Silt Till 1.35m, Sandy Silt Till 2.40m





CHECKED: APPROVED:

K. J. BEHM AND ASSOCIATES INC.
 CONSULTING ENGINEERS
 55 EPP STREET EAST, SUITE 101
 WATERLOO, ONTARIO N2J 4K8
 PHONE (519) 742 3510 FAX (519) 742 3462

EASTRIDGE LANDING
SUBDIVISION PHASE III, IV, V
 ARTHUR, ONTARIO

GENERAL
SERVICING PLAN

DRAWN	WDH	SCALE	1 : 1000	DWG. No.
DESIGN	KJB			GSP-1
CHECKED	KJB	DATE	FEB 2013	
PROJECT No.	070119			

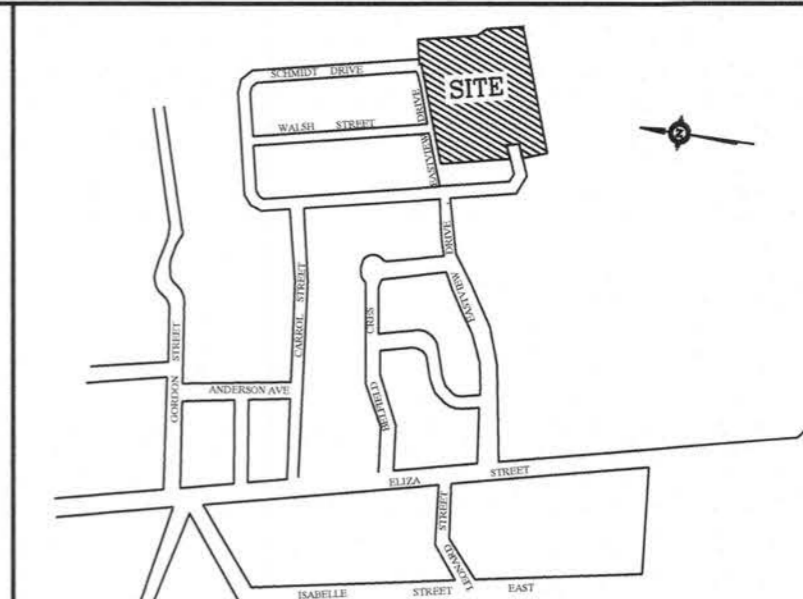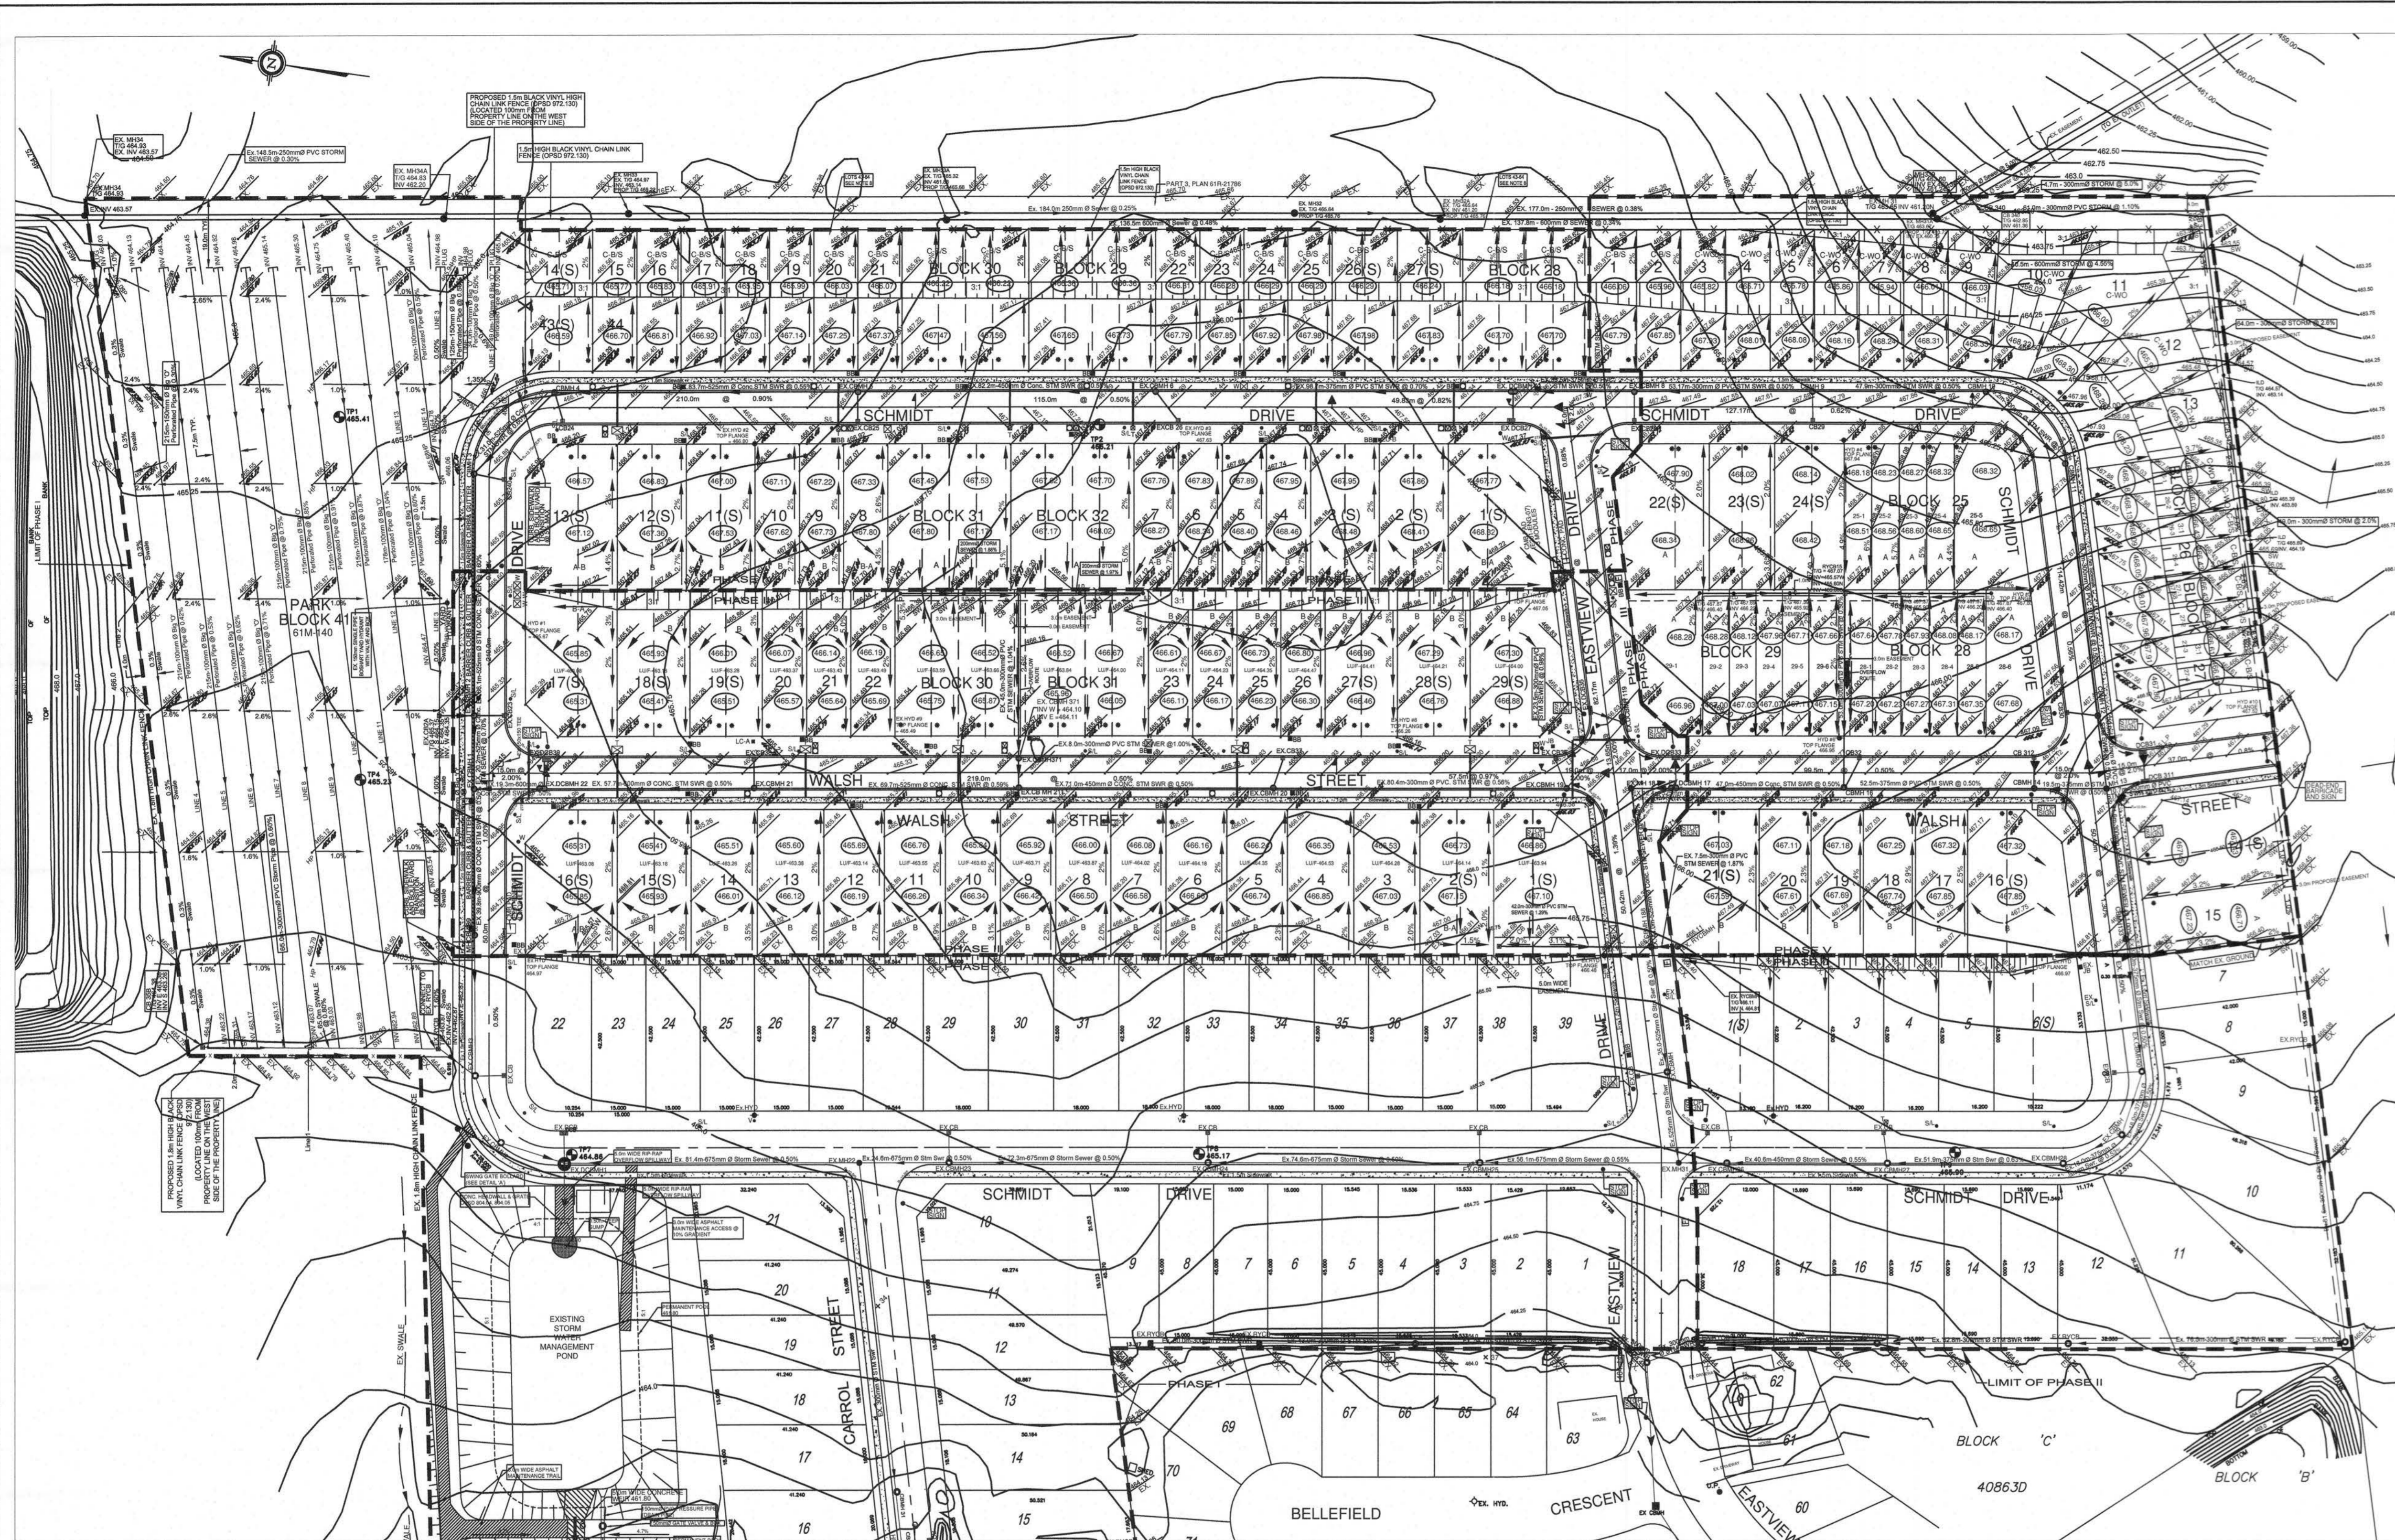

SITE LOCATION
N.T.S.

- BENCH MARKS:**
1. TOP OF STORM MANHOLE IN BOULEVARD AT SOUTHWEST CORNER OF ELIZA STREET AND GORDON STREET ELEV 462.03
 2. TOP OF SANITARY MANHOLE IN CUL-DE-SAC ON FARRIEL STREET. ELEV 462.31
 3. TOP OF SANITARY MANHOLE AT EXISTING EAST LIMIT OF EASTVIEW AVENUE. ELEV 464.27

- LEGEND:**
- 464.50 EXISTING CONTOURS
 - PROPOSED ELEVATIONS
 - EXISTING ELEVATIONS
 - DRAINAGE DIRECTION
 - DC DROP CURB
 - ILD IN-LINE DRAIN
 - DRIVEWAY LOCATION
 - TP TACTILE PLATES
 - LUF LOWEST UNDERSIDE FOOTING (DUE TO SHALLOW SANITARY SERVICE)
 - PROPOSED GROUND ELEVATION @ FRONT AND REAR OF BUILDINGS
 - 467.24
 - T TRANSFORMER
 - CABLE TV VAULT
 - CABLE TV PEDESTAL
 - STREETLIGHT
 - JB JUNCTION BOX
 - LC-A LIGHTING PEDESTAL
 - FIBRE OPTICS VAULT
 - BELL BOXES
 - WIGHTMAN VAULTS & GPS

- NOTES**
- 1) ALL DRAINAGE TO BE DIRECTED TO SIDE AND REAR LOT SWALES
 - DESIRABLE SWALE DEPTH = 230mm
 - MINIMUM SWALE DEPTH = 150mm
 - MAXIMUM SWALE DEPTH = 1000mm
 - MAXIMUM DRIVEWAY GRADIENT = 6%
 - MAXIMUM SIDE SLOPE 3:1
 - 3) ALL REAR YARD CATCHBASINS TO BE INSTALLED WITH FRAME & GRATE (OPSD 400.110)
 - DRIVEWAYS TO BE LOCATED NO CLOSER THAN 1.5M FROM HYDRANTS, STREET LIGHTS AND TRANSFORMERS.
 - 5) ALL ROOF WATER TO DISCHARGE TO GROUND SURFACE.
 - CHAIN LINK FENCE TO BE PER OPSD 972.130 AND OPSD 972. NO GATES IN FENCE ARE PERMITTED. FENCE TO BE LOCATED 0.10M ON TOWNSHIP PROPERTY. POST AND WIRE FENCE TO BE PER OPSD 971.101. NO GATES IN FENCE ARE PERMITTED. FENCE TO BE LOCATED 0.10M ON TOWNSHIP PROPERTY.
 - 8) LOTS 43-64 INCLUSIVE: REARYARD AREAS TO BE GRADED TO PROMOTE SHEET FLOW ONTO ADJACENT PROPERTY TO THE EAST OF THE SITE. MAXIMIZE FRONT YARD AND ROOFTOP DRAINAGE TO THE INTERNAL STREET.
 - 9) FRONT & REAR BUILDING ELEVATIONS TO BE ADJUSTED AT BUILDING PERMIT ACCORDING TO THE BUILDING LOCATION ON THE SITE.
- | | | | |
|----|--|----------|-----|
| 22 | AS-CONSTRUCTED PHASES 3,4 | 28/01/23 | KJB |
| 21 | DRIVEWAY CHANGED BLOCK 31 | 10/06/22 | KJB |
| 20 | LOT NUMBERING CHANGED FOR PHASE IV | 20/12/21 | KJB |
| 19 | REAR LOTS 16-21 CHANGED | 06/06/21 | KJB |
| 18 | STORM SEWER BLOCKS 30 & 31 CHANGED | 06/06/21 | KJB |
| 17 | GENERAL REVISIONS | 15/02/21 | KJB |
| 16 | GENERAL REVISIONS | 28/12/20 | KJB |
| 15 | GENERAL REVISIONS | 16/12/20 | KJB |
| 14 | GENERAL REVISIONS | 22/06/20 | KJB |
| 13 | GENERAL REVISIONS | 15/03/20 | KJB |
| 12 | GENERAL REVISIONS | 22/06/20 | KJB |
| 11 | GENERAL REVISIONS | 15/03/20 | KJB |
| 10 | GENERAL REVISIONS | 09/05/19 | KJB |
| 9 | GENERAL REVISIONS | 13/03/19 | KJB |
| 8 | EX. LOT CORNER ELEVATIONS ADDED | 21/11/18 | KJB |
| 7 | GENERAL REVISIONS | 25/06/18 | KJB |
| 6 | GENERAL REVISIONS | 22/02/18 | KJB |
| 5 | GENERAL REVISIONS | 01/30/18 | KJB |
| 4 | GENERAL REVISIONS | 02/11/17 | KJB |
| 3 | GENERAL REVISIONS | 14/02/17 | KJB |
| 2 | GENERAL REVISIONS | 30/09/16 | KJB |
| 1 | REARYARD SWALE & STORM SEWER ADDED ON LOTS 73-78 | 23/08/16 | KJB |

No.	DESCRIPTION	DATE	INTL.
REVISIONS			







CHECKED: APPROVED: _____


K. J. BEHM AND ASSOCIATES INC.
CONSULTING ENGINEERS
55 EBR STREET EAST, SUITE 220
WATERLOO, ONTARIO N2J 4K8
PHONE (519) 742 3510 FAX (519) 742 3462

EASTRIDGE LANDING
SUBDIVISION PHASE III, IV, V
ARTHUR, ONTARIO

GENERAL OVERALL LOT
GRADING CONTROL PLAN

DRAWN	WDH	SCALE	1 : 1,000	DWG. No.
DESIGN	KJB	DATE	APRIL, 2016	GCP
CHECKED	KJB	PROJECT No.		

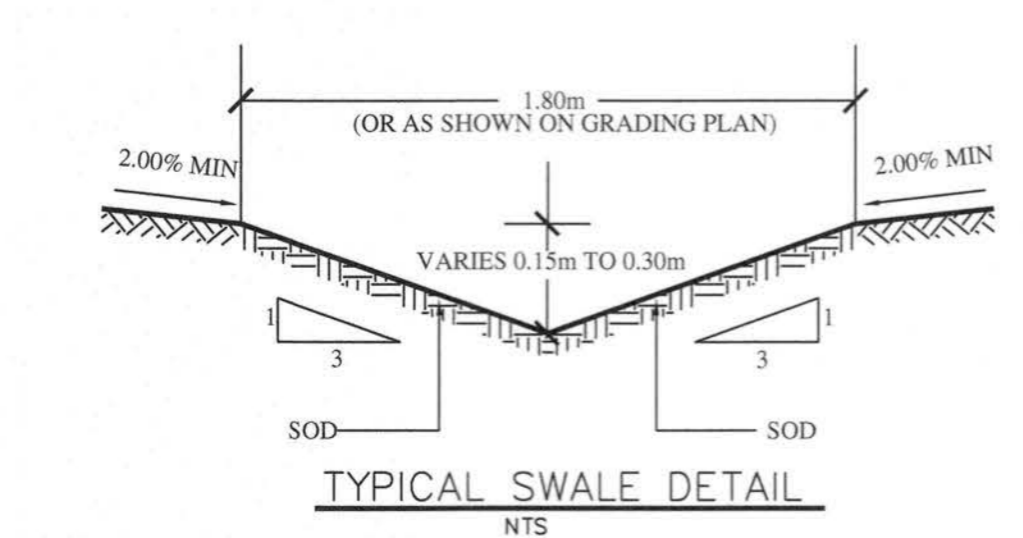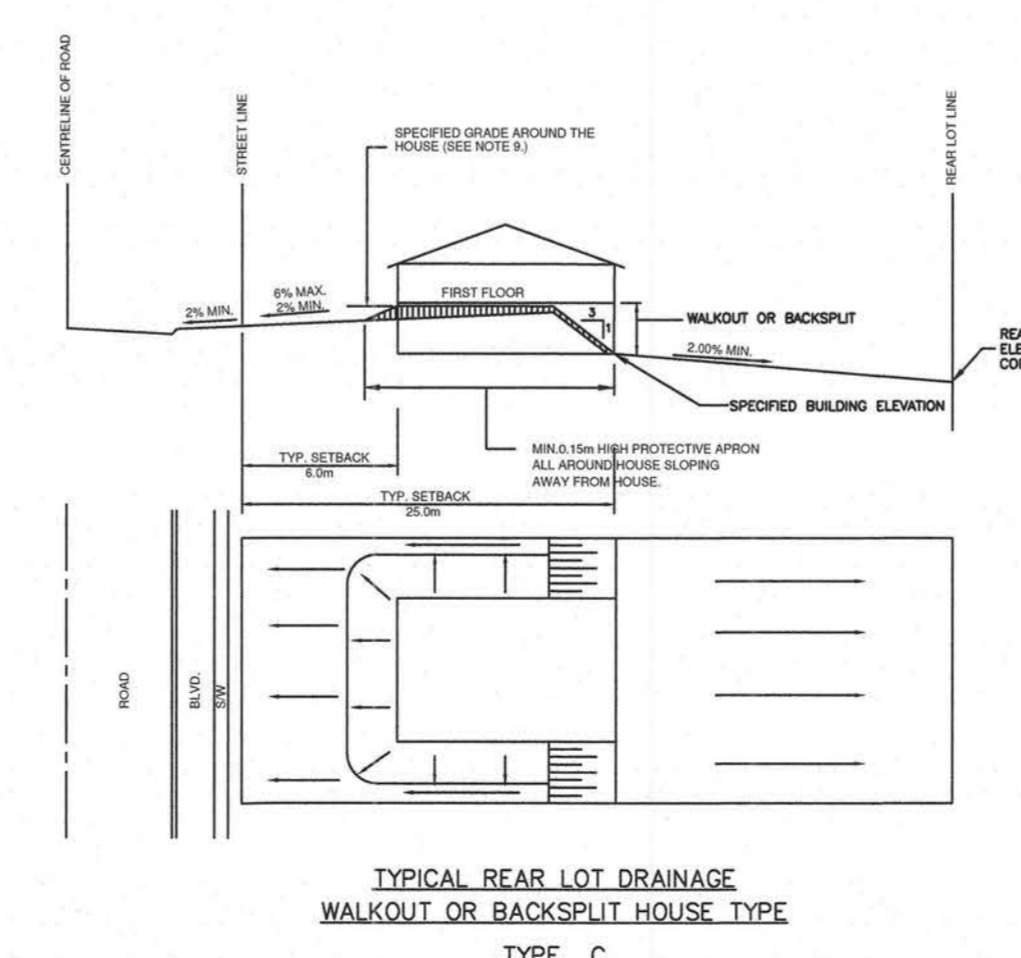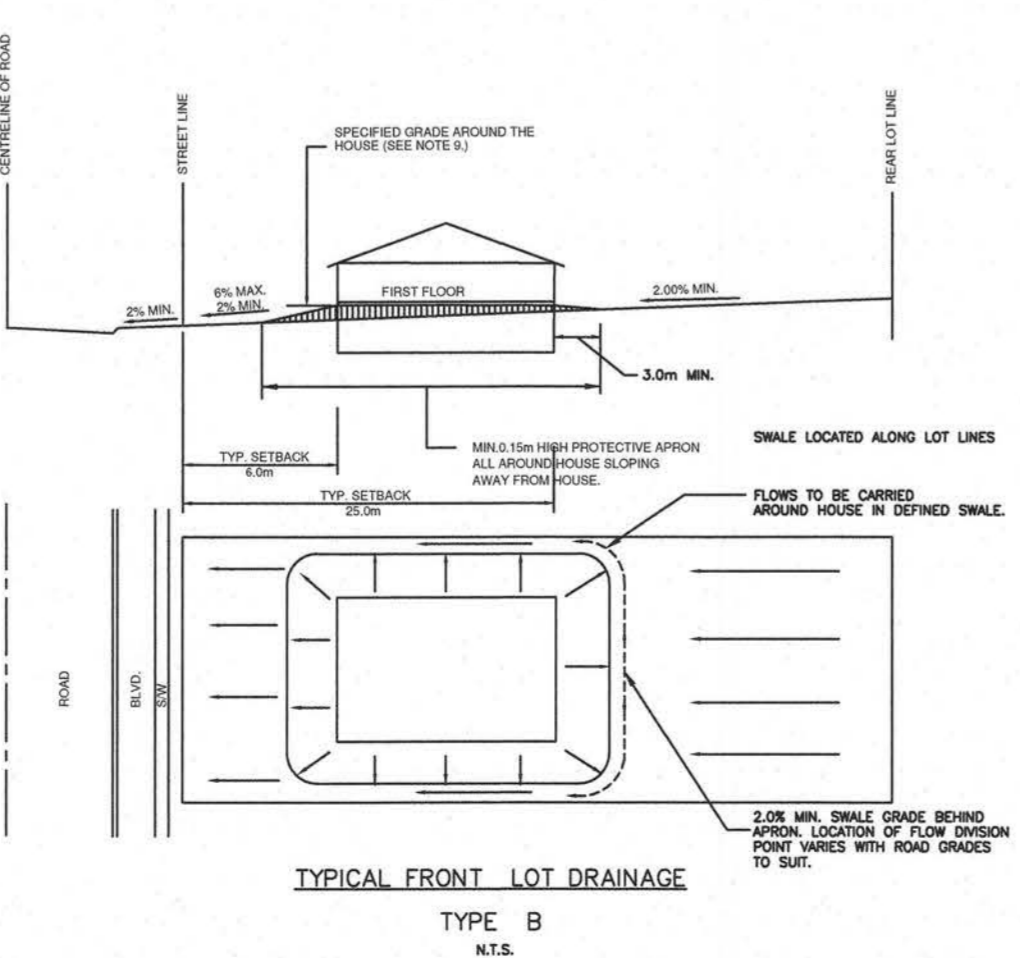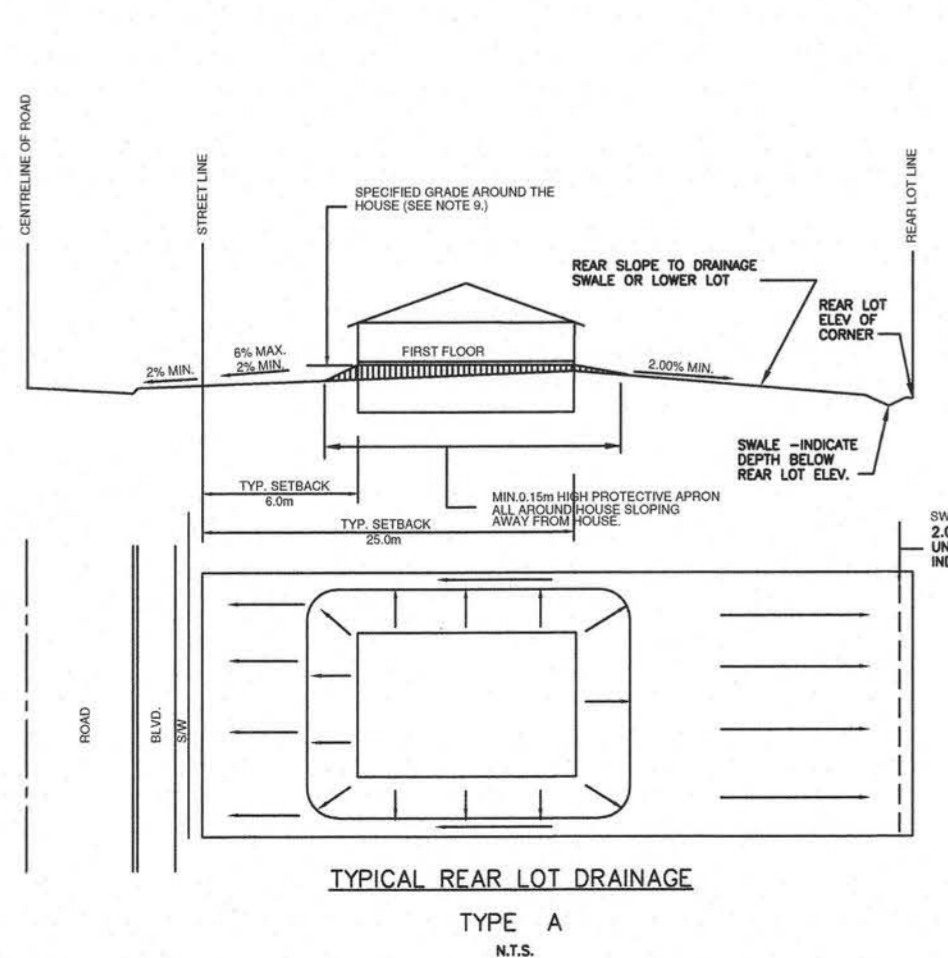


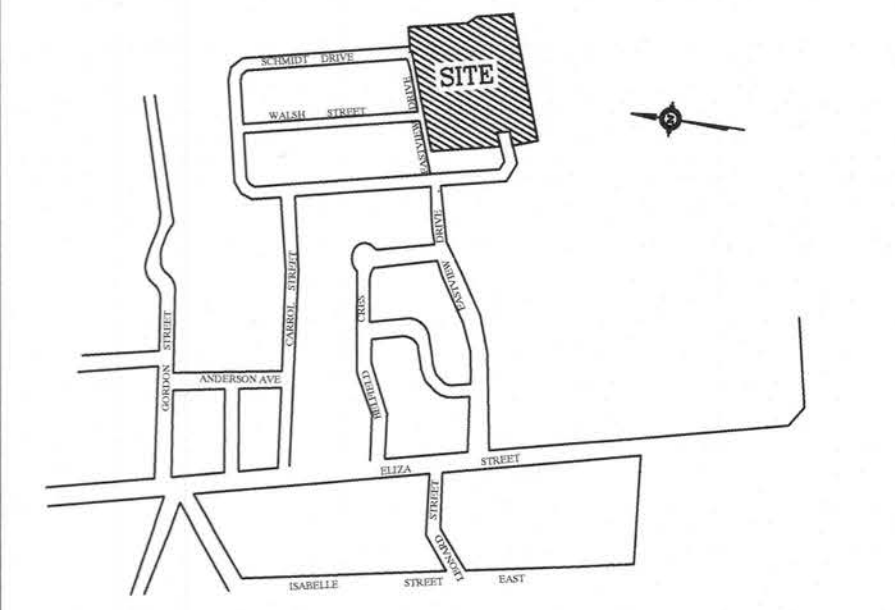


SITE LOCATION
N.T.S.

- BENCH MARKS:**
- TOP OF STORM MANHOLE IN BOULEVARD AT SOUTHWEST CORNER OF ELIZA STREET AND GORDON STREET ELEV 462.03
 - TOP OF SANITARY MANHOLE IN CUL-DE-SAC ON FARREL STREET. ELEV 462.31
 - TOP OF SANITARY MANHOLE AT EXISTING EAST LIMIT OF EASTVIEW AVENUE. ELEV 464.27

- NOTES:**
1. Storm Watermain shall be 900 PVC Class 150 (DR18), B137.3 with Ring-Tite joints and Trocar Wire. Trocar Wire shall be 12 gauge, 7 strand copper with plastic coating and shall be connected to the storm pump connection. Watermain and services shall be installed minimum 2.0 m below finished grade above the main or service in sand bedding per OPS 1001.
 2. Watermain fittings - Ductile Iron, mechanical joint, AWWA C110 approved, pressure rating 1030 kPa.
 3. Watermain valves shall be Mueller Wedge Gate Valve per AWWA C-509, Mechanical joint. Valve extensions to be provided where required.
 4. Watermain Valve Boxes shall be VB3100, 3 place No.6 round base screw type as manufactured by BSBY-ST CROCK FOUNDRIES INC. (Cambridge, Ontario). Hydrants shall be Concrete Valve Centric Type Compression with Storm pump connection. All hydrants to be painted red with black "Storm" cap.
 5. Water services to be 25mm single type pipe.
 6. Anodes: D2P-24, 10.9 kg shall be installed on all connections to existing watermain.
 7. Anodes: D2P-12, 5.4 kg shall be installed on all iron fittings, valves, main stops, curb stops, etc.
 8. Main stops, curb stops, valves, service boxes and restraints shall be in accordance with the Township of Wellington North Specifications.
 9. Sanitary sewer shall be 200mm PVC-SDR35 meeting the current ASTM D3034 Specifications and CSA-192.2.
 10. Storm services shall be 100mm PVC-SDR28 meeting the current CSA-192.2 Specifications. Service connections to be at a minimum grade of 0.2%.
 11. All connections to existing mains shall have manufacturer's label. All new connections to existing mains shall use stainless steel straps and saddles or Kor-N-Tee.
 12. Sanitary sewer manhole fittings shall be PVC-SDR35 meeting the current ASTM D3034-73 Specifications and CSA B182.4.
 13. Storm sewers 375mm and less shall be either Concrete (reinforced) or PVC U/Rig-Rib, as per CSA-B182.4. Storm sewers greater than 375mm shall be concrete (reinforced).
 14. All storm services shall be 100mm PVC-SDR28 and connected to manhole with precastable tee or "Kor-N-Tee", minimum 1% gradient.
 15. All catchbasin leads (250mm Single, 300mm Double) shall be PVC-SDR35. Sloyd lead to report catchbasin to a PVC SDR 35 with minimum 1% gradient and 1.2m of cover.
 16. All sewer pipes and watermain to be installed in Class "B" Bedding per OPS 802.01 and 802.03.
 17. Pavement design for all roads shall be:
450mm Granular "B" road base
150mm Granular "A" road base
50mm H-4 Binder Course Asphalt
40mm H-3 Surface Course Asphalt
900mm TOTAL DEPTH
 18. Concrete curbs and sidewalks shall be poured using 32Mpa strength @ 28 days.
 19. All watermain and sewers to be tested in accordance with Township Standards.
 20. Concrete curbs to be mountable as per OPS 505.10 and Barrier curbs as per OPS 600.04.
 21. Water Service Boxes to be located at streetline and not in driveways, if possible.
 22. Sump Pumps to discharge to storm services.
 23. Driveways shall be:
450mm Granular "B"
150mm Granular "A"
50mm H-3C Modified Fine Asphalt
 24. All structures shall allow for an adjustment of between 100mm-200mm with modulus. All external joints shall be wrapped with 150mm Glasscrete or equivalent.
 25. This plan shall be read in conjunction with Drawing EPC Erosion Control Plan.
 26. Road Section to be in accordance with Township Standard Drawing R1 (see section Drawing DET-1).
 27. 0.6m BB Plates shall be installed in sidewalk at curb intersections as per OPS 310.039 and OPS 310.033.
 28. Slope ranges of curb intersections shall be 8% maximum gradient.
 29. Where storm services and water services conflict with manhole pipes, storm services to go over watermain and water services to go under storm sewer with 0.5m clearance.
 30. All catchbasin manholes to have 300mm deep sump. All roadside catchbasins to have 600mm deep sump. No sumps to be installed in residential areas.
 31. Where storm sewer runs along curb line and has been backfilled with approved granular material, then Road Drains (RD) to be 0.5m of 150mm granular wrapped perforated subdrain required upstream of all catchbasins and catchbasin manholes and in both directions in the slope in the road. Subdrains to be 600mm deep.
 32. If storm sewer is backfilled with native soils, a continuous 150mm x subdrain to be provided along curbside.

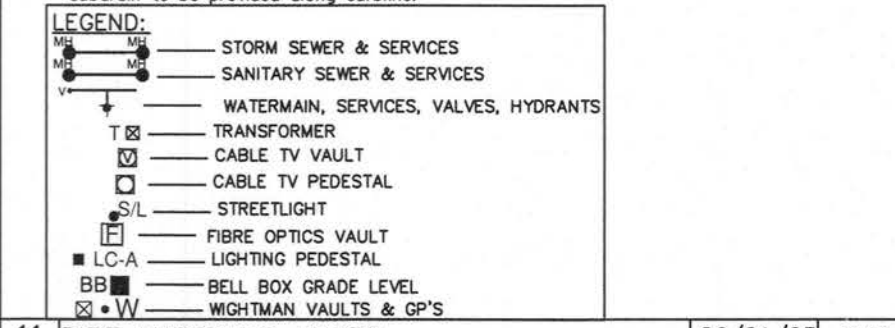

No.	DESCRIPTION	DATE	INTL.
11	PIPE MATERIALS ADDED	26/01/23	KJB
10	AS-CONSTRUCTED U/G SERVICES PHASES IV	06/11/12	KJB
9	LOT NUMBERING CHANGED FOR PHASE IV	20/12/21	KJB
8	AS-CONSTRUCTED U/G SERVICES PHASES III	28/12/20	KJB
7	GENERAL REVISIONS	22/06/20	KJB
6	GENERAL REVISIONS	15/03/20	KJB
5	GENERAL REVISIONS	19/05/19	KJB
4	GENERAL REVISIONS	07/01/19	KJB
3	GENERAL REVISIONS	30/11/18	KJB
2	GENERAL REVISIONS	22/02/18	KJB
1	GENERAL REVISIONS	02/11/17	KJB


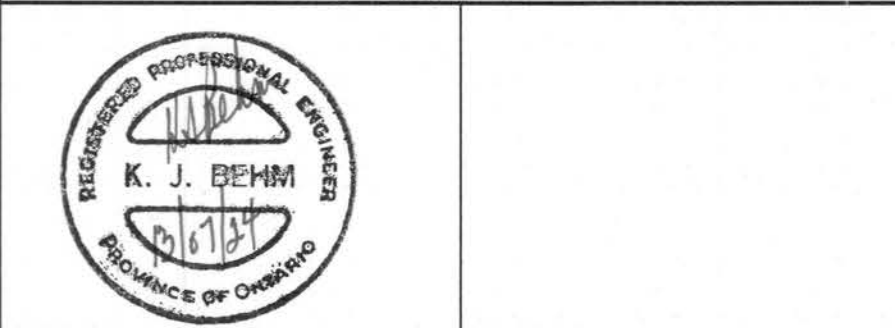


CHECKED: APPROVED:
K. J. BEHM AND ASSOCIATES INC.
CONSULTING ENGINEERS
55 ERB STREET EAST, SUITE 101
WATERLOO, ONTARIO N2J 4K8
PHONE (519) 742 3510 FAX (519) 742 3462



**EASTRIDGE LANDING
SUBDIVISION PHASE III, IV, V**
ARTHUR, ONTARIO

**PLAN AND PROFILE
SCHMIDT DRIVE
STA. 1+000 TO STA. 1+220**

DRAWN	WDH	SCALE	HOR: 1 : 500 VERT: 1 : 50	DWG. No.
DESIGN	KJB	DATE	FEB 2013	PP-1
CHECKED	KJB	PROJECT No.	070119	

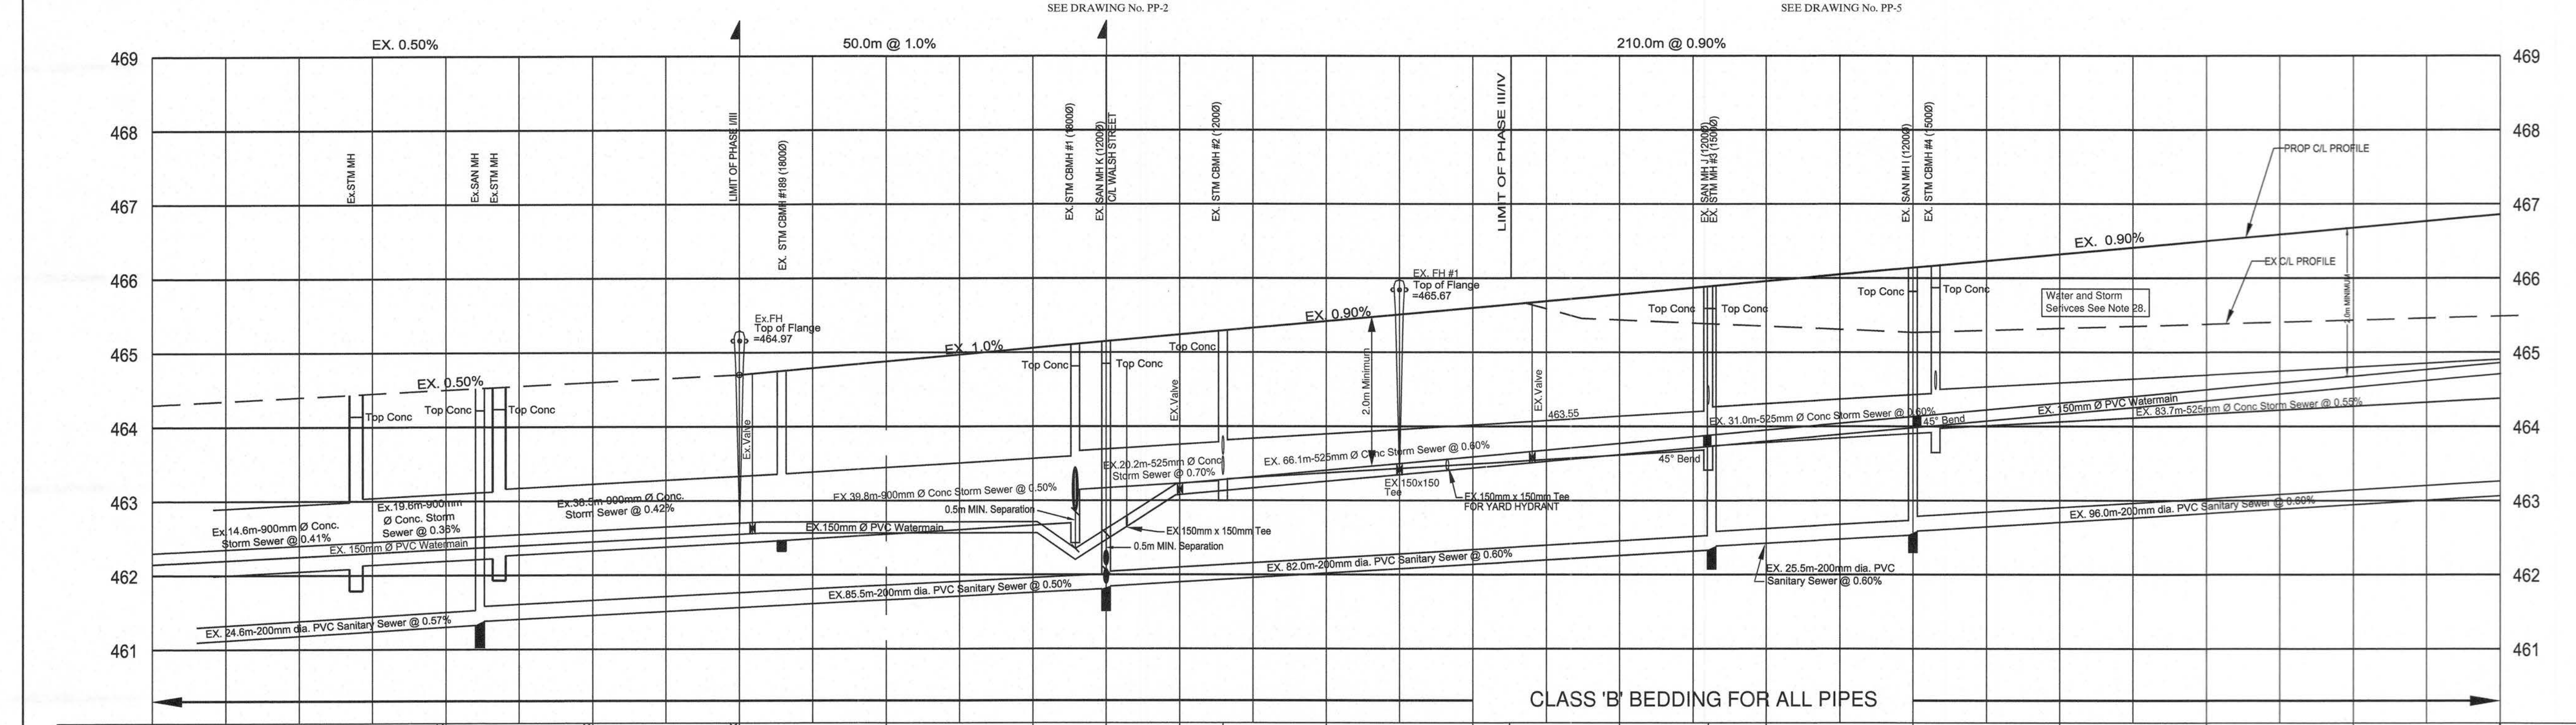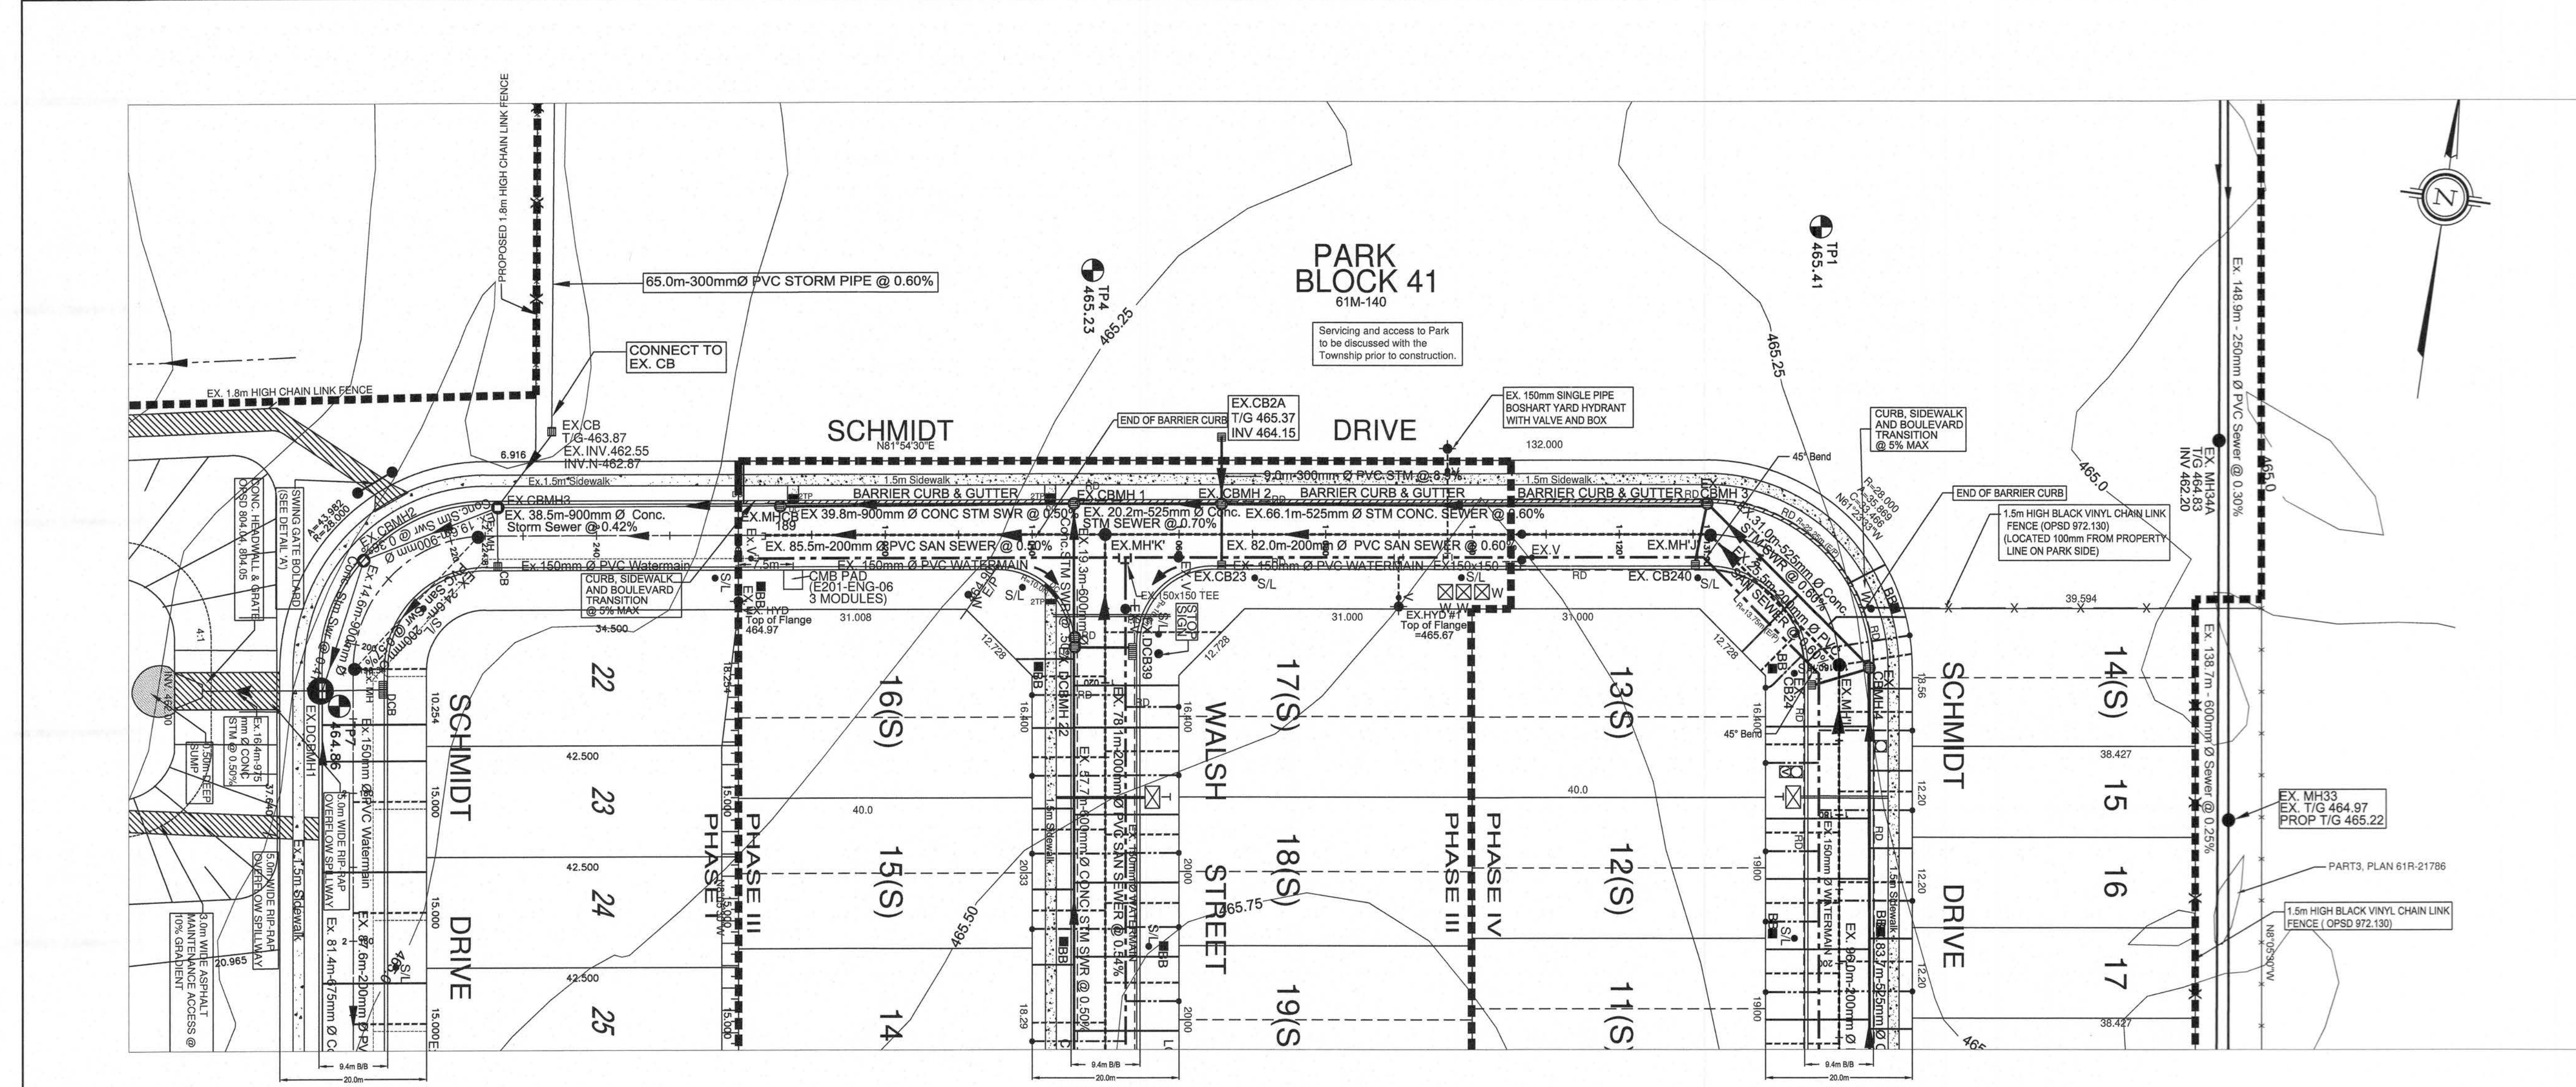


CHANGING	STORM SEWER	SANITARY SEWER	CHANGING
0+194.0	EX. 14.6m-900mm Ø CONC STM SWR @ 0.41%	EX. 24.6m-200mm Ø PVC SAN SWR @ 0.57%	0+194.0
0+196.0	EX. 19.6m-900mm Ø CONC STM SWR @ 0.36%	EX. 19.6m-900mm Ø CONC STM SWR @ 0.36%	0+196.0
0+197.5	EX. 18.6m-900mm Ø CONC STM SWR @ 0.42%	EX. 18.6m-900mm Ø CONC STM SWR @ 0.42%	0+197.5
0+198.0	EX. 38.5m-900mm Ø CONC STM SWR @ 0.42%	EX. 38.5m-900mm Ø CONC STM SWR @ 0.42%	0+198.0
1+000.0	EX. 39.8m-900mm Ø CONC STM SWR @ 0.50%	EX. 85.5m-200mm Ø PVC SAN SWR @ 0.50%	1+000.0
1+003.0	EX. 20.2m-525mm Ø CONC STM SWR @ 0.70%	EX. 20.2m-525mm Ø CONC STM SWR @ 0.70%	1+003.0
1+005.2	EX. 66.1m-525mm Ø CONC SWR STM @ 0.60%	EX. 82.0m-200mm Ø PVC SAN SWR @ 0.60%	1+005.2
1+080.0	EX. 31.0m-525mm Ø CONC STM SWR @ 0.60%	EX. 25.5m-200mm Ø PVC SAN SWR @ 0.60%	1+080.0
1+100.0	EX. 83.7m-525mm Ø CONC STM SWR @ 0.55%	EX. 96.0m-200mm Ø PVC SAN @ 0.60%	1+100.0
1+105.0			1+105.0
1+120.0			1+120.0
1+140.0			1+140.0
1+160.18			1+160.18
1+162.90			1+162.90
1+180.0			1+180.0
1+200.0			1+200.0
1+220.03			1+220.03
1+240.0			1+240.0

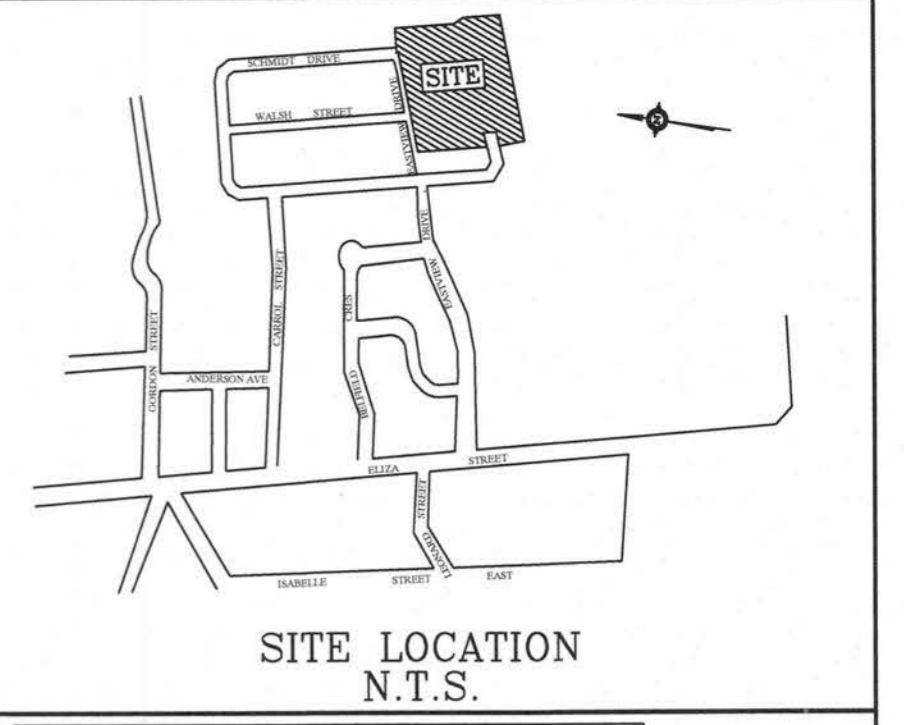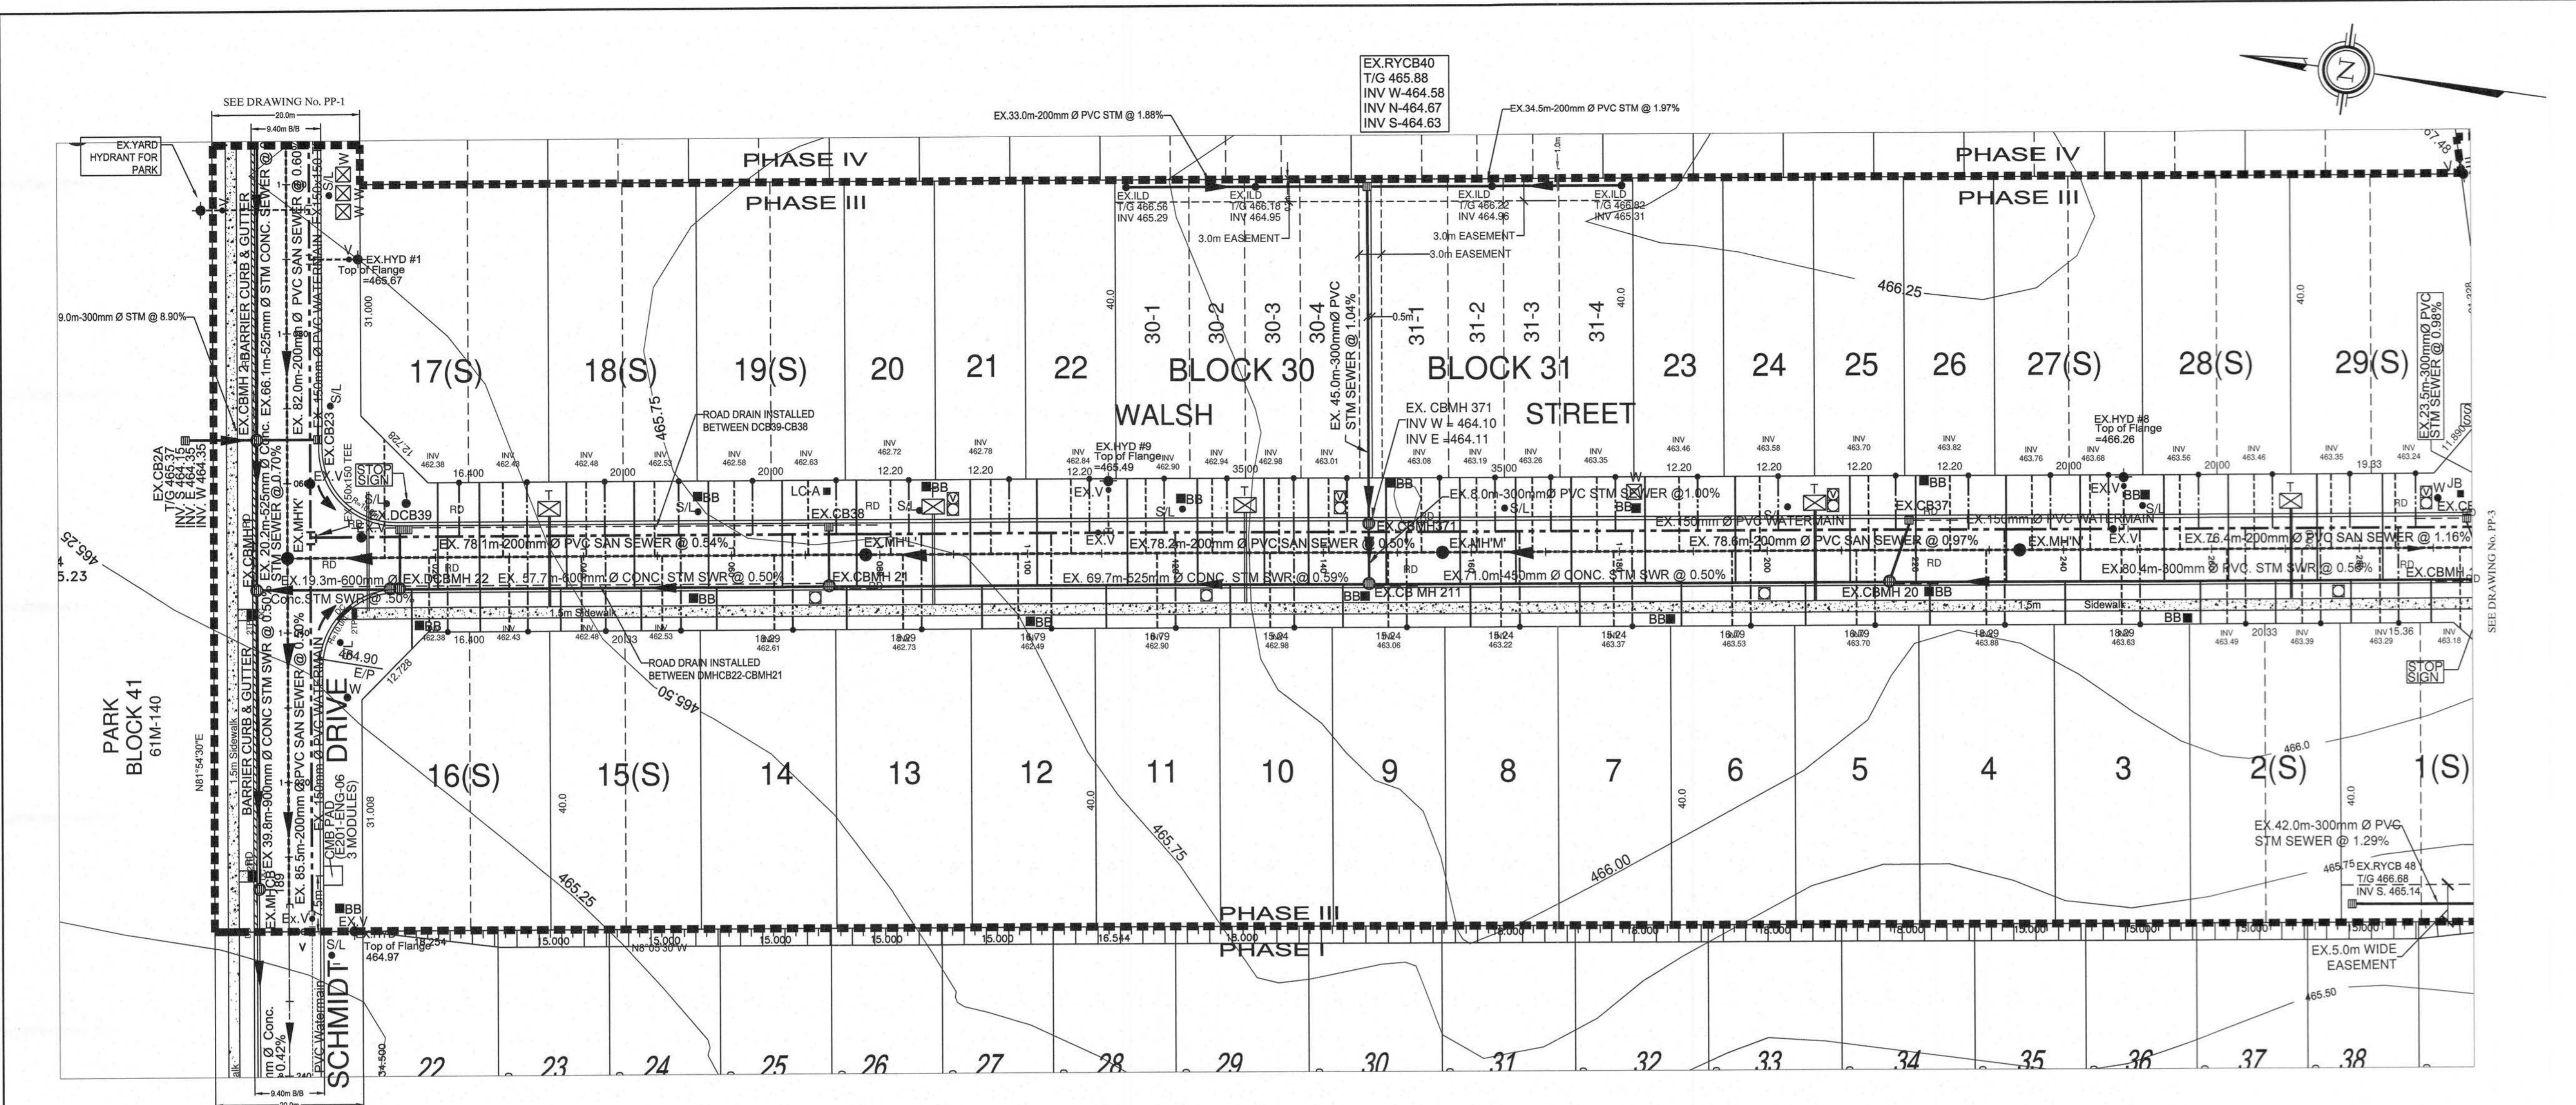

- BENCH MARKS:**
- TOP OF STORM MANHOLE IN BOULEVARD AT SOUTHWEST CORNER OF ELIZA STREET AND GORDON STREET ELEV 482.03
 - TOP OF SANITARY MANHOLE IN CUL-DE-SAC ON FARREL STREET, ELEV 482.31
 - TOP OF SANITARY MANHOLE AT EXISTING EAST LIMIT OF EASTVIEW AVENUE, ELEV 484.27

- NOTES:**
- 150mm Watermain shall be 9000 PVC Class 150 (SDR18), 813.73 with Ring-Tile joints and Tracer Wire. Tracer Wire shall be 12 gauge, 7 strand copper with plastic coating and shall be connected to the storm pump connection. Watermain and services shall be installed minimum 2.0 m below finished grade above the main or service in sand bedding per OPSD 1001.
 - Watermain fittings shall be Ductile Iron/mechanical joint/LAWA C110 approved, pressure rating 1035 PSI.
 - Watermain valves shall be Mueller Wedge Gate Valve per AWWA C-509, Mechanical Joint. Valve extensions to be provided where required.
 - Watermain Valve Boxes shall be 813.73 x 813.73 x 100 mm concrete base with 40 mm steel cover plates as manufactured by BIRBY-ST. CHOX FOUNDRIES INC., Cambridge, Ontario.
 - Hydrants shall be Canada Valve Century Type Compression with "Storz" pump connection. All hydrants to be painted red with black "Storz" cap.
 - Water services to be 25mm single pipe.
 - Another 200-24, 10.5 kg shall be installed on all iron fittings, valves, main stops, curb stops, etc.
 - Main stops, curb stops, unions, service boxes and restraints shall be in accordance with the Township of Wellington North Specifications.
 - Sanitary sewer shall be 200mm PVC-SDR35 meeting the current ASTM D3034 Specifications and CSA B182.2.
 - Sanitary Services shall be 125mm PVC-SDR28 meeting the current ASTM D3034 Specifications and Service connections to be of a minimum grade of 2%.
 - All connections to existing mains shall have manufactured tees. All new connections to existing mains shall use stainless steel stops or saddles or Kor-N-Te.
 - Sanitary sewer manhole fittings shall be PVC-SDR35 meeting the current ASTM D3034-73 Specifications and CSA B182.4.
 - Storm sewers 375mm and less shall be either Concrete (reinforced) or PVC Ultra-Rib, as per CSA-B182.4. Storm sewers greater than 375mm shall be concrete (reinforced).
 - All storm services shall be 150mm PVC-SDR28 and connected to manhole with prefabricated tee or "Kor-N-Te", minimum 1% gradient.
 - All catchbasin leads (250mm Single, 300mm Double) shall be PVC-SDR35. Sideload leads to rear yard catchbasins to be PVC SDR 35 with minimum 1% gradient and 1.2m of cover.
 - All sewer pipes and watermain to be installed in Class 'B' bedding per OPSD 802.01 and 802.03.
 - Pavement design for all roads shall be:
40mm Granular "B" road base
150mm Granular "A" road base
50mm HL4 Binder Course Asphalt
50mm HL3 Surface Course Asphalt
60mm TOTAL DEPTH
 - Concrete Curbs and sidewalks shall be poured using 32mpa strength @ 28 days.
 - All watermain and sewers to be tested in accordance with Township of Wellington North Specifications or as noted in the Contract Documents.
 - Concrete Curbs to be mountable per OPSD 600.10 and Barrier curbs as per OPSD 600.04.
 - Water Service Boxes to be located at streetline and not in driveways, if possible.
 - Sump Pumps to discharge to storm services.
 - Driveways shall be:
40mm Granular "B"
150mm Granular "A"
50mm HL3 Modified Fine Asphalt
 - All structures shall allow for an adjustment of between 150mm-300mm with modulus. All external joints shall be wrapped with 150mm Denastop or equivalent.
 - The plan shall be read in conjunction with Drawing EPC Erosion Control Plan.
 - Road Section to be in accordance with Township Standard Drawing R1 (see section).
 - Traffic Warning Plates shall be installed in sidewalk at curb intersections (as per OPSD 310.03 and OPSD 310.03).
 - Sidewalk ramps at curb intersections shall be 8% maximum gradient.
 - Where storm services and water services conflict with manhole pipes, storm services to go over watermain and water services to go under storm sewer with 0.5m clearance.
 - All catchbasin manholes to have 300mm deep sump. All roadside catchbasins to have 600mm deep sump. No sumps in rear yard catchbasins.
 - Where storm sewer runs along curb line and has been backfilled with approved granular material, then Road Drains (RD) to be 6.0m of 150mm geotextile wrapped perforated approved equipment. If storm sewer is backfilled with native soils, a continuous 150mm x subdrain to be provided along curbline.

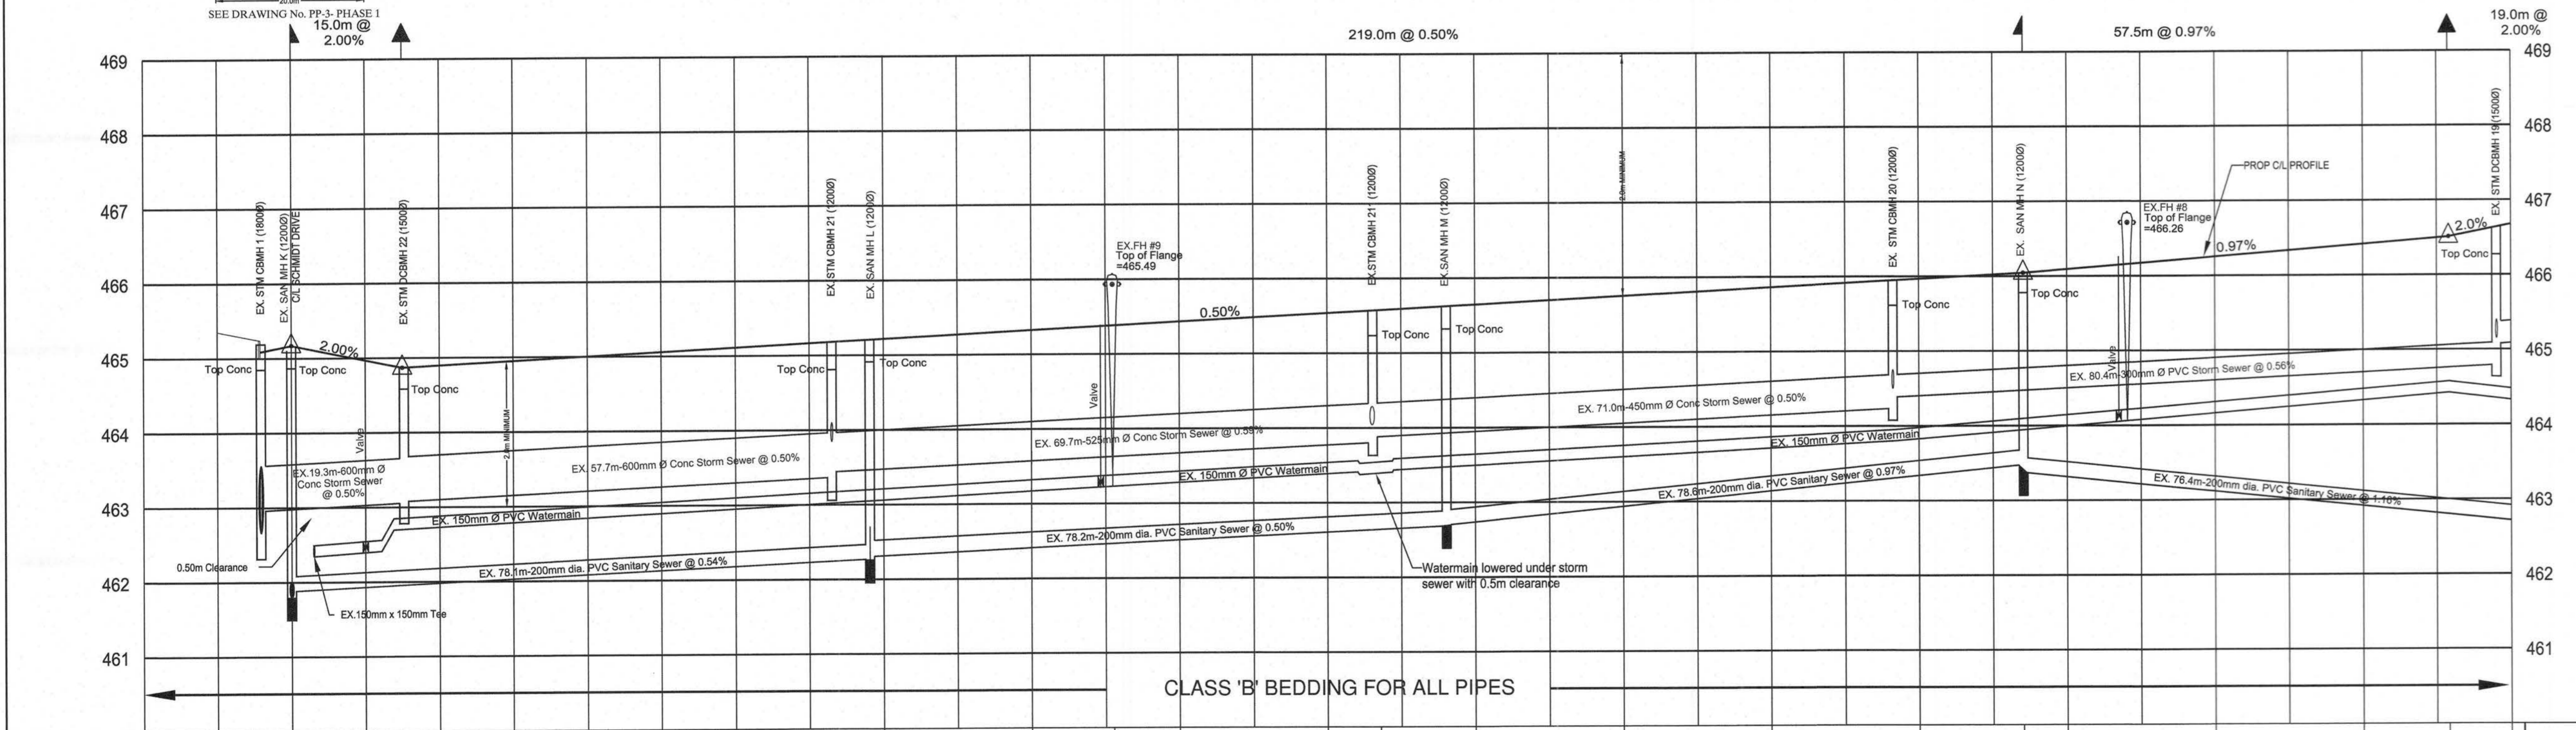

LEGEND:

- STORM SEWER & SERVICES
- SANITARY SEWER & SERVICES
- WATERMAIN, SERVICES, VALVES, HYDRANTS
- TRANSFORMER
- CABLE TV VAULT
- CABLE TV PEDESTAL
- FIBRE OPTICS MAULT
- STREETLIGHT
- LIGHTING PEDESTAL
- BELL BOX GRADE LEVEL
- RIGHT-OF-WAY

No.	DESCRIPTION	REVISIONS	DATE	INTL.
12	PIPE MATERIALS ADDED		26/01/23	KJB
11	AS-CONSTRUCTED U/G SERVICES PHASES IV		06/11/22	KJB
10	LOT NUMBERING CHANGED FOR PHASE IV		20/12/21	KJB
9	STORM SEWER BLOCKS 30 & 31 CHANGED		06/06/21	KJB
8	AS-CONSTRUCTED U/G SERVICES PHASES III		28/12/20	KJB
7	GENERAL REVISIONS		22/06/20	KJB
6	GENERAL REVISIONS		15/03/20	KJB
5	GENERAL REVISIONS		19/05/19	KJB
4	GENERAL REVISIONS		07/01/19	KJB
3	GENERAL REVISIONS		30/11/18	KJB
2	GENERAL REVISIONS		22/02/18	KJB
1	GENERAL REVISIONS		02/11/17	KJB

Checked: Approved: _____


K. J. BEHM AND ASSOCIATES INC.
CONSULTING ENGINEERS
55 ERB STREET EAST, SUITE 101
WATERLOO, ONTARIO N2J 4K8
PHONE (519) 742 3510 FAX (519) 742 3462

CHAINAGE	PROPOSED CL ROAD GRADE	STORM SEWER	SANITARY SEWER
0+995.5	465.15	EX. 19.3m-600mm Ø Conc STM SWR @ 0.50%	EX. 78.1m-200mm Ø PVC SAN SWR @ 0.54%
1+000	465.85	EX. 57.7m-600mm Ø Conc STM SWR @ 0.54%	EX. 78.2m-200mm Ø PVC SAN SWR @ 0.50%
1+015.0	464.88		EX. 71.0m-450mm Ø Conc STM SWR @ 0.50%
1+020	465.08		EX. 78.6m-200mm Ø PVC SAN SWR @ 0.97%
1+040	465.28		EX. 78.4m-200mm Ø PVC SAN SWR @ 1.16%
1+060	465.34		
1+073	465.38		
1+080	465.48		
1+100	465.51		
1+111	465.58		
1+120	465.68		
1+140	465.78		
1+145.5	465.88		
1+156	465.95		
1+160	466.01		
1+180	466.20		
1+200	466.39		
1+216.5	466.51		
1+220	466.68		
1+234	466.88		
1+240	467.00		
1+260	467.10		
1+280	467.20		
1+291.5	467.30		
1+300	467.40		

EASTRIDGE LANDING
SUBDIVISION PHASE III, IV, V
ARTHUR, ONTARIO

PLAN AND PROFILE
WALSH STREET
STA. 1+ 000 TO STA. 1+300

DRAWN	WH	SCALE	HOR. 1 : 500	DWG. No.
DESIGN	KJB	VERT.	1 : 50	PP-2
CHECKED	KJB	DATE	FEB 2013	
PROJECT No.	070119			

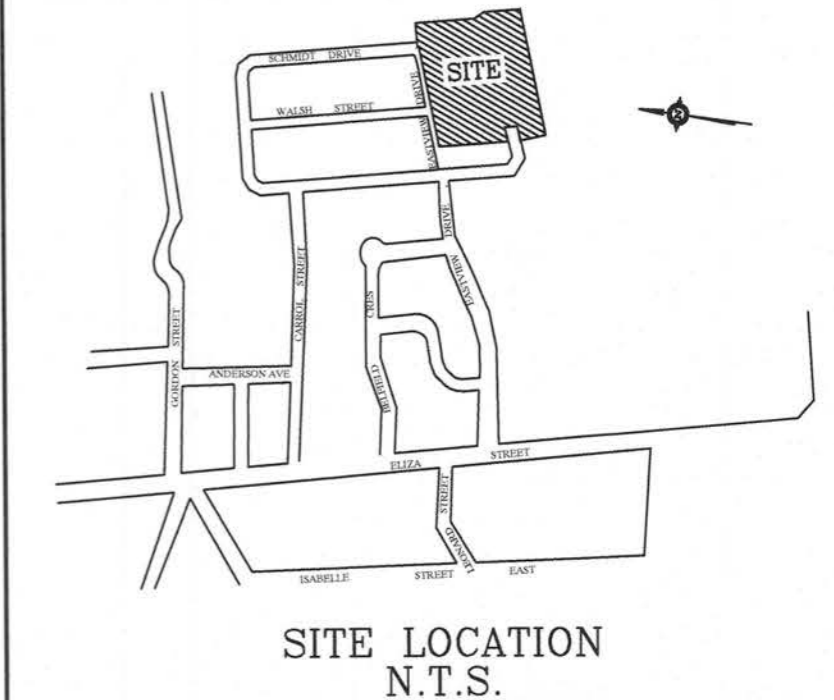


- BENCH MARKS:**
1. TOP OF STORM MANHOLE IN BOULEVARD AT SOUTH WEST CORNER OF ELIZABETH STREET AND GORDON STREET ELEV 462.3
 2. TOP OF SANITARY MANHOLE IN CUL-DE-SAC ON FARREL STREET. ELEV 462.31
 3. TOP OF SANITARY MANHOLE AT EXISTING EAST LIMIT OF EASTVIEW AVENUE. ELEV 464.27

- NOTES:**
1. 150mm Watermain shall be 3000 PVC Class 150 (D18) B137.3 with Ring-Tite joints and Traffic. Tracer wire shall be 12 gauge 7 strand copper with plastic coating and shall be connected to the storm pumper connection. Watermain and services shall be installed minimum 2.0 m below.
 2. Watermain fittings - double iron mechanical joint (AWWA C110 approved, pressure rating 1033 kPa).
 3. Watermain valves shall be Mueller Wedge Gate Valve per AWWA C-508, Mechanical joint. Valve extensions to be provided where required.
 4. Watermain Valve Boxes shall be V8100, 3 piece No.6 round base screw type as manufactured by BERRY-ST. CROSS FOUNDRIES INC. Cambridge, Ontario.
 5. Hydrants shall be Canaco Valve Century Tige Compression with "Storm" pumper connection. All hydrants to be painted red with black "50" top.
 6. Water services to be 25mm single PEX PIPE.
 7. Anodes: DZP-24, 10.9 kg shall be installed on all connections to existing watermains.
 8. DZP-12, 5.4 kg shall be installed on all iron fittings, valves, main stops, curb stops, unions, service boxes and restraints shall be in accordance with the Township of Wellington North Specifications.
 9. Sanitary sewer shall be 200mm PVC-SDR35 meeting the current ASTM D3034 Specifications and CSA B182.2.
 10. Sanitary Services shall be 125mm PVC-SDR28 meeting the current ASTM D3034 Specifications. Service connections to be at a minimum grade of 2%. All connections to new mains shall have manufactured tees. All new connections to existing mains shall use stainless steel straps and saddles or Kor-N-Tee.
 11. Sanitary sewer mainline fittings shall be PVC-SDR35 meeting the current ASTM D3034-73 Specifications and CSA B182.4.
 12. Storm sewers 375mm and less shall be either Concrete (reinforced) or PVC Ultra-Rib, as per CSA-B182.4. Storm sewers greater than 375mm shall be concrete (reinforced).
 13. All storm services shall be 100mm PVC-SDR28 and connected to manholes with prefabricated tee or "Kor-N-Tee", minimum 1% gradient.
 14. All sewer leads (250mm Single, 300mm Double) shall be PVC-SDR35. Sidelap leads to rear yard catchbasins to be PVC SDR 35 with minimum 1% gradient and 1.2m of cover.
 15. All sewer pipes and watermains to be installed in Class 'B' Bedding per OPS 802.01 and 802.03.
 16. Powerman design for all roads shall be:
450mm Granular "B" road base
150mm Granular "A" road base
50mm H4 Binder Course Asphalt
40mm H3 Surface Course Asphalt
600mm TOTAL DEPTH
 17. Concrete Curb and sidewalks shall be poured using 32Mpa strength @ 28 days.
 18. All watermain and sewers to be tested in accordance with Township of Wellington North Specifications or as noted in the Contract Documents.
 19. Concrete Curb to be mountable as per OPS 600.10 and Barrier curb as per OPS 600.04.
 20. Water Service Boxes to be located at streetline and not in driveways, if possible.
 21. Sump Pumps to discharge to storm services.
 22. Driveways shall be:
450mm Granular "B"
150mm Granular "A"
50mm H3C Modified Fine Asphalt
 23. All structures shall allow for an adjustment of between 150mm-300mm with manholes. All exterior joints shall be wrapped with 150mm Densotex or equivalent. This joint shall be red in conjunction with Drawing CPC Erosion Control Plan.
 24. Road Section to be in accordance with Township Standard Drawing R1 (see section Drawing B1-1).
 25. 3000 PSI Concrete Slabs shall be installed in sidewalk at curb intersections as per Drawing B1-1.
 26. Sidewalk ramps at curb intersections shall be 8% maximum gradient.
 27. Where storm services and water services conflict with manholes, storm services to go over watermain and water services to go under storm sewer with 0.5m clearance.
 28. All catchbasin manholes to have 300mm deep sump. All roadside catchbasins to have 600mm deep sump. No sumps in rear yard catchbasins.
 29. Where storm sewer runs along curb line and has been backfilled with approved granular material, then Road Drains (RD) to be 0.5m of 150mm granular bedding wrapped perforated subdrain required upstream of all catchbasins and catchbasin manholes and in both directions in the same 0.5m of the road. Subdrains to be 90, V, 1000 or approved equivalent. Storm sewer to be backfilled with native soils, a continuous 150mm subdrain to be provided along curbline.

REVISIONS

No.	DESCRIPTION	DATE	INTL.
13	PIPE MATERIALS ADDED	12/06/21	KJB
12	AS-CONSTRUCTED U/G SERVICES PHASES IV, V	06/11/22	KJB
11	LOT NUMBERING CHANGED IN PHASE IV	20/12/21	KJB
10	STORM SEWER REMOVED LOTS 16-21	06/06/21	KJB
9	GENERAL REVISIONS	15/02/21	KJB
8	AS-CONSTRUCTED U/G SERVICES PHASES III, IV, V	28/12/20	KJB
7	GENERAL REVISIONS	22/06/20	KJB
6	GENERAL REVISIONS	15/03/20	KJB
5	GENERAL REVISIONS	19/05/19	KJB
4	GENERAL REVISIONS	07/01/19	KJB
3	GENERAL REVISIONS	30/11/18	KJB
2	GENERAL REVISIONS	22/02/18	KJB
1	GENERAL REVISIONS	02/11/17	KJB

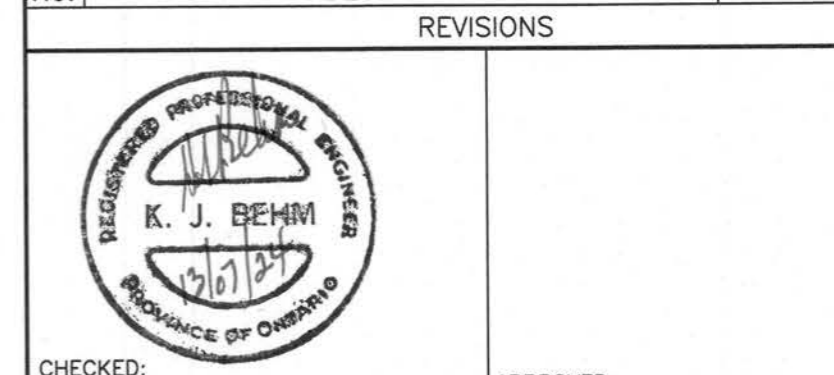



CHECKED: [Signature] APPROVED: [Signature]

K. J. BEHM AND ASSOCIATES INC.
CONSULTING ENGINEERS
55 EBR STREET EAST, SUITE 101
WATERLOO, ONTARIO N2J 4K6
PHONE (519) 742 3510 FAX (519) 742 3462


EASTRIDGE LANDING
SUBDIVISION PHASE III, IV, V
ARTHUR, ONTARIO

PLAN AND PROFILE
WALSH STREET
STA. 1+200 TO STA. 1+500

DRAWN	WDH	SCALE	HOR: 1 : 500	DWG. No.
DESIGN	KJB	DATE	VERT: 500 : 30	PP-3
CHECKED	KJB	DATE	FEB 2013	
PROJECT No.	070119			

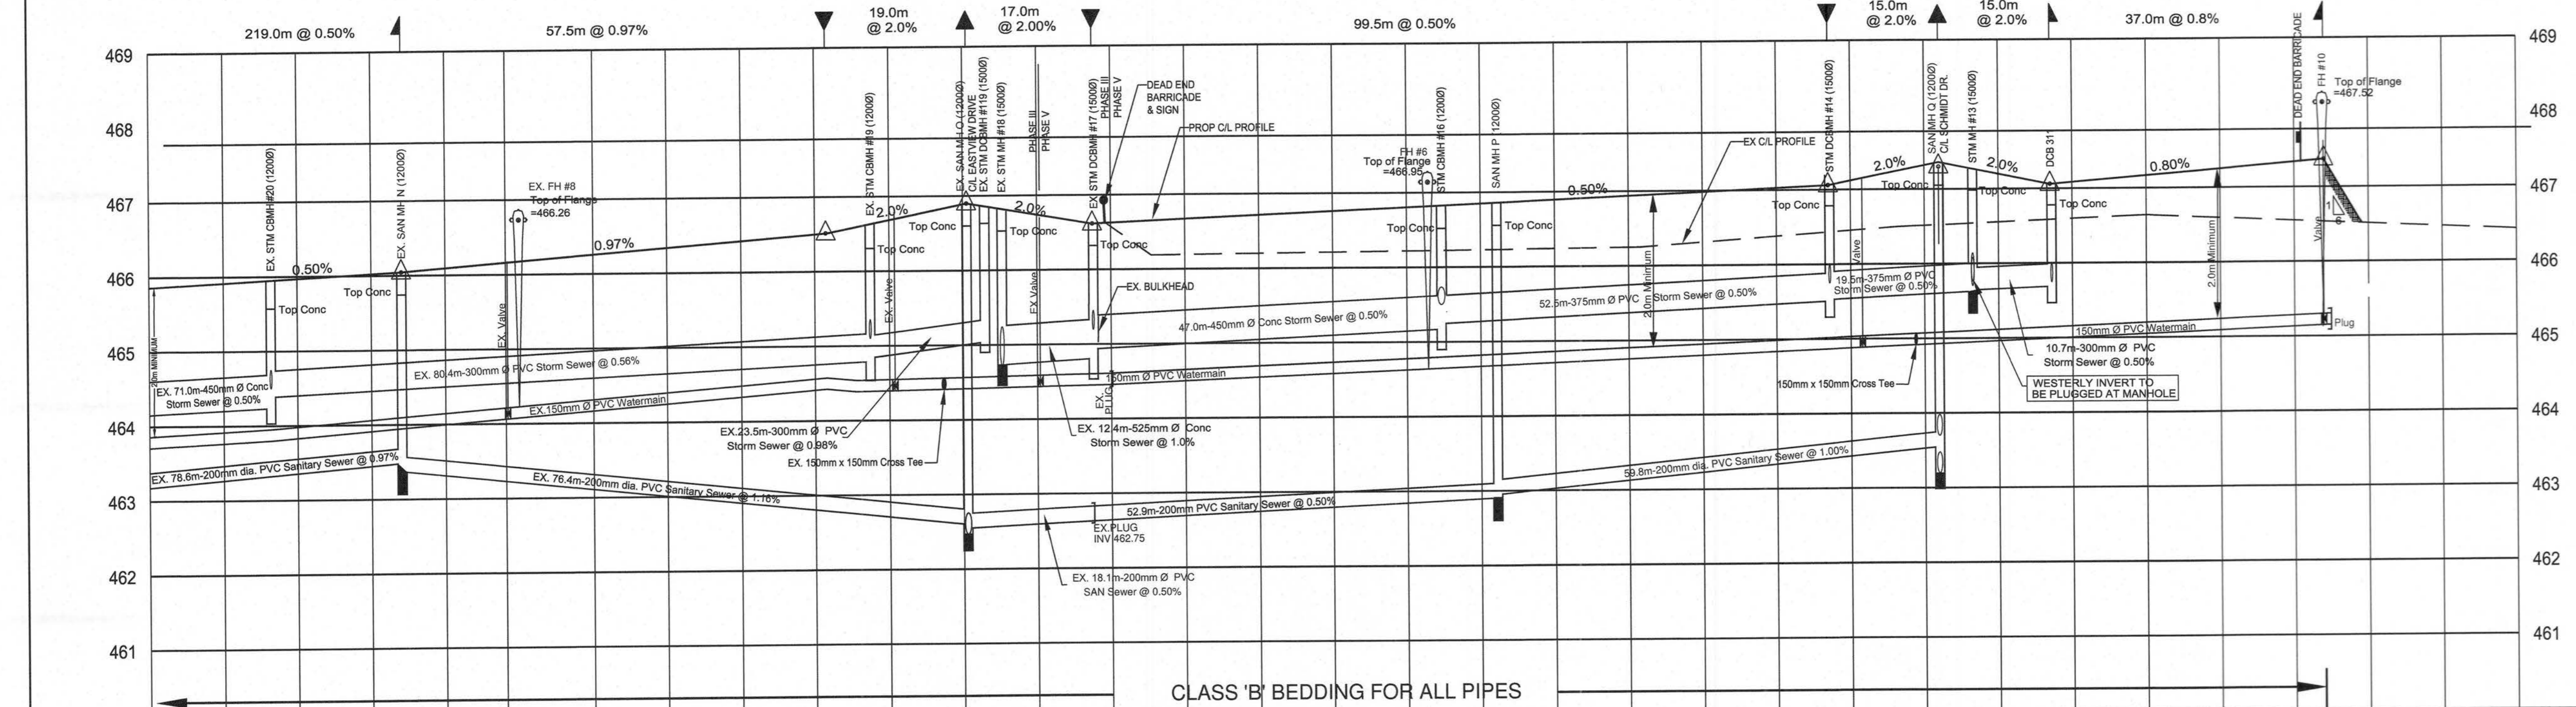
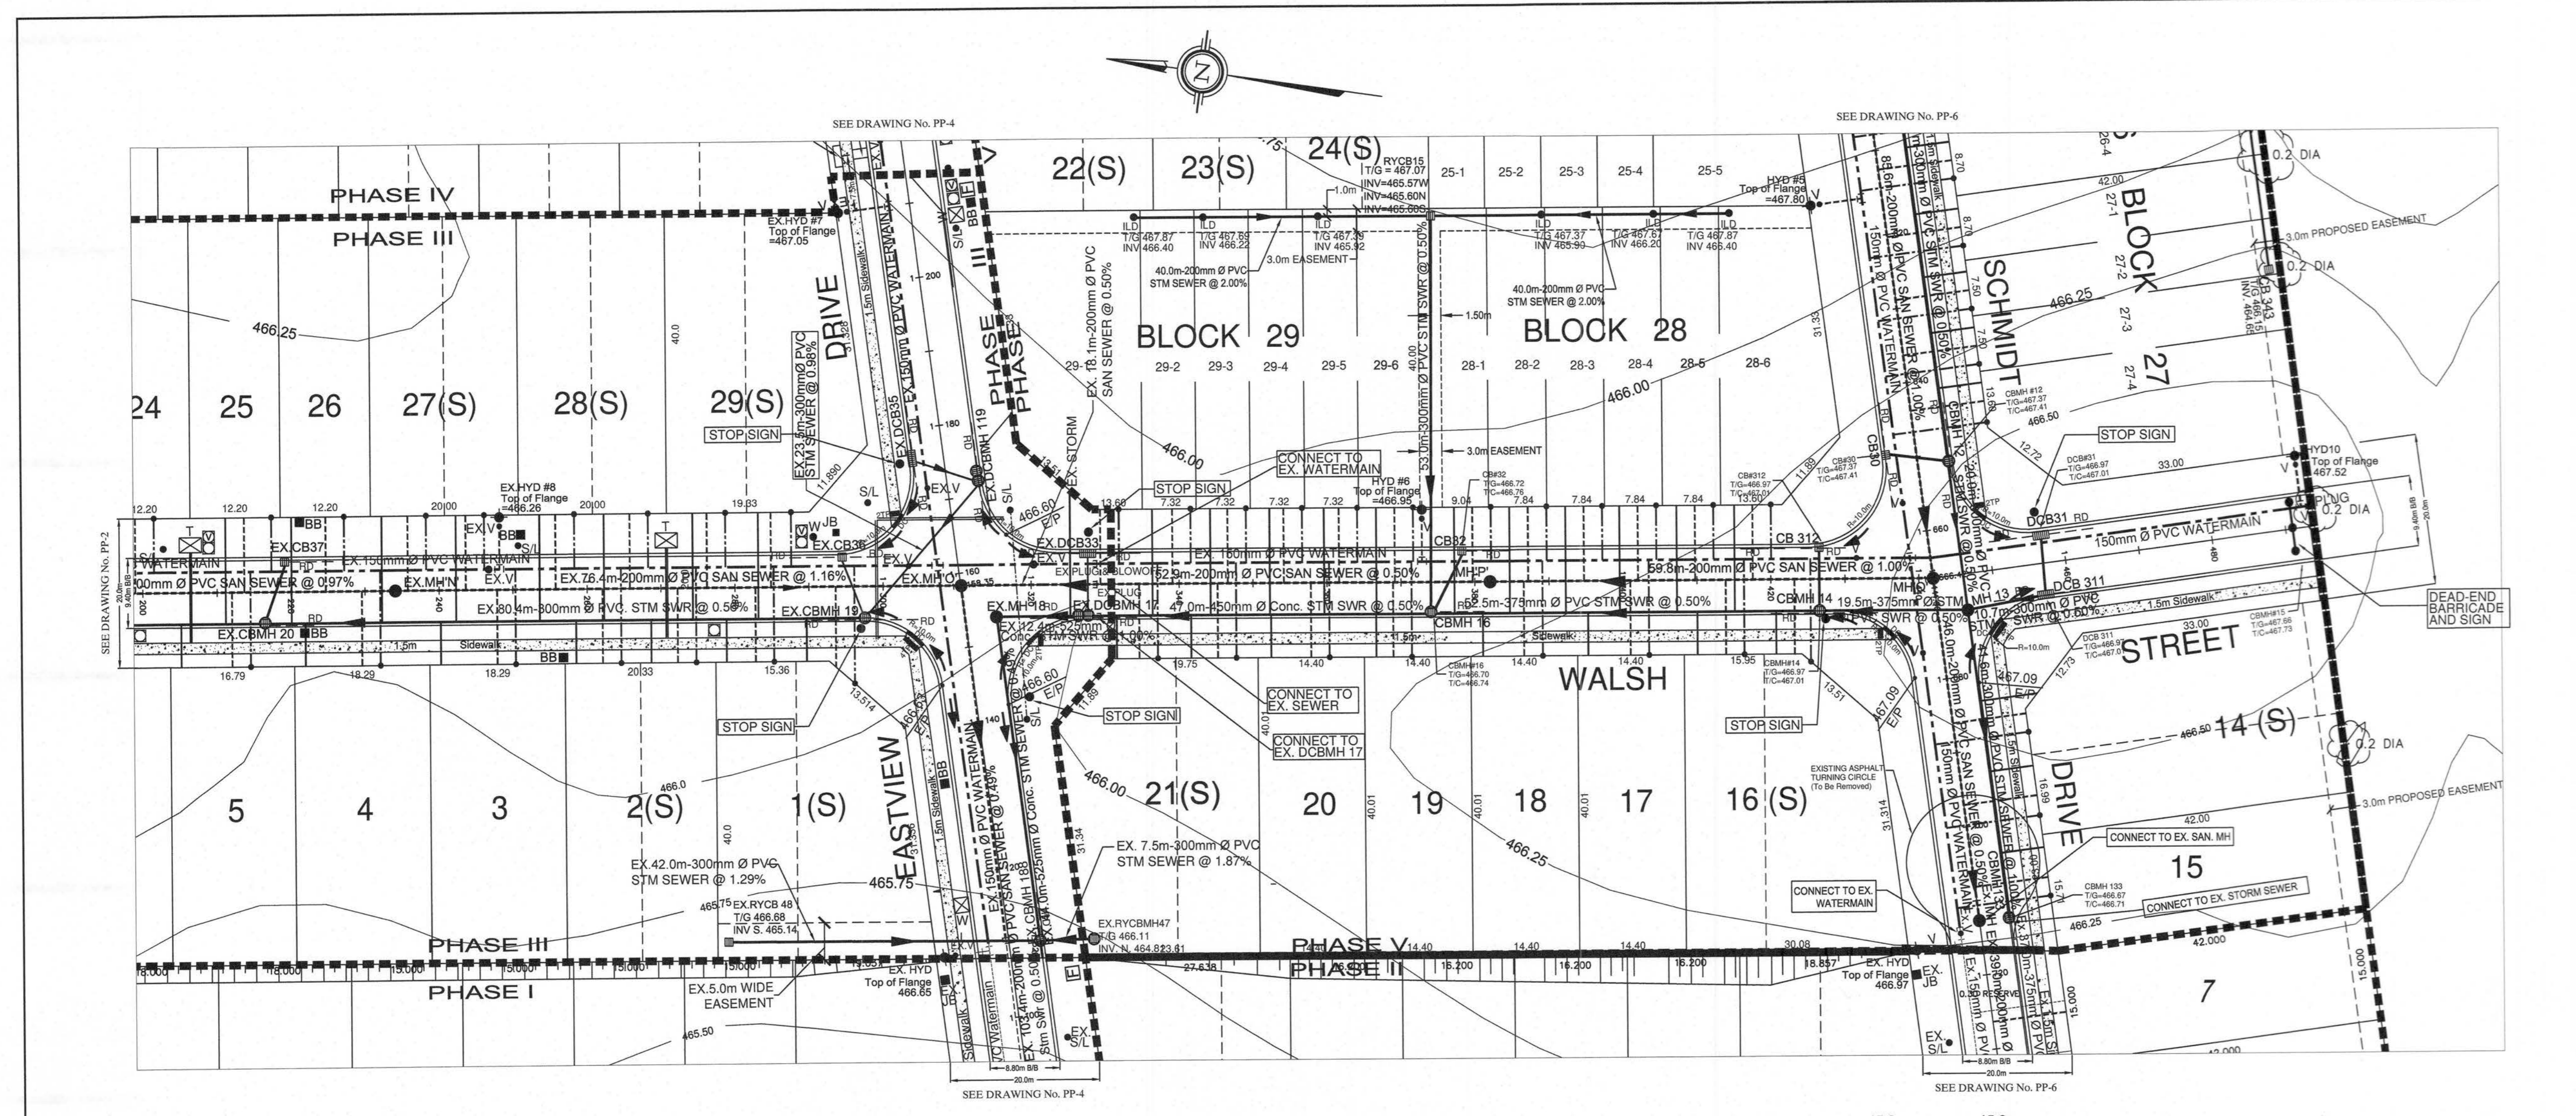


PROPOSED CL ROAD GRADE	STORM SEWER	SANITARY SEWER	CHAINAGE
465.78	EX. 71.0m-450mm Ø Conc Storm Sewer @ 0.50%	EX. 78.6m-200mm Ø PVC SAN SWR @ 0.97%	1+200
465.88			1+215.5
465.95	EX. 80.4m-300mm Ø PVC STM SWR @ 0.56%	EX. 76.4m-200mm Ø PVC SAN SWR @ 1.16%	1+220
465.01			1+234
466.20			1+240
466.39			1+247.5 High Pt
466.51			1+250
466.68			1+260
466.80 HF	EX. 23.5m-300mm Ø PVC STM SWR @ 0.98%	EX. 18.1m-200mm Ø PVC SAN SWR @ 0.50%	1+280
466.95			1+291.5 Low Pt
467.00			1+300
467.10 HF	EX. 47.0m-450mm Ø Conc STM SWR @ 0.50%	EX. 12.4m-525mm Ø Conc STM SWR @ 1.00%	1+310.5
467.20			1+320
467.25			1+327.5
467.36			1+340
467.40			1+360
467.45			1+374.5
467.50			1+380
467.55			1+381.0
467.60			1+400
467.65			1+420
467.70			1+427.0
467.75			1+440
467.80			1+457.0
467.85			1+460
467.90			1+480
467.95			1+494.0 Subd Limit

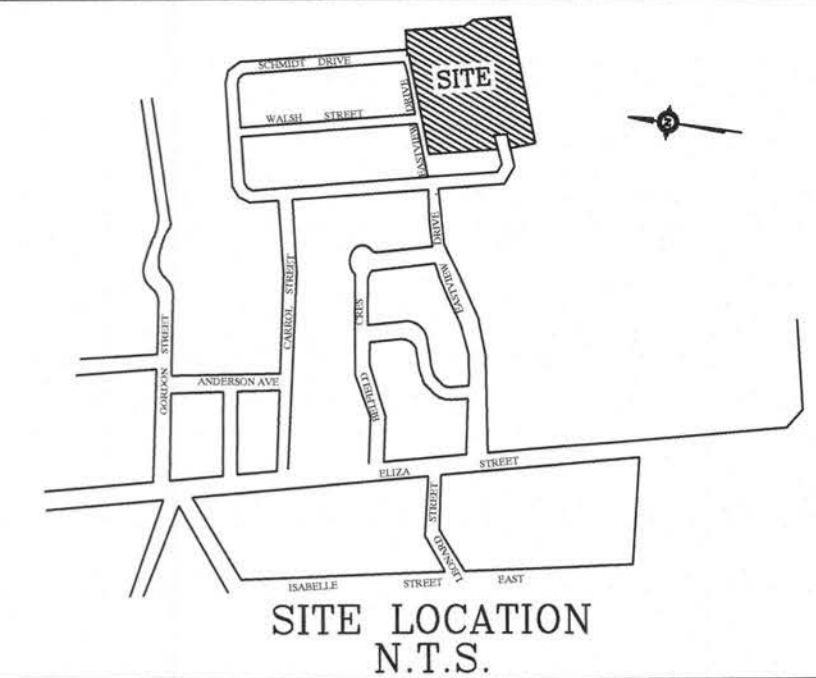

- BENCH MARKS:**
1. TOP OF STORM MANHOLE IN BOULEVARD AT SOUTHWEST CORNER OF ELIZA STREET AND GORDON STREET ELEV 462.03
 2. TOP OF SANITARY MANHOLE IN CUL-DE-SAC ON FARREL STREET. ELEV 462.27
 3. TOP OF SANITARY MANHOLE AT EXISTING EAST LIMIT OF EASTVIEW AVENUE. ELEV 464.27

- NOTES:**
1. 150mm Watermain shall be C900 PVC Class 150(DR18) . 8137.3 with Ring-The joints and Tracer Wire. Tracer Wire shall be 12 gauge 7 strand copper with plastic coating and shall be connected to the storm pump connection. Watermain services shall be installed minimum 2.0 m below finished grade above the main or service in sand bedding per OPS 1001.
 2. Watermain fittings shall be ductile iron, mechanical joint, AWWA C110 approved, pressure rating 1033 kPa.
 3. Watermain valves shall be Mueller Wedge Gate Valve per AWWA C-509. Mechanical joint. Valve extensions to be provided where required.
 4. Watermain Valve Boxes shall be V81000, 3 piece No.6 round base screw type as manufactured by BIRBY-EST CROOK FOUNDRIES INC. Cambridge Ontario.
 5. Hydrants shall be Canada Valve Century Type Compression with "Storz" pump connection. All hydrants to be painted red with black "50" cap.
 6. Water services to be 25mm single pipe.
 7. Anodes: DDP-24, 15.8 kg shall be installed on all connections to existing iron watermains. DDP-12, 5.4 kg shall be installed on all iron fittings, valves, man stops, curb stops, etc.
 8. Man stops, curb stops, unions, service boxes and restrains shall be in accordance with the Township of Wellington North Specifications.
 9. Sanitary sewer shall be 200mm PVC-SDR35 meeting the current ASTM 15000 Specifications and CSA-B182.2.
 10. Sanitary Services shall be 125mm PVC-SDR28 meeting the current CSA-B182.2 Specifications. Service connections to be of a minimum grade of 2%. All connections to new mains shall have manufactured tees. All new connections to existing mains shall use stainless steel stops and saddles or Kor-N-Te.
 11. Sanitary sewer manline fittings shall be PVC-SDR35 meeting the current ASTM 15000-17 Specifications and CSA B182.4.
 12. Storm sewers 375mm and less shall be either Concrete (reinforced) or PVC Ultra-Rib, as per CSA-B182.4. Storm sewers greater than 375mm shall be concrete (reinforced).
 13. All storm services shall be 100mm PVC-SDR35 and connected to manline with prefabricated tees or "Kor-N-Te", minimum 1% gradient.
 14. All catchbasin leads (250mm Single, 300mm Double) shall be PVC-SDR35. Sideload leads to reynard catchbasins to be PVC SDR 35 with minimum 1% gradient and 1.2m of cover.
 15. All sewer pipes and watermain to be installed in Class 'B' Bedding per OPS 600.02 and 600.03.
 16. Pavement design for all roads shall be:
450mm Granular "A" road base
150mm H-4 Binder Course Asphalt
50mm H-3 Surface Course Asphalt
90mm TOTAL DEPTH
 17. Concrete curbs and sidewalks shall be poured using 32Mpa strength @ 28 days.
 18. All watermain and sewers to be tested in accordance with Township of Wellington North Specifications or as noted in the Contract Documents.
 19. Concrete Curb to be mountable as per OPS 600.10 and Barrier curb as per OPS 600.04.
 20. Water Service Boxes to be located at streetline and not in driveways, if possible.
 21. Sump Pumps to discharge to storm services.
 22. Driveways shall be:
450mm Granular "A"
150mm Granular "B"
50mm H-3 Modified Fine Asphalt
 23. All structures shall allow for an adjustment of between 150mm-300mm with masonry. All external joints shall be wrapped with 150mm Densopac or equivalent.
 24. This plan shall be read in conjunction with Drawing EPC Erosion Control Plan.
 25. Road Section to be in accordance with Township Standard Drawing R1 (see section Drawing R1-1).
 26. Tackling Warning Plates shall be installed in sidewalk at curb intersections as per OPS 310.03P and OPS 310.03S.
 27. Sidewalk ramps at curb intersections shall be 8% maximum gradient.
 28. Where storm services and water services conflict with manline pipes, storm services to go over watermain and water services to go under storm sewer with 0.5m clearance.
 29. All catchbasin manholes to have 300mm deep sump. All roadside catchbasins to have 600mm deep sump. No sumps in reynard catchbasins.
 30. Where storm sewer runs along curb line and has been backfilled with approved granular material, then Road Drains (RD) to be 8.0m of 150mm geotextile wrapped perforated subsoil required upstream of all catchbasins and catchbasin manholes and in both directions in the area in the road. Subdrains to be 8" of 1000 or approved equivalent, if storm sewer is backfilled with native soils, a continuous 150mm x 150mm to be provided along curbline.

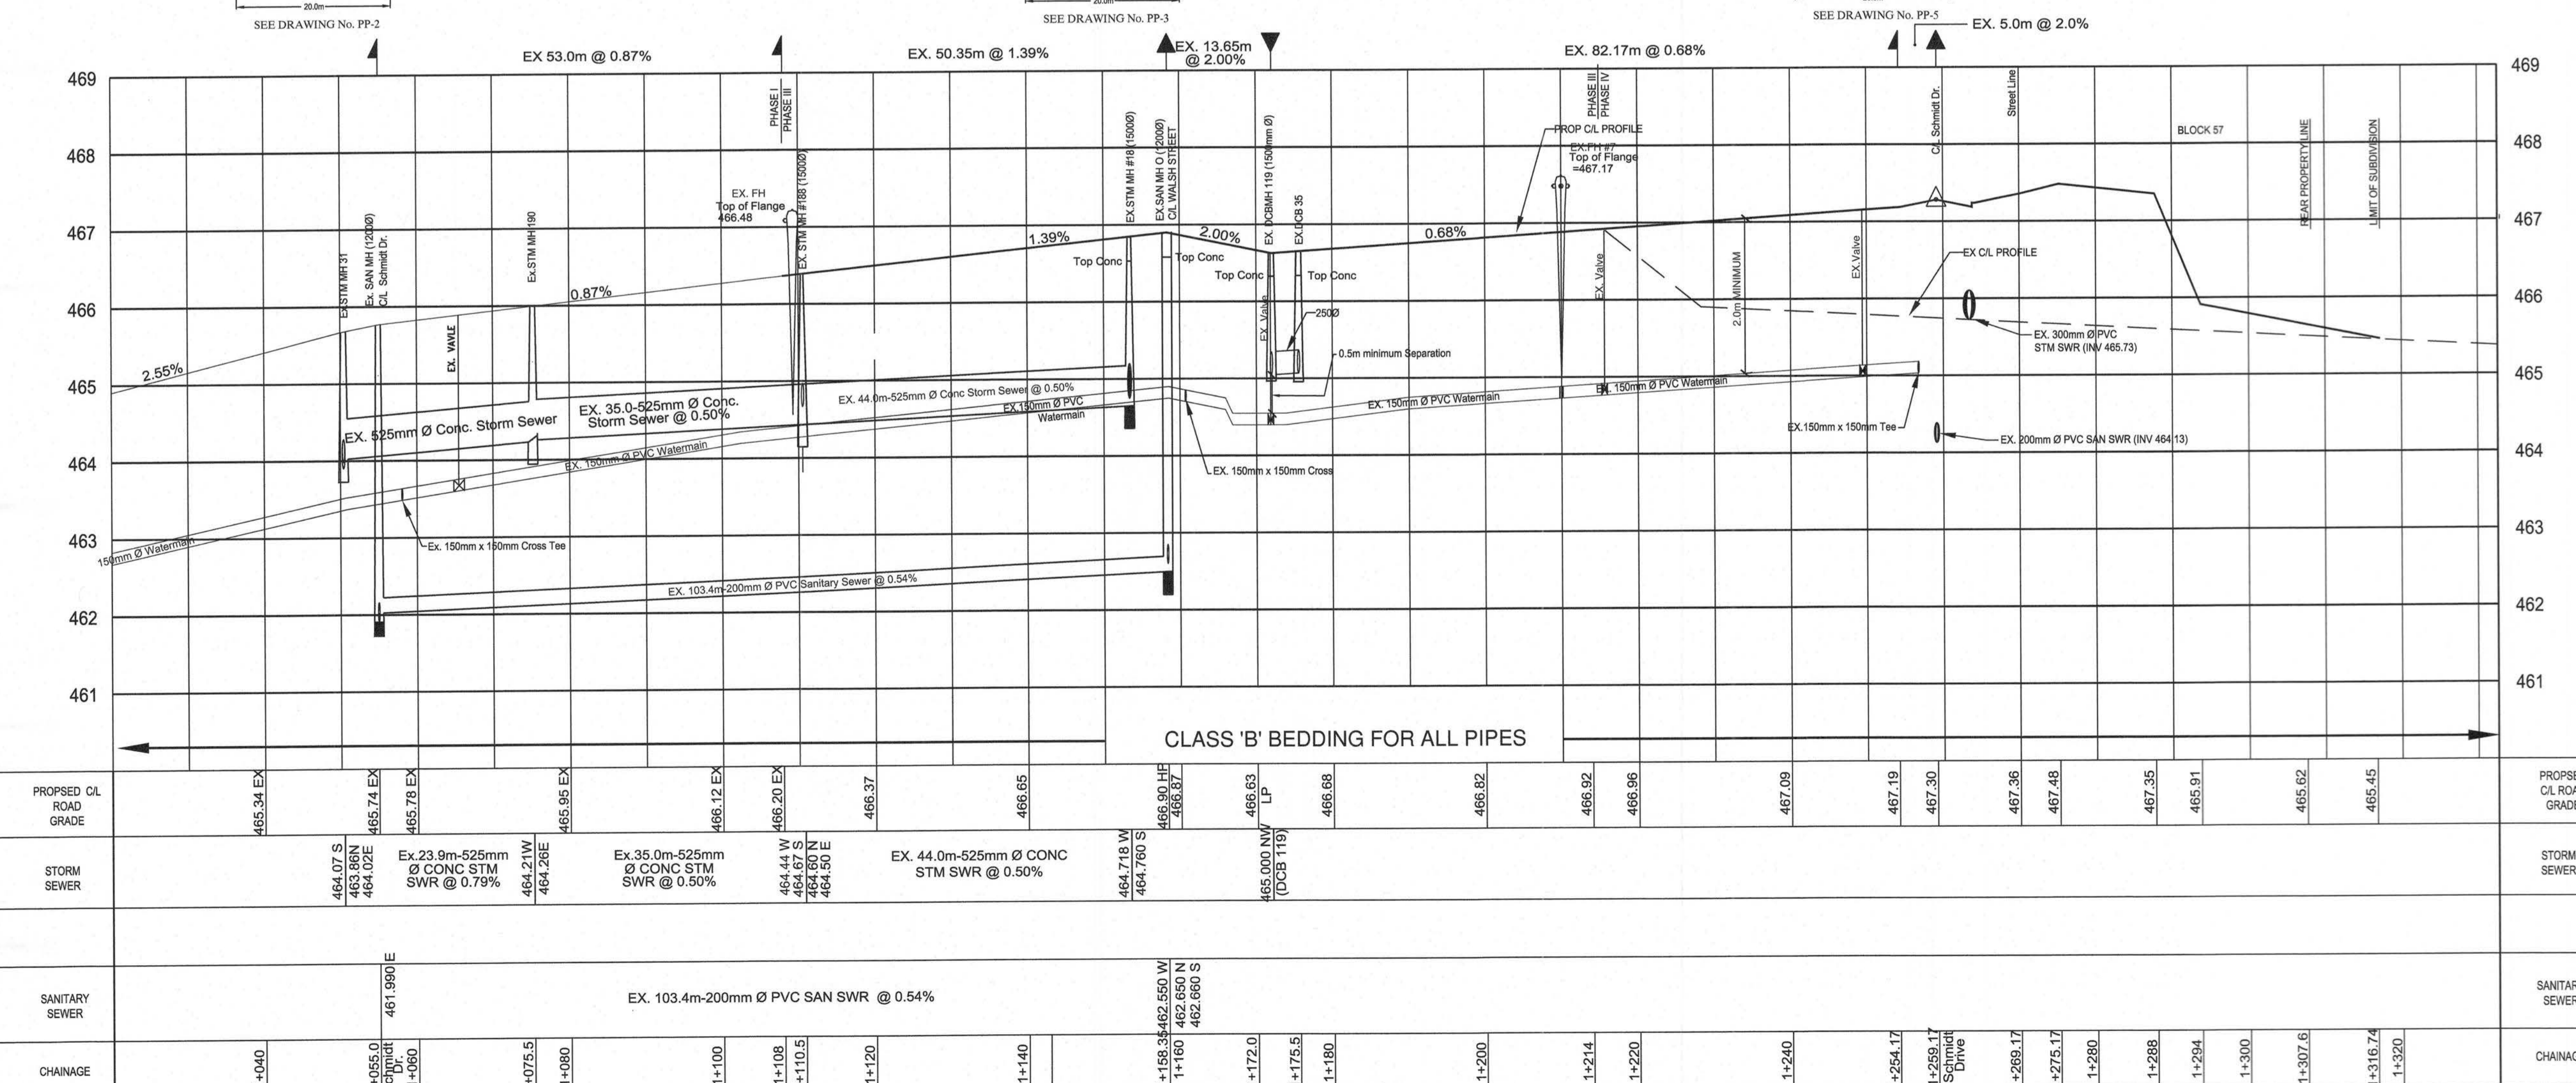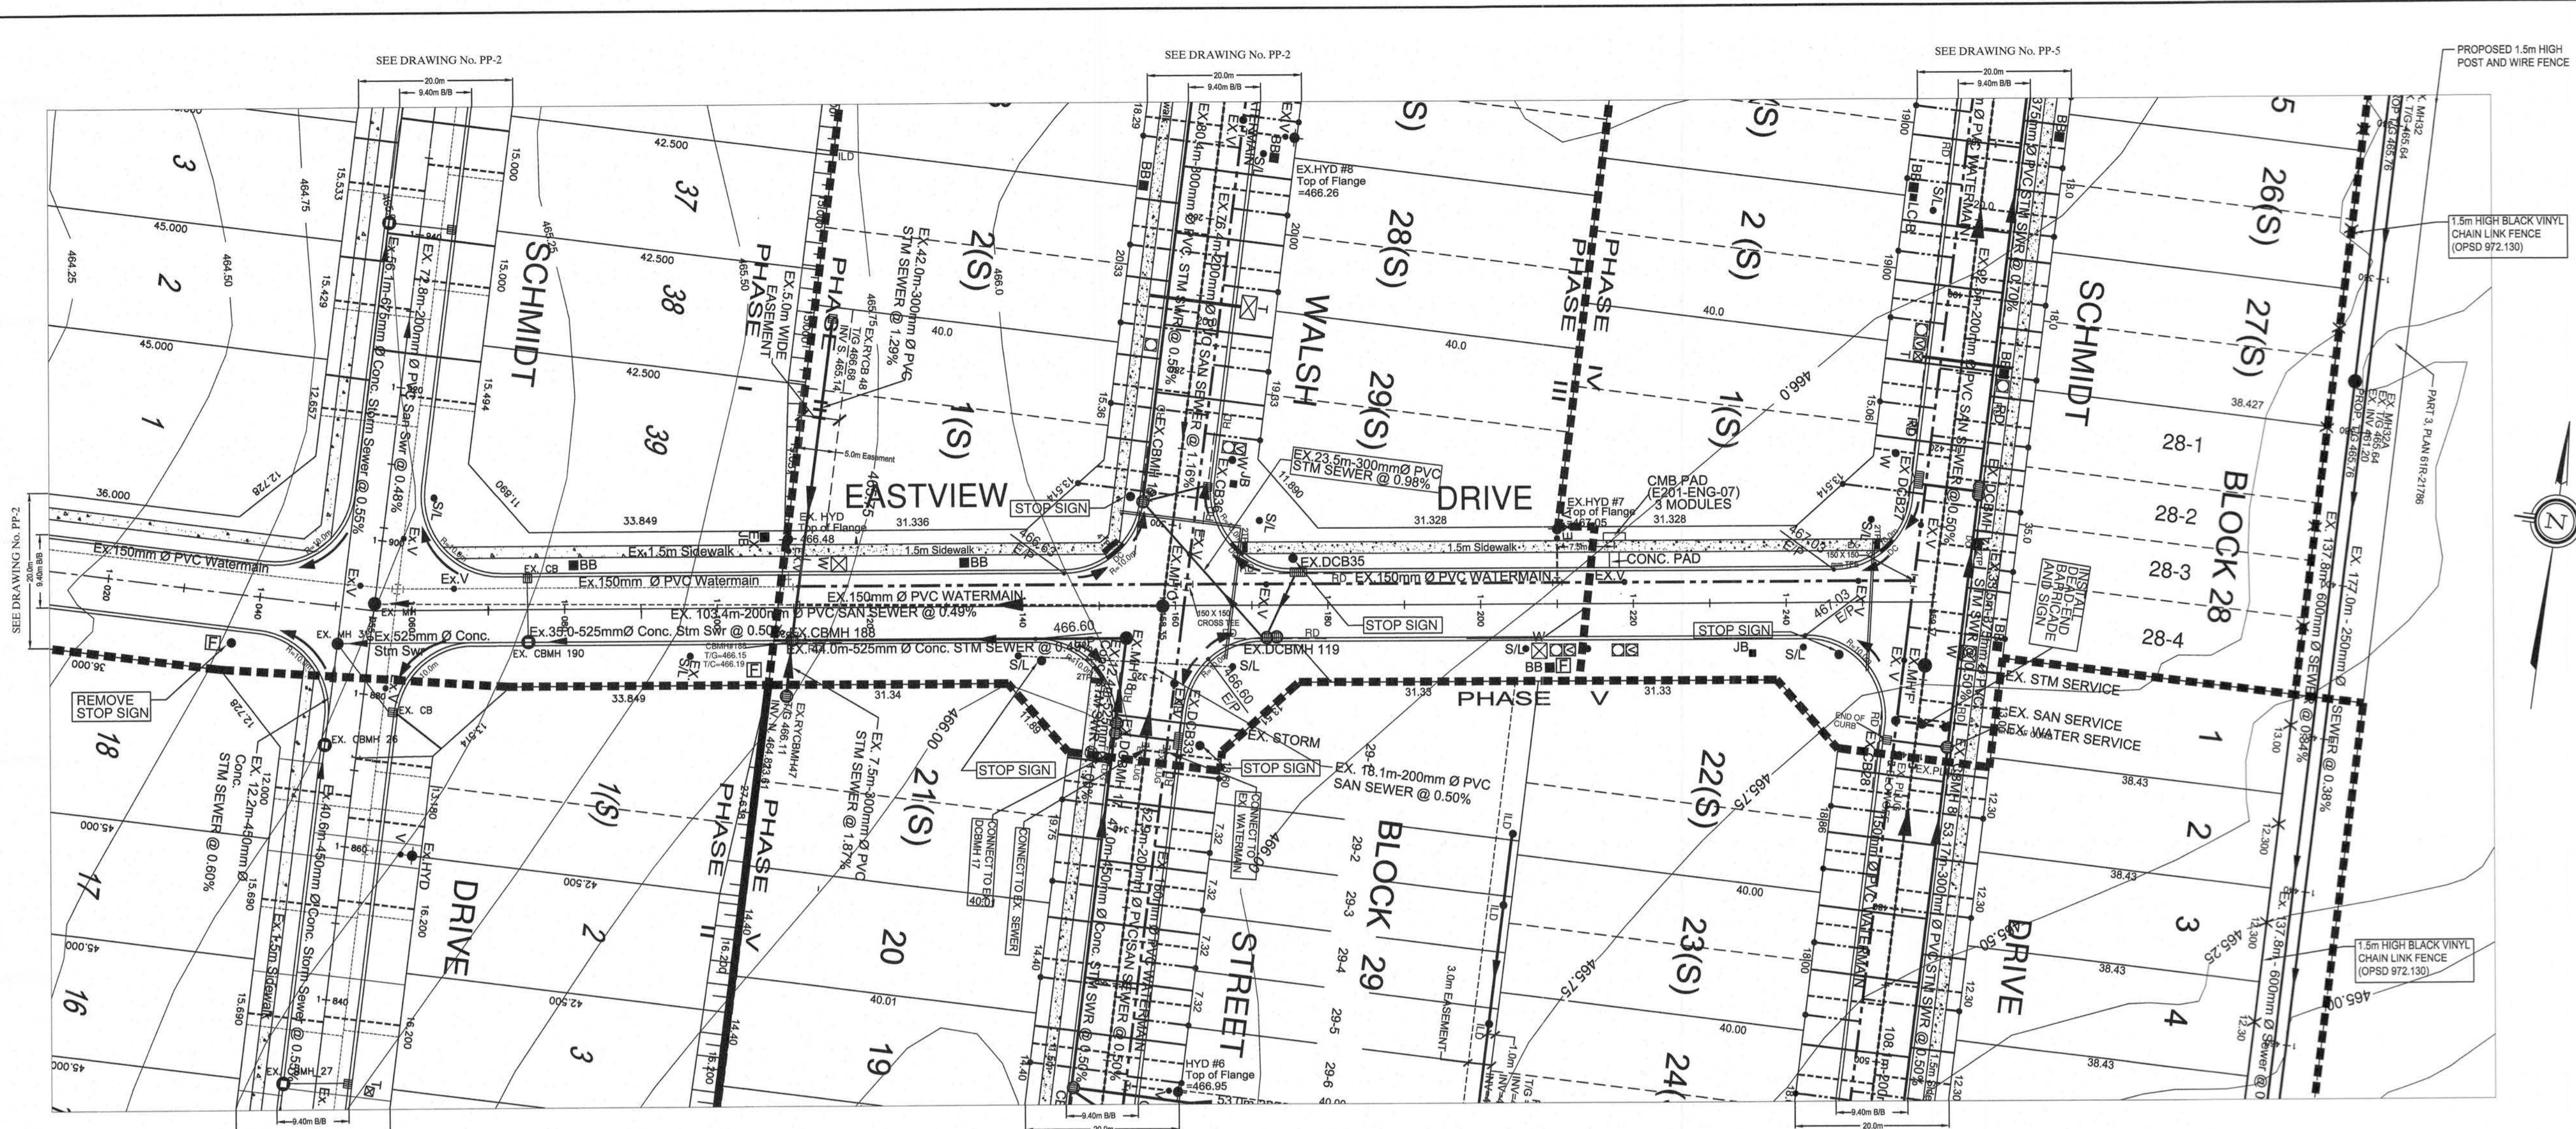

LEGEND:

- STORM SEWER & SERVICES
- SANITARY SEWER & SERVICES
- WATERMAIN, SERVICES, VALVES, HYDRANTS
- TRANSFORMER
- CABLE TV VAULT
- CABLE TV PEDESTAL
- STREETLIGHT
- FIBRE OPTICS VAULT
- LIGHTING PEDESTAL
- BELL BOX GRADE LEVEL
- WIGHTMAN VAULTS & OPS

No.	DESCRIPTION	DATE	INTL.
13	PIPE MATERIALS ADDED	26/01/23	KJB
12	AS-CONSTRUCTED U/G SERVICES PHASES IV	06/11/22	KJB
11	LOT NUMBERING CHANGED FOR PHASE IV	20/12/21	KJB
10	STORM SEWER REMOVED LOTS 16-21	06/06/21	KJB
9	GENERAL REVISIONS	15/02/21	KJB
8	AS-CONSTRUCTED U/G SERVICES PHASES III	28/12/20	KJB
7	GENERAL REVISIONS	22/06/20	KJB
6	GENERAL REVISIONS	15/03/20	KJB
5	GENERAL REVISIONS	19/05/19	KJB
4	GENERAL REVISIONS	07/01/19	KJB
3	GENERAL REVISIONS	30/11/18	KJB
2	GENERAL REVISIONS	22/02/18	KJB
1	GENERAL REVISIONS	02/11/17	KJB



CHECKED: [Signature] APPROVED: [Signature]

K. J. BEHM AND ASSOCIATES INC.
CONSULTING ENGINEERS
55 ERB STREET EAST, SUITE 101
WATERLOO, ONTARIO N2J 4K8
PHONE (519) 742 3510 FAX (519) 742 3462

EASTRIDGE LANDING
SUBDIVISION PHASE III, IV, V
ARTHUR, ONTARIO

PLAN AND PROFILE
EASTVIEW DRIVE
STA. 1+000 TO STA. 1+120

DESIGN	WDH	SCALE	HOR. 1 : 500	DWG. No.
CHECKED	KJB	DATE	VERT. 1 : 50	PP-4
PROJECT No.	070119	DATE	FEB 2013	

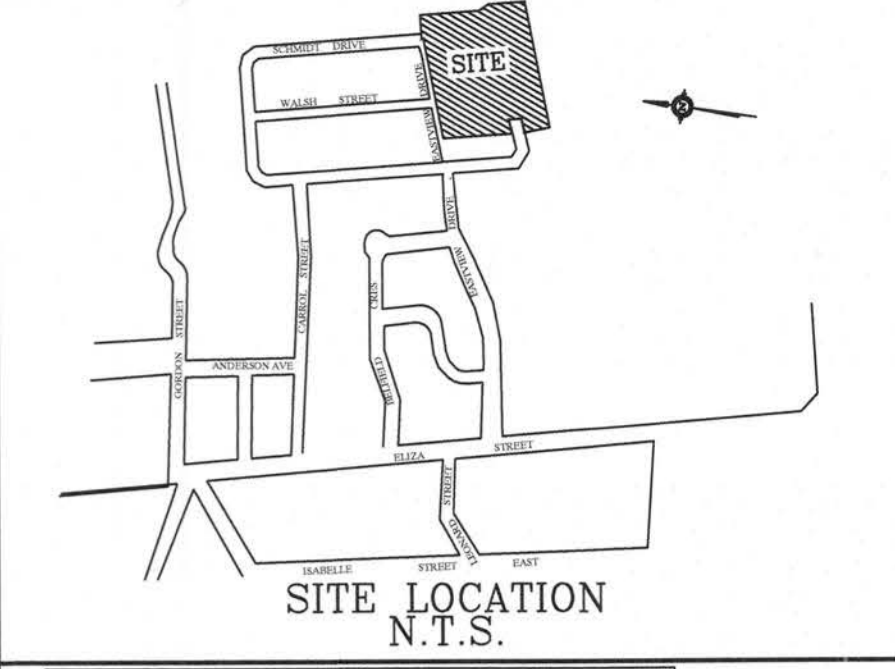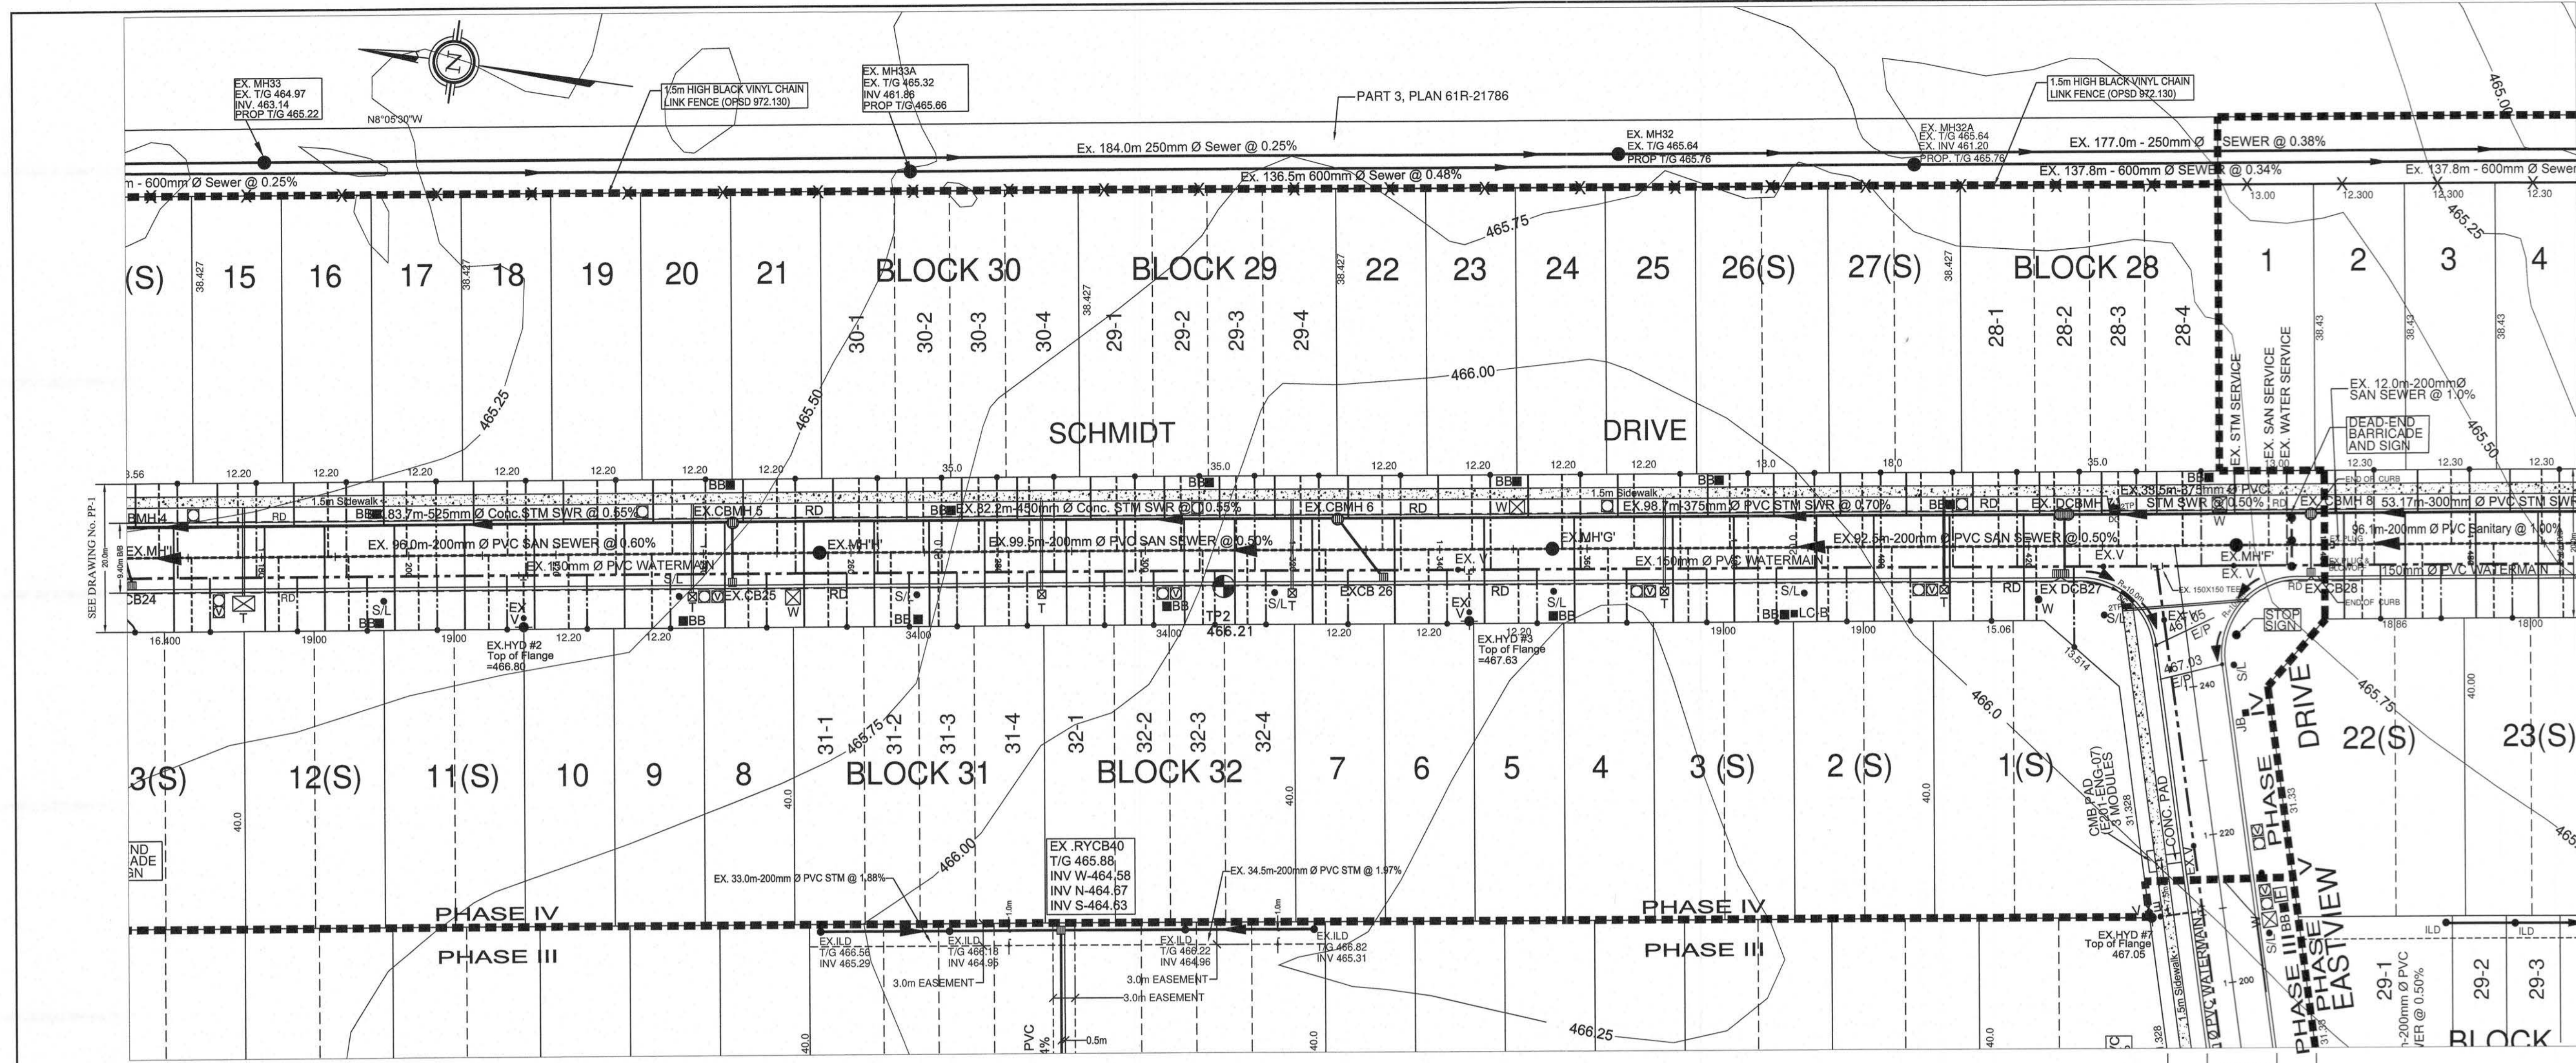

- BENCHMARKS:**
1. TOP OF STORM MANHOLE IN BOULEVARD AT SOUTHWEST CORNER OF ELIZA STREET AND GORDON STREET ELEV 462.31
 2. TOP OF SANITARY MANHOLE IN CUL-DE-SAC ON FARREL STREET, ELEV 462.31
 3. TOP OF SANITARY MANHOLE AT EXISTING EAST LIMIT OF EASTVIEW AVENUE, ELEV 464.27

- NOTES:**
1. 150mm Watermain shall be CPVC Class 150 (DR18), B137.3 with Ring-Tite joints and Tracer Wire. Tracer Wire shall be 12 gauge, 7 strand copper with plastic coating and shall be connected to the storm pumper connection. Watermains and services shall be installed to the storm pumper connection finished grade above the main or service in sand bedding per OPSD 1001.
 2. Watermain fittings - ductile iron mechanical joint/AWWA C110 approved, pressure rating 1035 kPa.
 3. Watermain shall be Mueller Wedge Gate Valve per AWWA C-509, Mechanical Joint. Valve extensions to be provided where required.
 4. Watermain Novaloc shall be W83200, 3 piece No.6 round base screw type as manufactured by BBSB-ST CROX FOUNDRIES INC., Cambridge, Ontario.
 5. Hydrants shall be Century Type Compression with "Stora" pumper connection. All hydrants to be painted red with black "Stora" cap.
 6. Water services to be 25mm single pass pipe.
 7. Anodes: 12" x 2 1/2" x 1/4" gal shall be installed on all connections to existing iron watermains.
 8. 12" x 2 1/2" x 1/4" gal shall be installed on all iron fittings, valves, main stops, curb stops, etc.
 9. Main stops, curb stops, unions, service boxes and restraints shall be in accordance with the Township of Wellington North Specifications.
 10. Sanitary sewer shall be 200mm PVC-SDR35 meeting the current ASTM D3034 Specifications and CSA-182.2.
 11. Sanitary services shall be 150mm PVC-SDR35 meeting the current CSA-182.2 Specifications. Service connections to be of a minimum grade C200. All connections to flow masts shall have manufactured steel all new connections to existing mains shall use stainless steel straps and saddles or Kor-N-Tee.
 12. Sanitary sewer manhole fittings shall be PVC-SDR35 meeting the current ASTM D3034 Specifications and CSA B12.4.
 13. Storm sewers 375mm and less shall be either Concrete (reinforced) or PVC (Ultra-Rib) - 1822-A. Storm sewers greater than 375mm shall be concrete (reinforced).
 14. All storm services shall be 100mm PVC-SDR35 and connected to manhole with predrilled tee or "Kor-N-Tee", minimum 1% gradient.
 15. All catchbasin heads (250mm Single, 300mm Double) shall be PVC-SDR35. Sideroad leads to rear yard catchbasins to be PVC SDR 35 with minimum 1% gradient and 1.2m of cover. Bedding per OPSD 802.01 and 802.03.
 16. All sewer pipes and watermains to be installed in Class 'B'.
 17. Concrete Curbs and sidewalks shall be poured using 32Mpa strength @ 28 days.
 18. All watermains and sewers to be tested in accordance with Township of Wellington North Specifications or as noted in the Contract Documents.
 19. Concrete Curb to be mountable as per OPSD 600.10 and Barrier curb as per OPSD 600.04.
 20. Water Service Boxes to be located at streetline and not in driveways, if possible.
 21. Sump Pumps to discharge to storm services.
 22. Driveways shall be:
 - 450mm Granular 'A'
 - 50mm H.C.C Modified Fine Asphalt
 23. All structures shall allow for an adjustment of between 150mm-200mm with modular joints. All external joints shall be wrapped with 150mm Densotape or equivalent.
 24. This plan shall be read in conjunction with Drawing EPC Erosion Control Plan.
 25. Road Section to be in accordance with Township Standard Drawing R1 (see section Drawing DE-1).
 26. Traffic Warning - Plates shall be installed at sidewalk of curb intersections as per OPSD 310.039 and OPSD 310.033.
 27. Sidewalk ramps at curb intersections shall be 8% maximum gradient.
 28. Where storm services and water services conflict with manhole pipes, storm services to go over watermain and water services to go under storm sewer with 2.5m clearance.
 29. All catchbasin manholes to have 300mm deep sump. All roadside catchbasins to have 600mm deep sump. No sumps in progress catchbasins and all catchbasins to have approved granular material, then Road Drains (RD) to be 8.0m of 150mm geotextile wrapped perforated material and 40mm of 150mm geotextile wrapped manholes and in both directions in the sump in the road. Subdrains to be 1/2" Dia 1000' approved equipment. If storm sewer is backfilled with native soils, a continuous 150mm x subdrain to be provided along curbline.
 30. All catchbasin manholes to have 300mm deep sump. All roadside catchbasins to have 600mm deep sump. No sumps in progress catchbasins and all catchbasins to have approved granular material, then Road Drains (RD) to be 8.0m of 150mm geotextile wrapped perforated material and 40mm of 150mm geotextile wrapped manholes and in both directions in the sump in the road. Subdrains to be 1/2" Dia 1000' approved equipment. If storm sewer is backfilled with native soils, a continuous 150mm x subdrain to be provided along curbline.



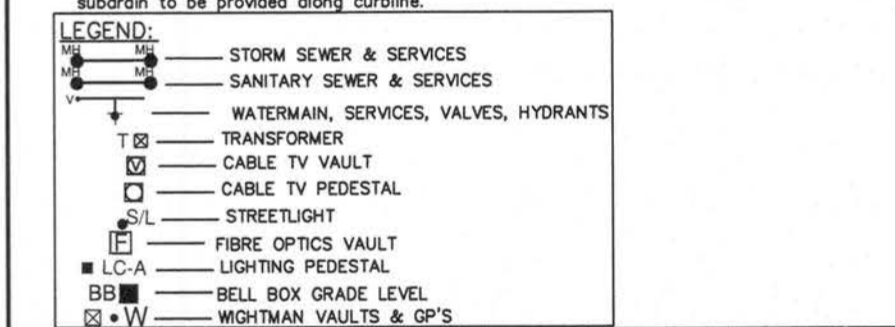


Table with 4 columns: No., DESCRIPTION, DATE, INTL. (as shown in the profile view table above).

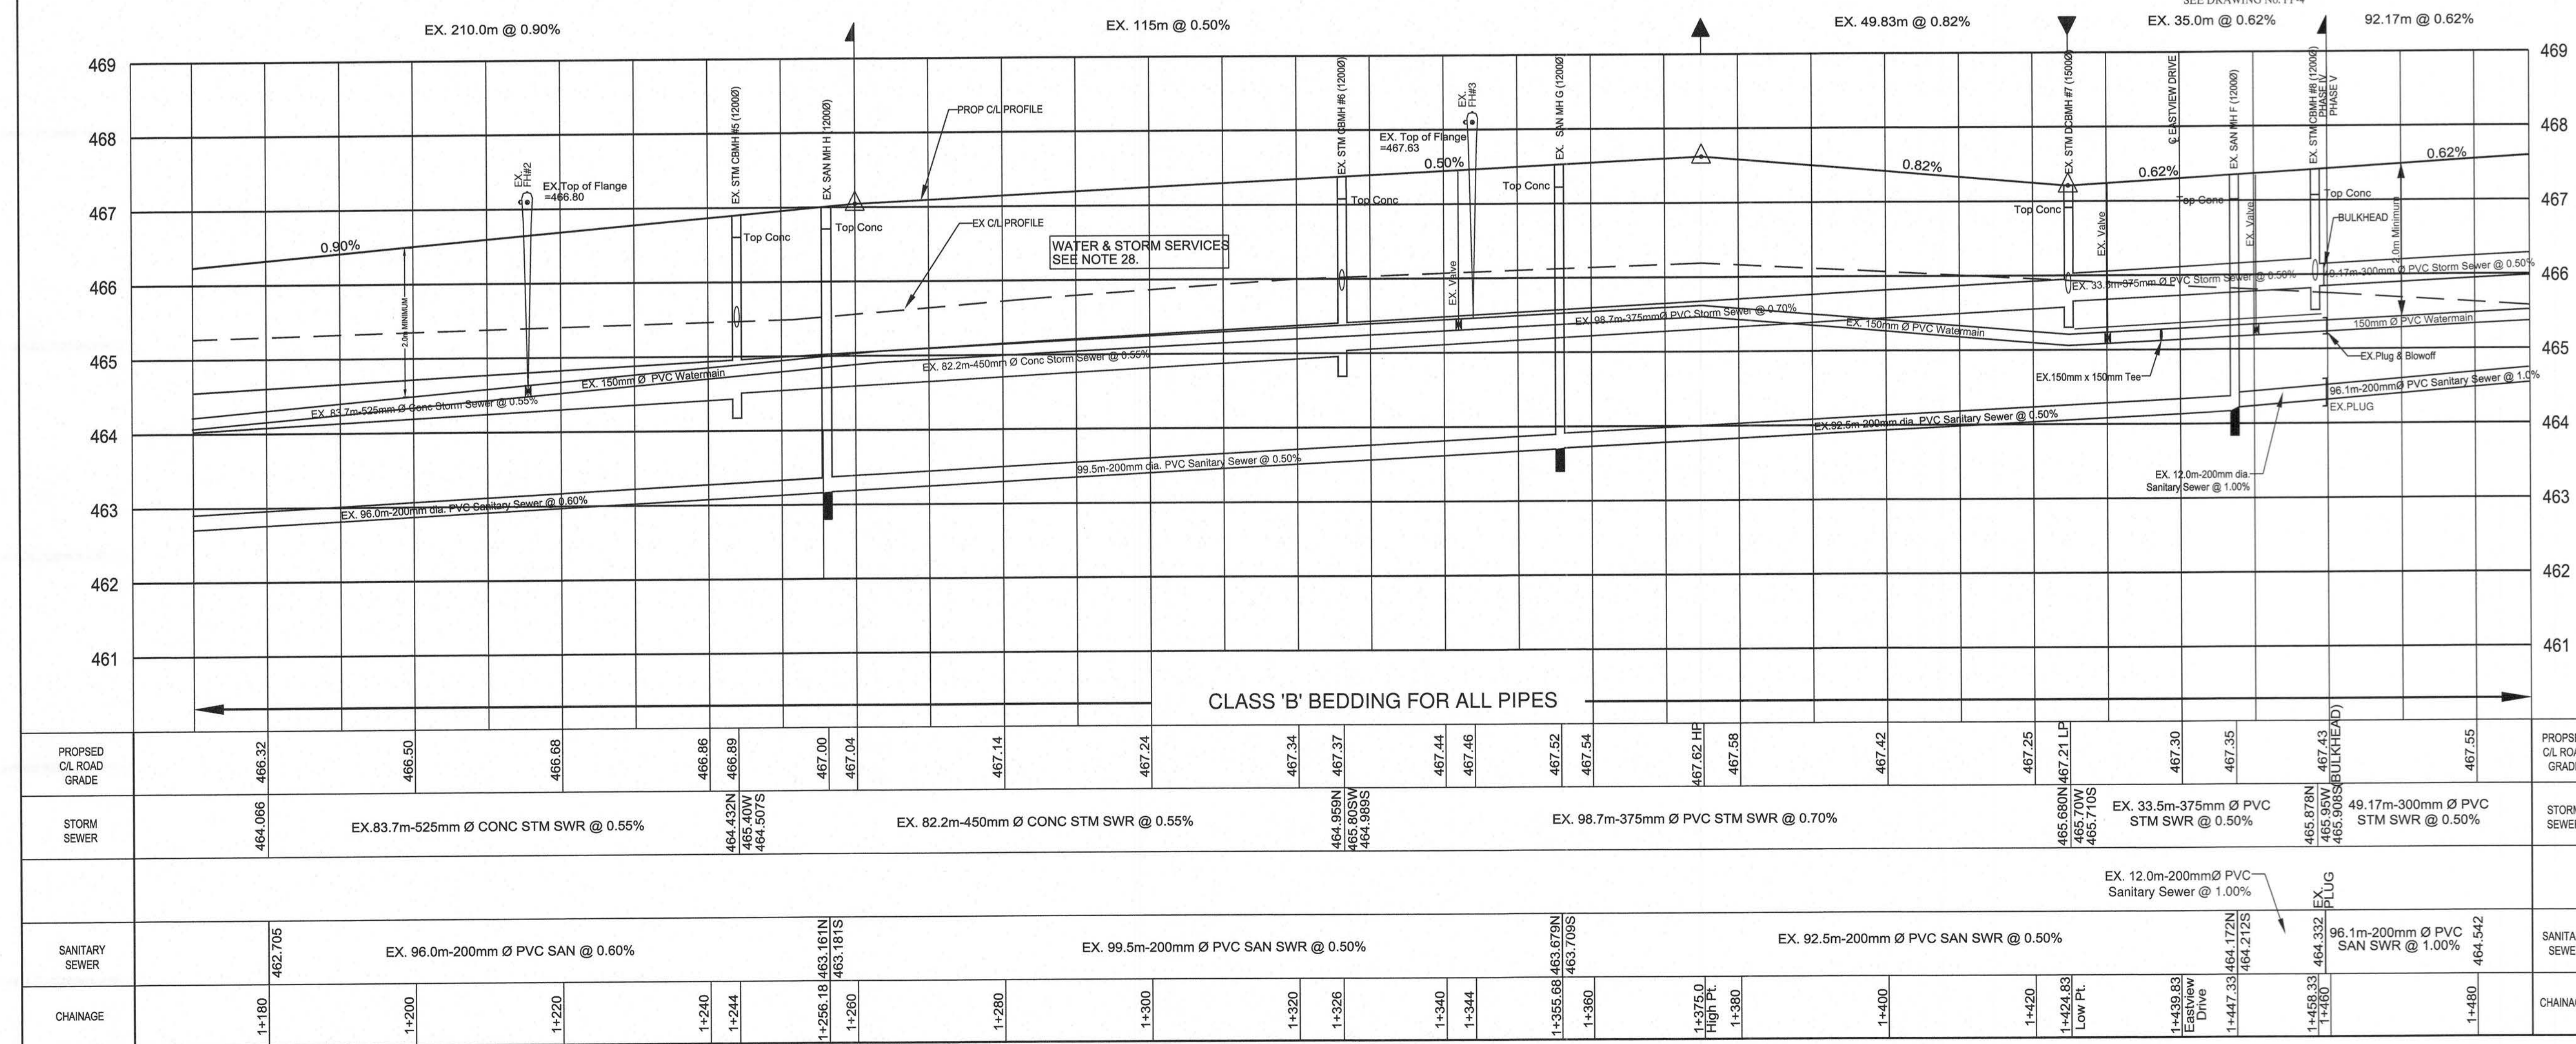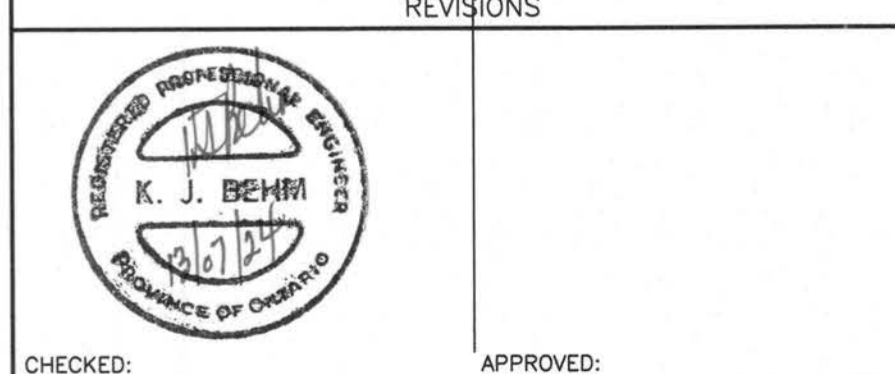



CHECKED: [Signature] APPROVED: [Signature]

K. J. BEHM AND ASSOCIATES INC.
 CONSULTING ENGINEERS
 55 ERS STREET EAST, SUITE 101
 WATERLOO, ONTARIO N2J 4K8
 PHONE (519) 742 3510 FAX (519) 742 3462

EASTRIDGE LANDING
SUBDIVISION PHASE III, IV, V
 ARTHUR, ONTARIO


PLAN AND PROFILE
SCHMIDT DRIVE
STA. 1+180 TO STA. 1+480

DRAWN: WDH SCALE: HOR: 1:500 DWG. No.: PP-5
 DESIGN: KJB VERT: 1:500
 CHECKED: KJB DATE: FEB 2013
 PROJECT No.: 070119

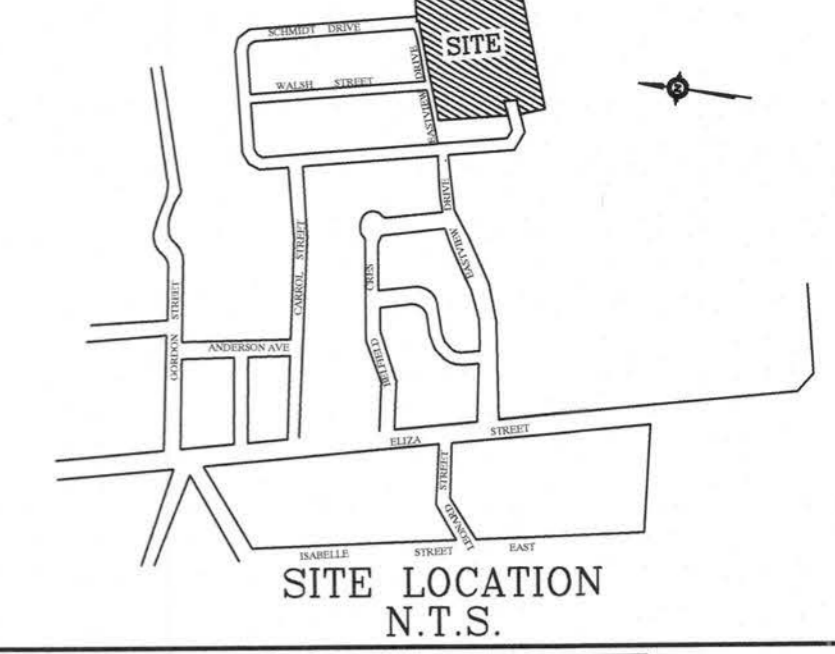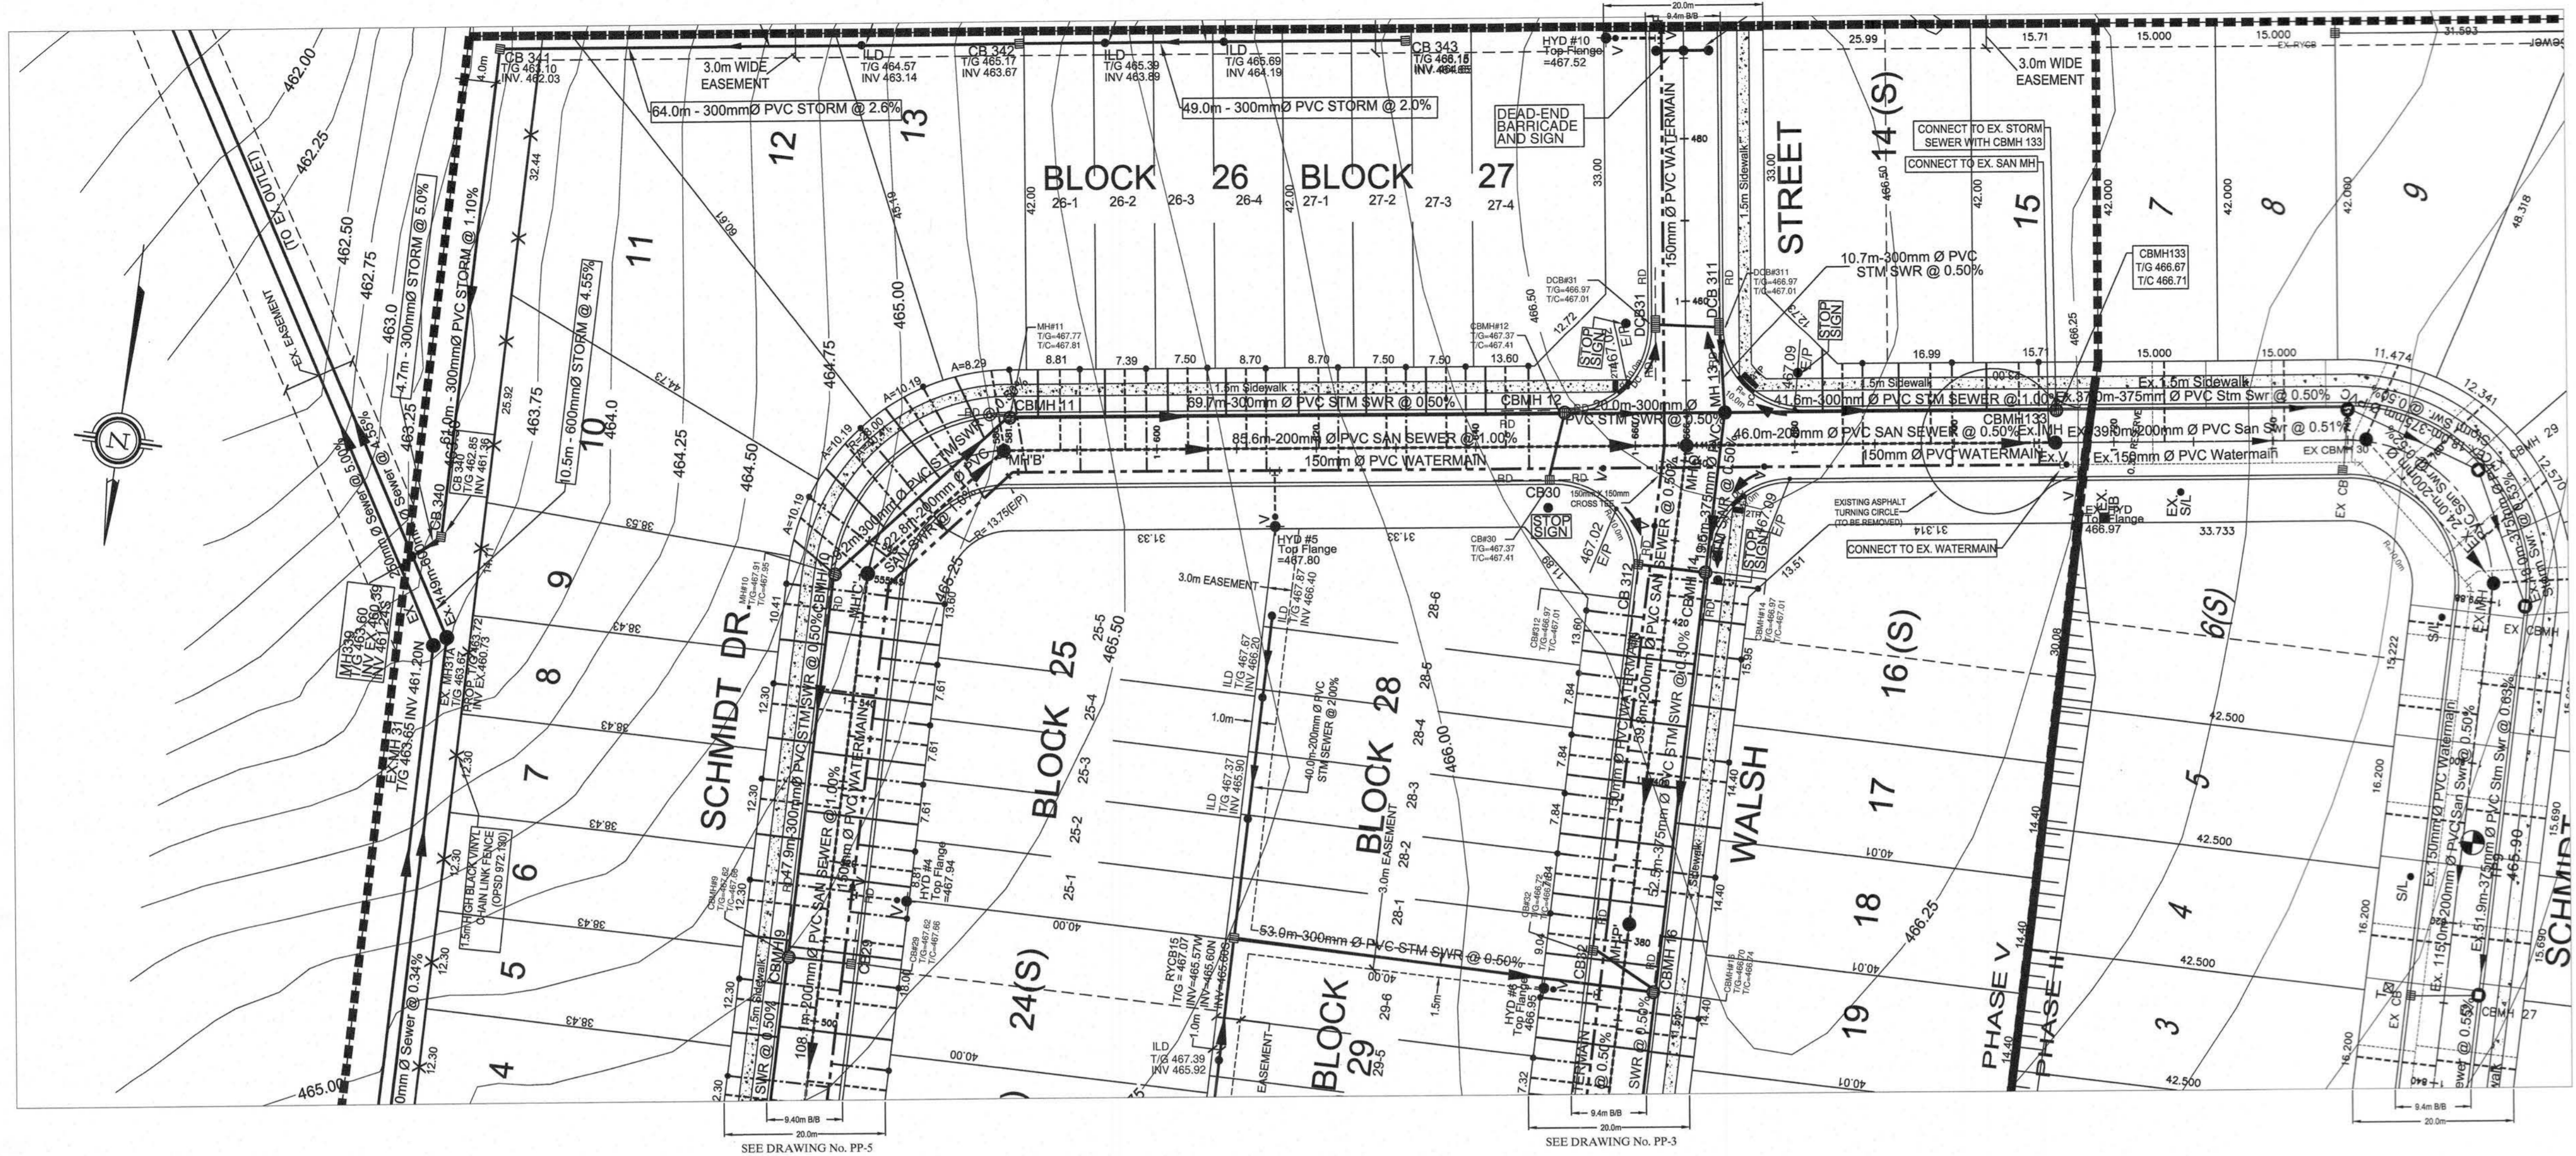

- BENCH MARKS:**
1. TOP OF STORM MANHOLE IN BOULEVARD AT SOUTHWEST CORNER OF ELIZA STREET AND GORDON STREET ELEV 462.03
 2. TOP OF SANITARY MANHOLE IN CUL-DE-SAC ON FARREL STREET. ELEV 462.31
 3. TOP OF SANITARY MANHOLE AT EXISTING EAST LIMIT OF EASTVIEW AVENUE. ELEV 464.27

- NOTES:**
1. 150mm Watermain shall be 2000 PVC Class 150 (R18), B137.3 with Ring-Tite joints and Tracer Wire. Tracer Wire shall be 12 gauge, 7 strand copper with plastic coating and shall be connected to the storm pump connection. Watermain and services shall be installed minimum 2.0 m below finished grade above the main or service in sand bedding per OPSS 1001.
 2. Watermain fittings - ductile iron mechanical joint (AWWA C110 approved, pressure rating 1033 kPa).
 3. Watermain valves shall be Mueller Wedge Gate Valve per AWWA C-509, Mechanical joint. Valve extensions to be provided where required.
 4. Watermain Valve Boxes shall be W8300, 3 piece No.6 round base type as manufactured by BBS-ST CROWN FOUNDRIES INC., Cambridge, Ontario.
 5. Hydrants shall be Corrado Valve Century Vigs Compression with "Storz" pumper connection. All hydrants to be painted red with black "Storz" cap.
 6. Water services to be 25mm single pex pipe.
 7. Anodes: DZP-24, 10.9 kg shall be installed on all iron fittings, valves, main stops, curb stops, etc.
 8. Main stops, curb stops, unions, service boxes and restraints shall be in accordance with the Township of Wellington North Specifications.
 9. Sanitary sewer shall be 200mm PVC-SDR35 meeting the current ASTM D3034 Specifications and CSA-B182.2.
 10. Sanitary Services shall be 120mm PVC-SDR35 meeting the current CSA-B182.2 Specifications. Service connections to be of a minimum grade of 2%. All connections to new mains shall have manufactured tees. All new connections to existing mains shall use stainless steel straps and saddles or Kor-N-Tee.
 11. Sanitary sewer manhole fittings shall be PVC-SDR35 meeting the current ASTM D3034-73 Specifications and CSA B182.4.
 12. Storm sewers 375mm and less shall be either Concrete (reinforced) or PVC Ultra-Rib, as per CSA-B182.4. Storm sewers greater than 375mm shall be concrete (reinforced).
 13. All storm services shall be 100mm PVC-SDR28 and connected to manhole with pretensioned tee or "Kor-N-Tee", minimum 1% gradient.
 14. All catchbasin leads (250mm Single, 300mm Double) shall be PVC-SDR35. Sideload leads to roadway catchbasins to be PVC SDR 35 with minimum 1% gradient and 1.2m of cover.
 15. All sewer pipes and watermain to be installed in Class "B" Bedding per OPSS 800.01 and 802.03.
 16. Pavement design for all roads shall be: 450mm Granular "B" road base, 150mm Granular "A" road base, 50mm H-4 Binder Course Asphalt, 40mm H-3 Surface Course Asphalt, 90mm TOTAL DEPTH.
 17. Concrete Curbs and sidewalks shall be poured using 32Mpa strength @ 28 days.
 18. All watermain and sewers to be laid in accordance with Township of Wellington North Specifications or as noted in the Contract Documents.
 19. Concrete Curb to be mountable as per OPSS 600.10 and Barrier curb as per OPSS 600.04.
 20. Water Service Boxes to be located at streetline and not in driveways, if possible.
 21. Sump Pumps to discharge to storm services.
 22. Driveways shall be: 450mm Granular "B", 150mm Granular "A", 50mm H-3 Modified Fine Asphalt.
 23. All structures shall allow for an adjustment of between 150mm-300mm with music. All exterior joints shall be wrapped with 150mm Densotape or equivalent.
 24. This plan shall be read in conjunction with Drawing EPC Erosion Control Plan.
 25. Road Section to be in accordance with Township Standard Drawing R1 (see section Drawing 301-1).
 26. Traffic Warning Plates shall be installed in sidewalk at curb intersections as per OPSS 310.03P and OPSS 310.03S.
 27. Sidewalk ramps at curb intersections shall be 8% maximum gradient.
 28. Where storm services and water services conflict with manhole pipes, storm services to go over watermain and water services to go under storm sewer with 0.5m clearance.
 29. All catchbasin manholes to have 300mm deep sump. All roadside catchbasins to have 600mm deep sump. No sumps in roadway catchbasins.
 30. Where storm sewer runs along curb line and has been backfilled with approved granular material, then Road Drains (RD) to be 6.0m of 150mm geotextile wrapped perforated sumpdrain required upstream of all catchbasins and roadway manholes and in both directions in the area in the road. Subdrains to be Big "D" Boxes 1000 or approved equivalent. If storm sewer is backfilled with native soils, a continuous 150mm x subdrain to be provided along curbline.

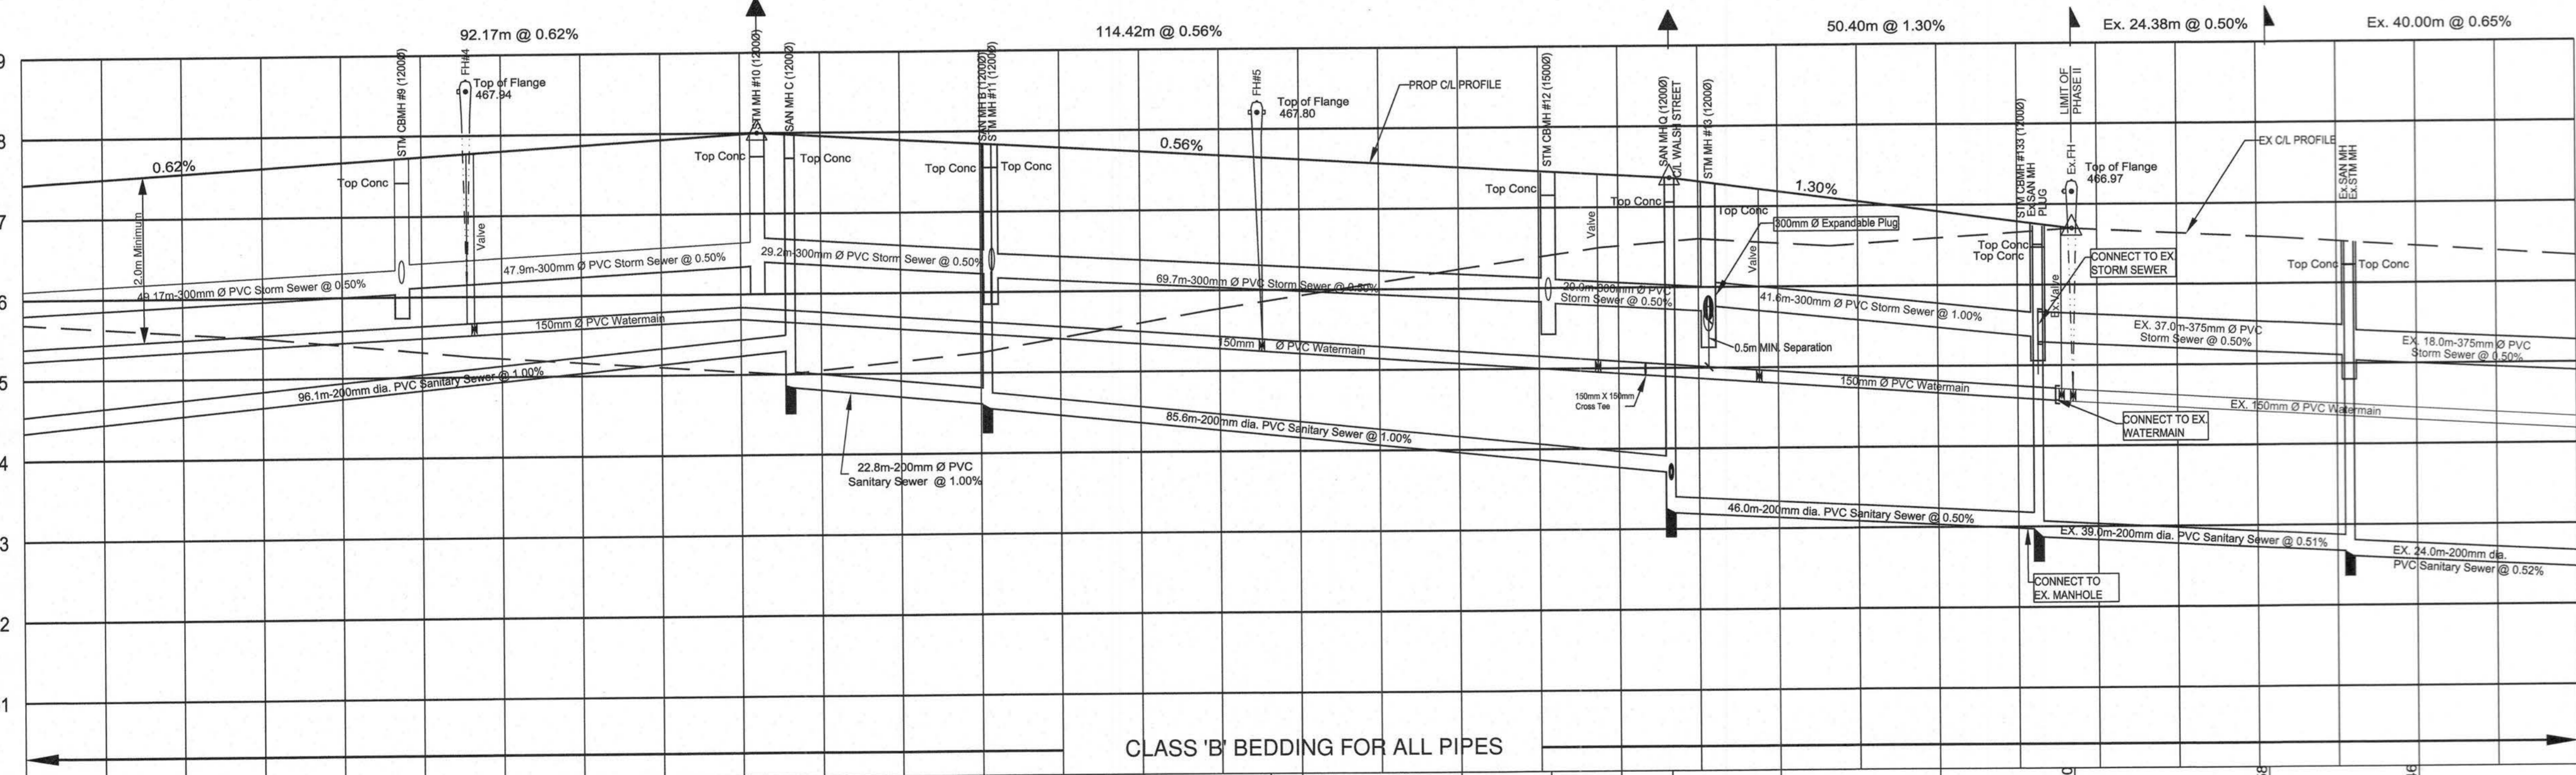

REVISIONS

No.	DESCRIPTION	DATE	INTL.
13	PIPE MATERIALS ADDED	26/01/23	KJB
12	GENERAL REVISIONS	06/11/22	KJB
11	LOT NUMBERING CHANGED FOR PHASE IV	20/12/21	KJB
10	STORM SEWER REMOVED LOTS 16-21	06/06/21	KJB
9	GENERAL REVISIONS	15/02/21	KJB
8	AS-CONSTRUCTED U/G SERVICES PHASES III, IV, V	28/12/20	KJB
7	GENERAL REVISIONS	22/06/20	KJB
6	GENERAL REVISIONS	15/03/20	KJB
5	GENERAL REVISIONS	19/05/19	KJB
4	GENERAL REVISIONS	07/01/19	KJB
3	GENERAL REVISIONS	30/11/18	KJB
2	GENERAL REVISIONS	22/02/18	KJB
1	GENERAL REVISIONS	02/11/17	KJB




CHECKED: K. J. BEHM AND ASSOCIATES INC. CONSULTING ENGINEERS
 55 ERS STREET EAST, SUITE 101
 WATERLOO, ONTARIO N2L 4K8
 PHONE (519) 742 3510 FAX (519) 742 3462

**EASTRIDGE LANDING
 SUBDIVISION PHASE III, IV, V
 ARTHUR, ONTARIO**

**PLAN AND PROFILE
 SCHMIDT DRIVE
 STA. 1+480 TO STA. 1+720**


DESIGN	WDH	SCALE	HOR: 1 : 500	DWG. No.
CHECKED	KJB	DATE	VERT: 1 : 30	PP-6
PROJECT No.	070119		FEB 2013	

PROPOSED CL ROAD GRADE	STORM SEWER	SANITARY SEWER	CHAINAGE
467.55	49.17m-300mm Ø PVC STM SWR @ 0.50%	96.1m-200mm Ø PVC SAN SWR @ 1.00%	1+480
467.67	47.9m-300mm Ø PVC STM SWR @ 0.50%		1+500
467.75			1+507.53
467.80			1+511.50
467.92			1+520
468.00 HF			1+540
468.00 HF			1+562.0
468.401SW	29.2m-300mm Ø PVC STM SWR @ 0.50%	22.8m-200mm Ø PVC SAN SWR @ 1.00%	1+565.45
468.97			1+564.834SW
468.97			1+560
468.256NE			1+580
466.175W			1+580.50/464.556W
467.86			1+600
467.75	69.7m-300mm Ø PVC STM SWR @ 0.50%	85.6m-200mm Ø PVC SAN SWR @ 1.00%	1+616.0
467.86			1+620
467.64			1+651.42
467.53			1+660
467.46	20.0m-300mm Ø PVC STM SWR @ 0.50%		1+666.42
467.41			1+671.42
467.38			1+680
(PLUG)			1+682.870 EX W Limit
467.18	41.6m-300mm Ø PVC STM SWR @ 1.00%	46.0m-200mm Ø PVC SAN SWR @ 0.50%	1+712.42
466.92			1+716.82
466.92			1+740
466.56	EX. 37.0m-375mm Ø PVC STM SWR @ 0.50%	EX. 39.0m-200mm Ø PVC SAN SWR @ 0.51%	1+751.42
466.56			1+760
466.15 E	EX. 18.0m-375mm Ø PVC STM SWR @ 0.50%		1+770
465.09 W			

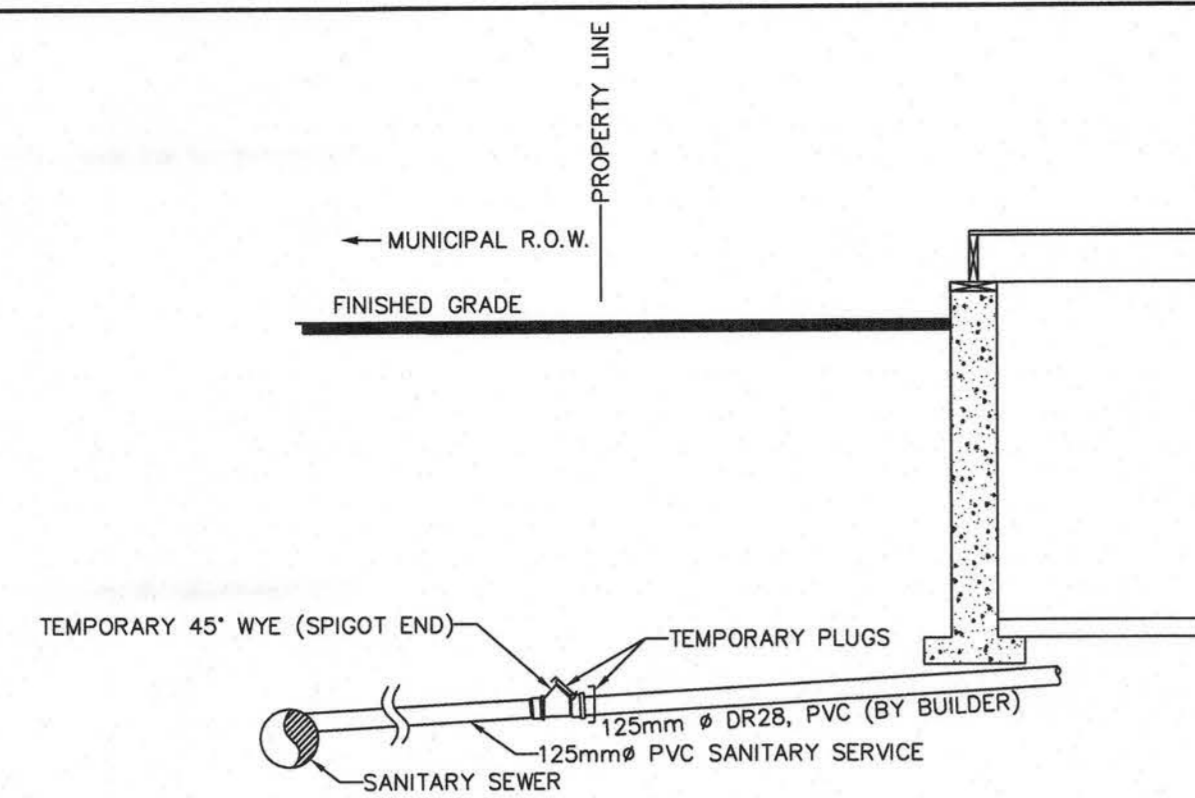


SANITARY SERVICE CONNECTION

STD S3
NTS

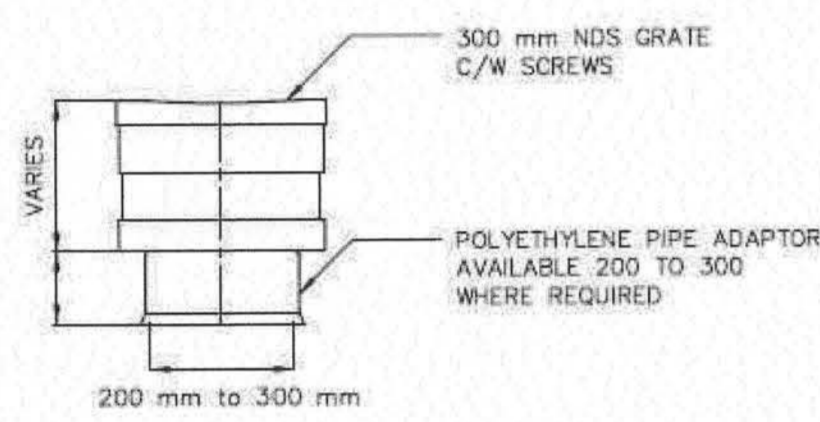


ADAPTOR DETAIL

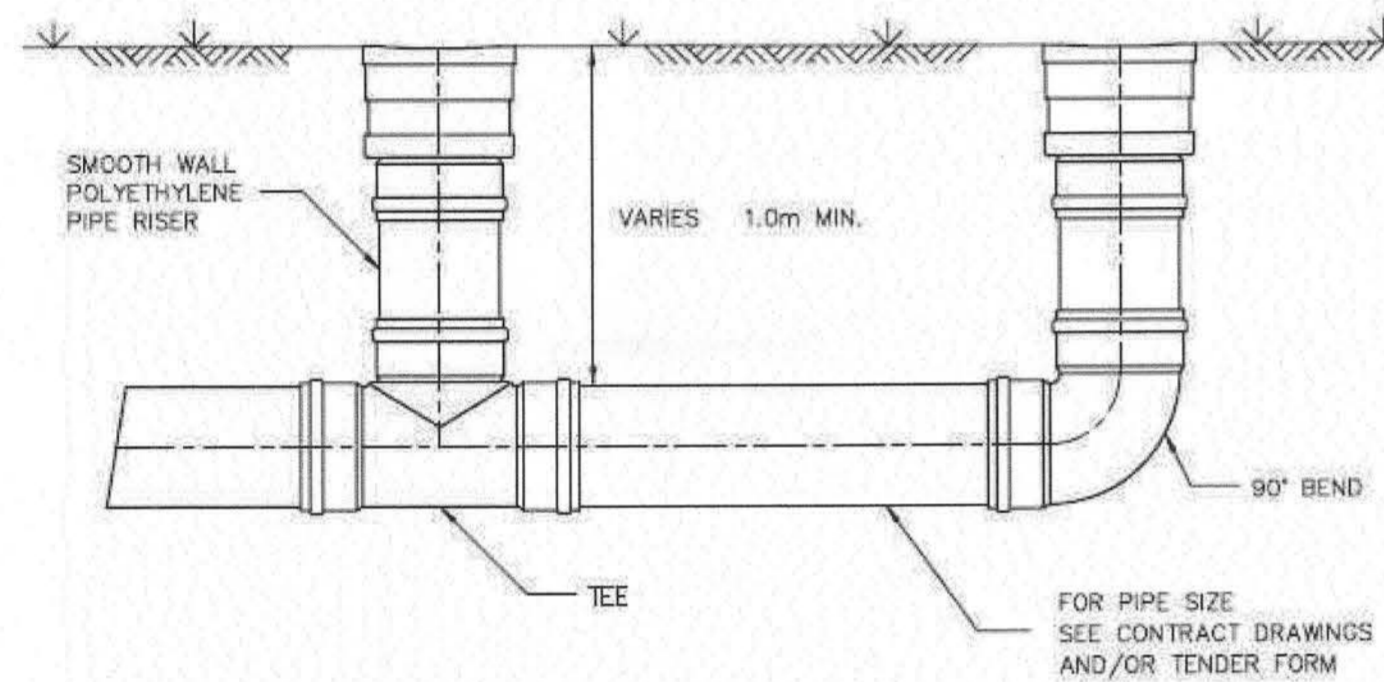


POLYETHYLENE INLINE CATCH BASIN

NTS

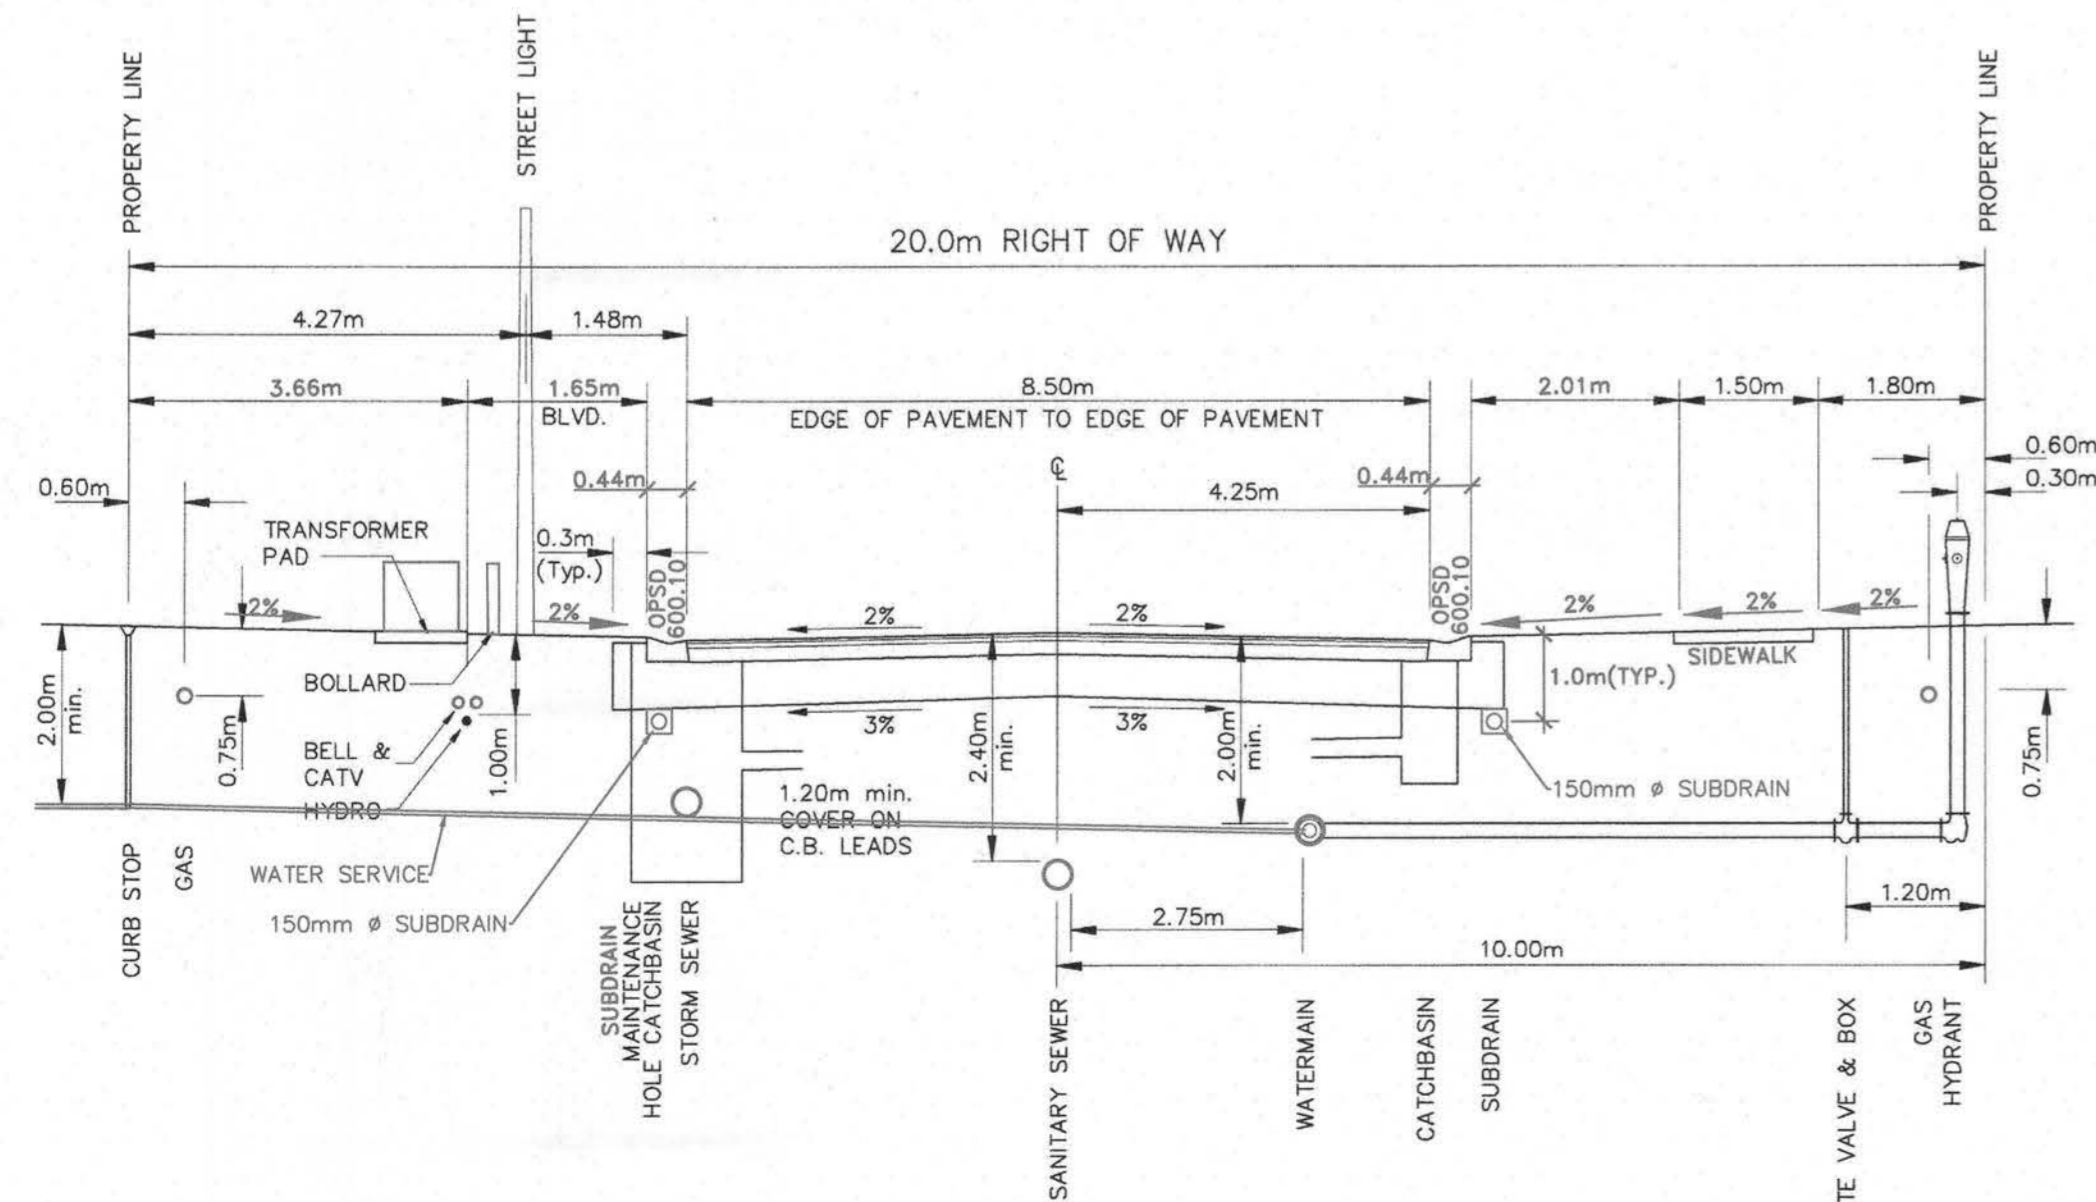


TYPICAL ROAD SECTION

NTS

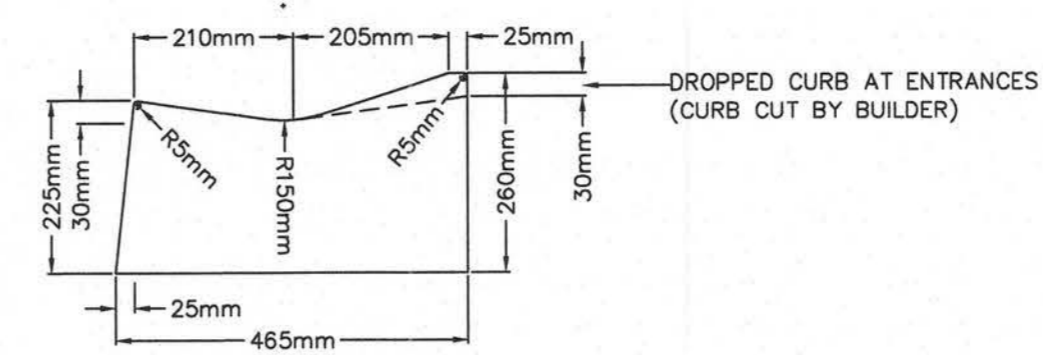


CURB AND GUTTER (OPSD 600.100)

N.T.S.

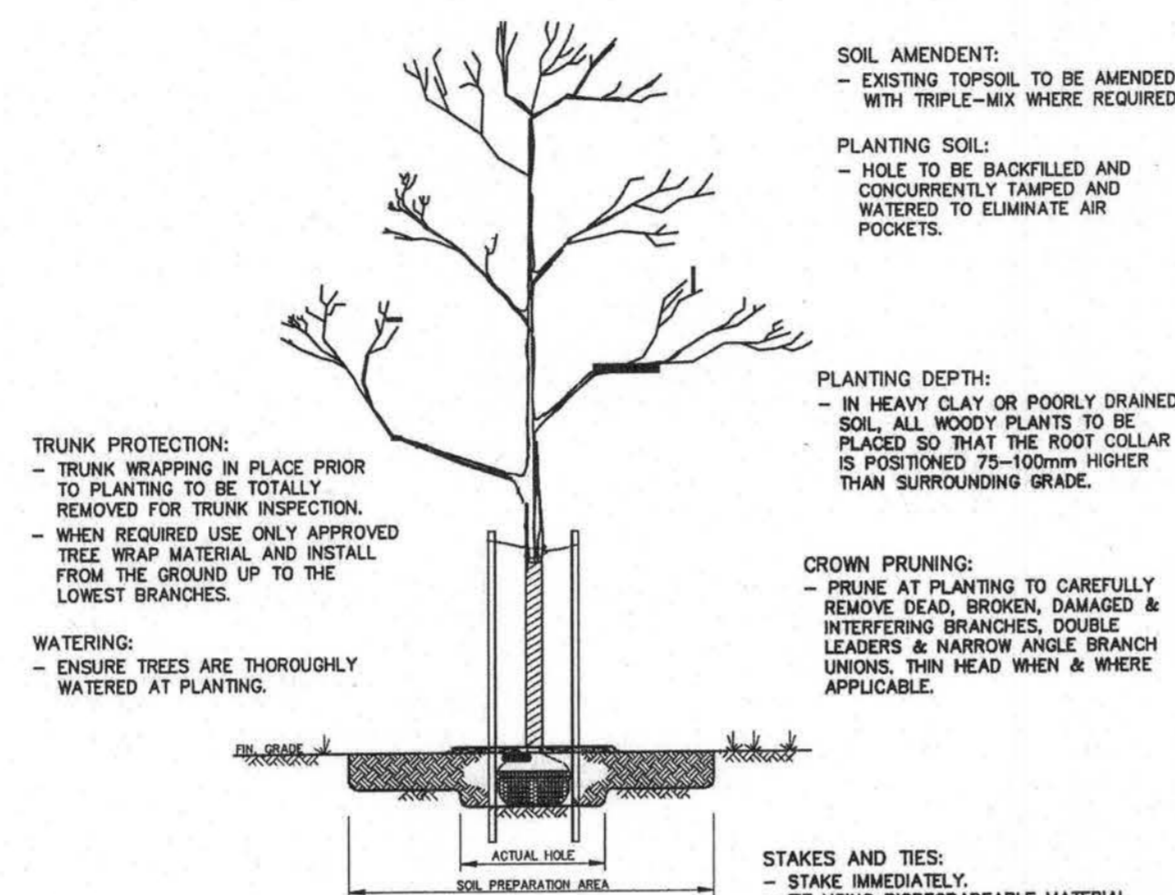

DECIDUOUS TREE PLANTING DETAIL

NTS

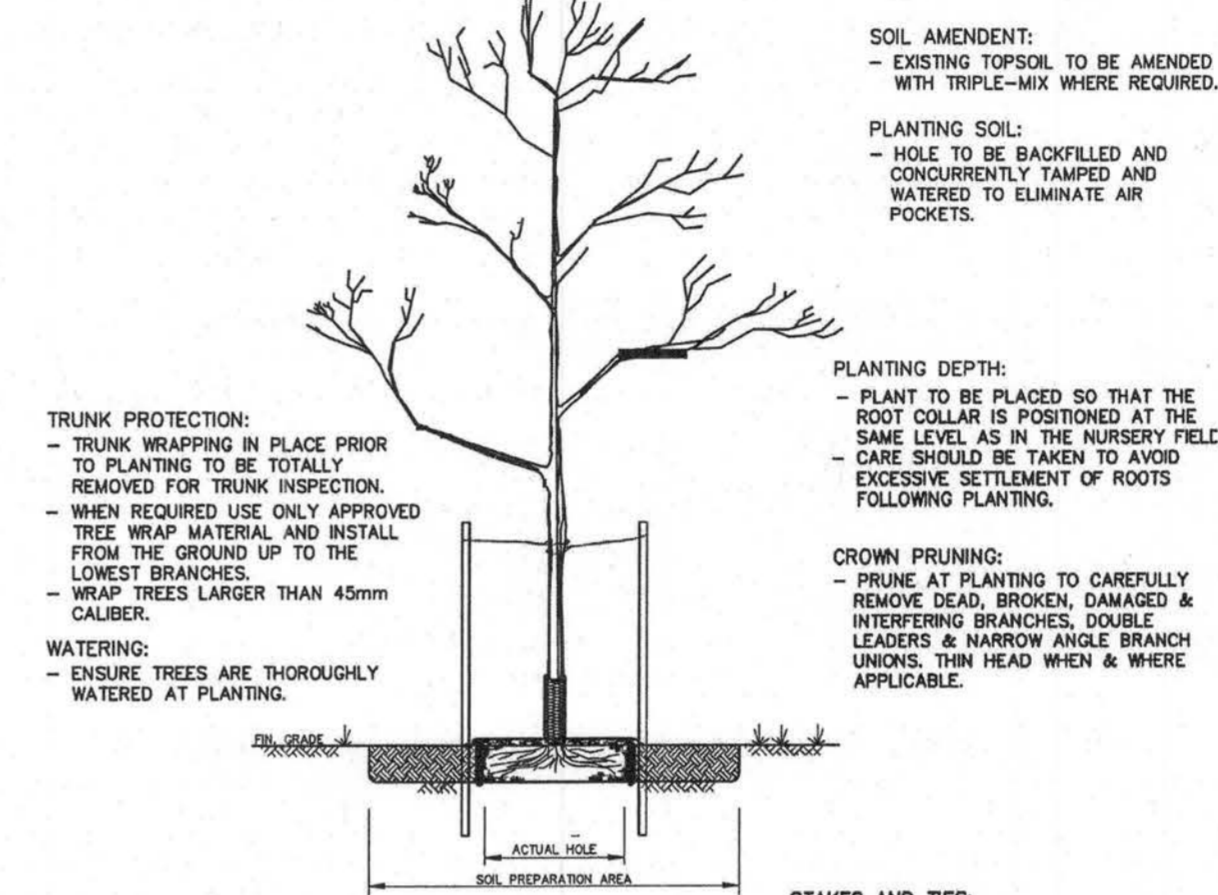

BARE-ROOT PLANTING DETAIL

NTS

- NOTES:
- PAVEMENT DESIGN
 - 450mm GRANULAR 'B' ROAD BASE
 - 150mm GRANULAR 'A' ROAD BASE
 - 50mm HL4 BINDER COURSE ASPHALT
 - 40mm HL3 SURFACE COURSE ASPHALT
 - 690mm TOTAL DEPTH
 - CONCRETE CURB & GUTTER- OPSD 600.10 (MOUNTABLE), OPSD 600.04 (BARRIER)
 - WHERE LOT SERVICES CONFLICT WITH STORM SEWERS AND WATERMANS, STORM SERVICES SHALL BE PLACED UNDER WATERMAIN, AND WATER SERVICES SHALL BE PLACED OVER STORM SEWER WITH MINIMUM 0.5m CLEARANCE.
 - WHERE UTILITY CABLES/MAINS CONFLICT WITH STORM SEWERS, UTILITIES SHALL BE INSTALLED UNDER STORM SEWERS.
 - CONCRETE SIDEWALKS TO BE 150MM THICKNESS, 32 MPa AT 30 DAYS, INCLUDING 150MM THICKNESS OF GRANULAR 'A' BEDDING COMPACTED TO 98% S.P.D.
 - BOULEVARDS TO HAVE MINIMUM 200mm THICKNESS OF TOPSOIL AND No.1 NURSERY SOD.

NOTES:

BOULEVARD TREES:

- Trees shall be planted in front of every lot on Private Property at a location 300 mm from the street Property Line or maximum spacing of 25 m.
- On corner lots a tree shall be planted every 15 m on Private Property the adjacent side yard on the flanking street.
- Trees are to be planted so as not to interfere with other street functions or services when the tree matures. Where it is not possible to conform with the foregoing, the trees shall be planted at locations approved by the Municipality.


- Planting of trees shall be as detailed on Standard Drawing L1 and L2. They shall be watered at time of planting and every two (2) weeks thereafter up to the expiration of the guarantee period. The guarantee period shall be one (1) year from the date of planting and the period for planting shall be Spring and Fall only.

- All trees shall be No. 1 nursery stock, 2.5 m minimum height with a minimum caliper of 60 mm measured 300 mm above ground level.
- All areas for planting shall be stabilized with sod or seed as required, prior to planting of trees.

1.4 Species

- Alternate species shall be provided on all streets. A species list shall be provided and approved for each street, prior to any planting.
- The species that are approved for planting on Municipal property shall include the following:

- Acer Nigrum Black Maple
- Acer Rubrum Red Maple
- Acer Saccharum Sugar Maple
- Aesculus Hippocastanum Common Horse Chestnut
- Phellodendron Amurensis Amur Cork Tree
- Celtis Occidentalis Common Hackberry

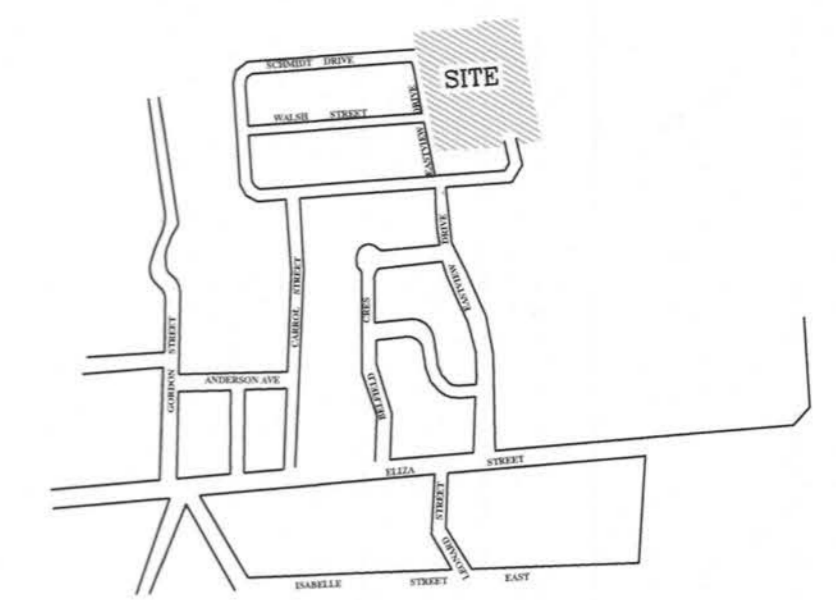

SITE LOCATION
N.T.S.

8	SANITARY SERVICE CONNECTION DETAIL REVISED	26/01/23	KJB
7	GENERAL REVISIONS	22/06/20	KJB
6	NOTE #6 ADDED	15/03/20	KJB
5	GENERAL REVISIONS	19/05/19	KJB
4	GENERAL REVISIONS	01/07/19	KJB
3	GENERAL REVISIONS	30/11/18	KJB
2	GENERAL REVISIONS	02/11/17	KJB
1	GENERAL REVISIONS	14/02/17	KJB
No.	DESCRIPTION	DATE	INTL.







CHECKED: [Signature] APPROVED: [Signature]
K. J. BEHM AND ASSOCIATES INC.
 CONSULTING ENGINEERS
 55 ERB STREET EAST, SUITE 101
 WATERLOO, ONTARIO N2J 4K8
 PHONE: (519) 742-3510 FAX: (519) 742-3462

EASTRIDGE LANDING SUBDIVISION PHASE III, IV, V ARTHUR, ONTARIO


DETAILS PLAN

DRAWN	WDH	SCALE	N.T.S.	DWG. No.
DESIGN	KJB			DET-1
CHECKED	KJB	DATE	APRIL, 2016	
PROJECT No.	070119			

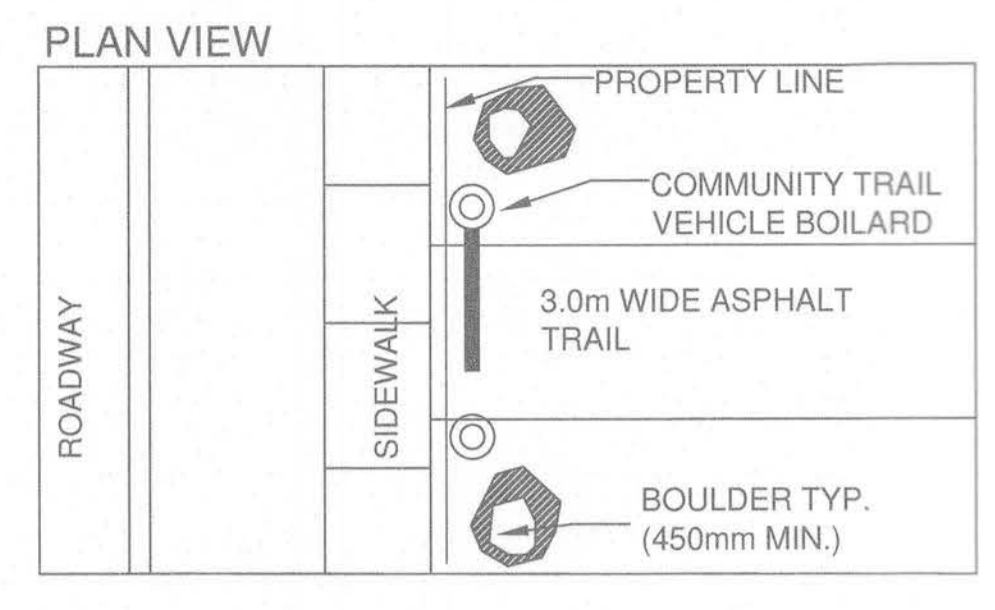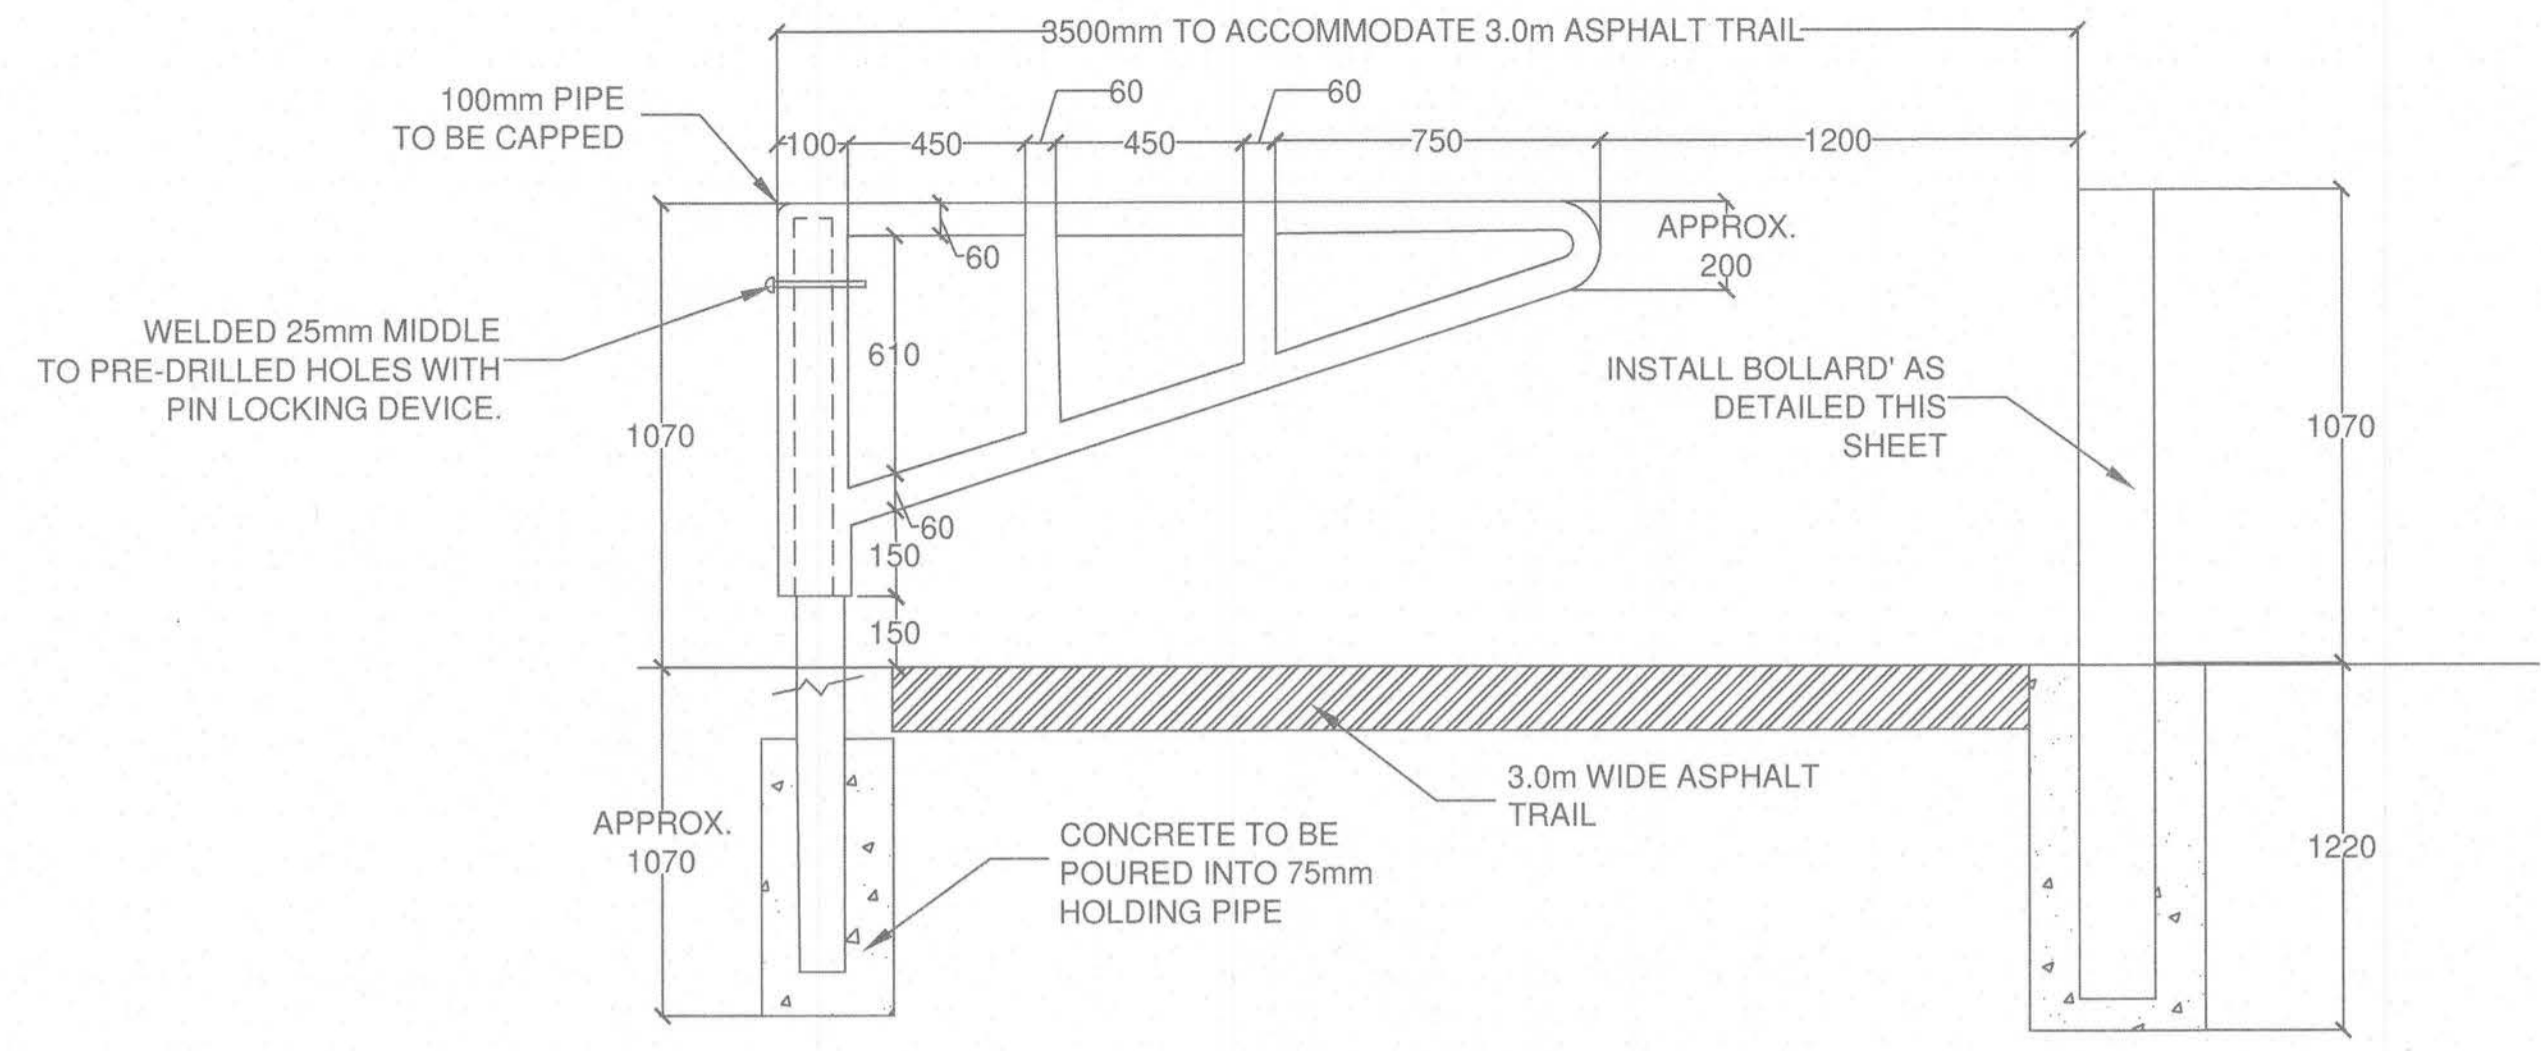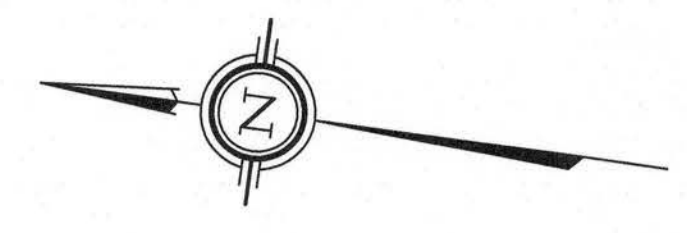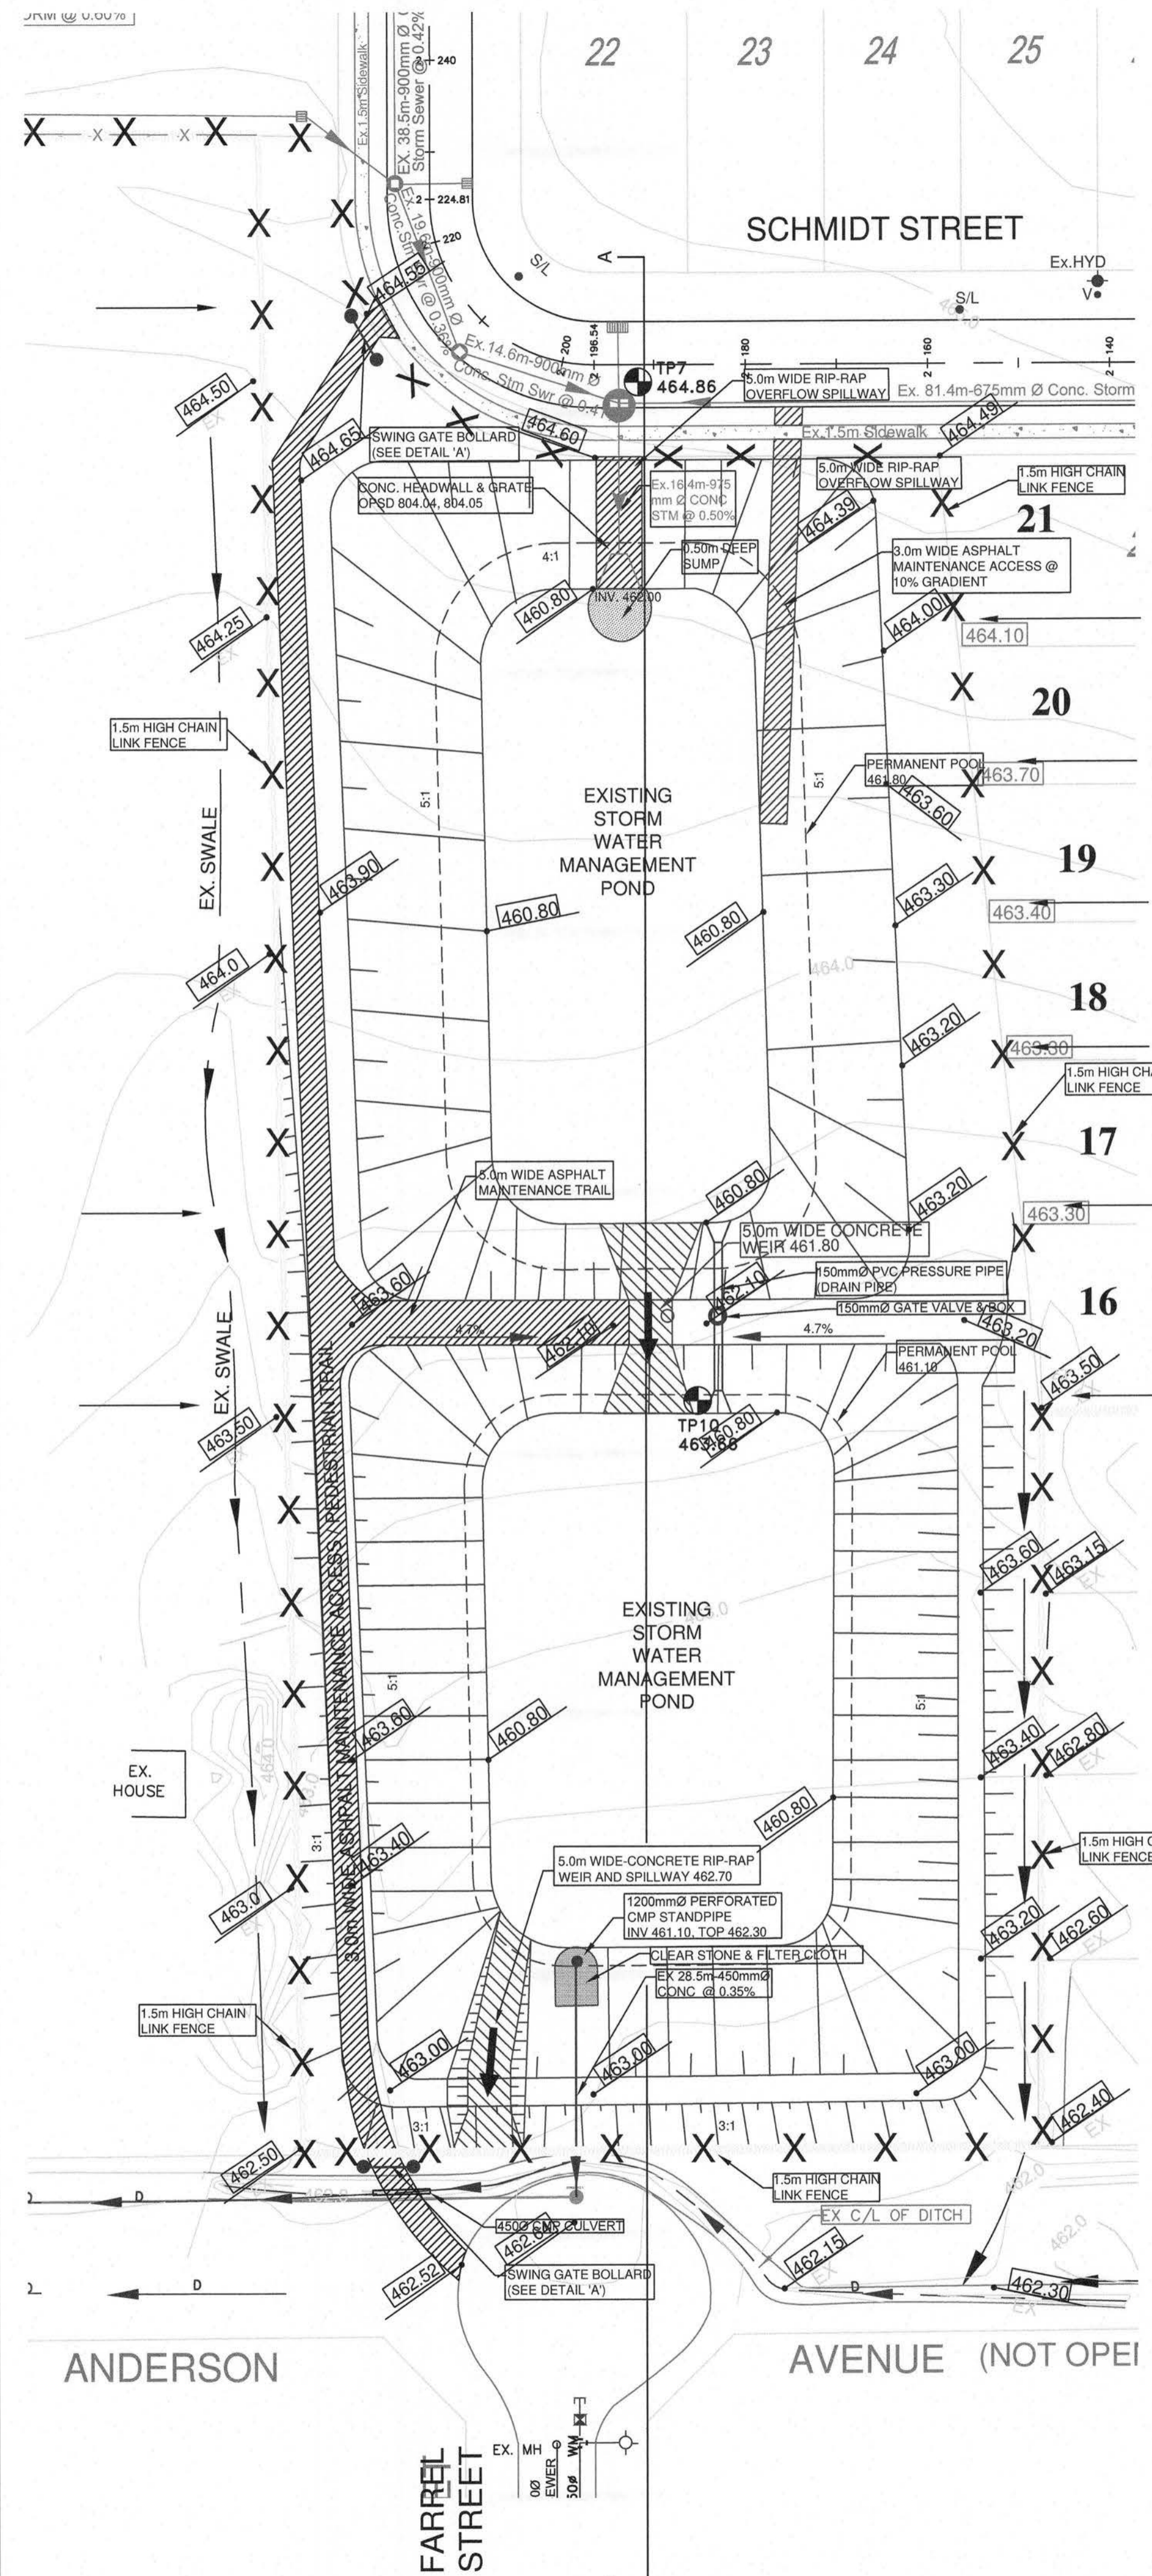


NOTE:
 -GATE RESTS ON 75mm POST SLEEVED INTO 100mm GATE SLEEVE
 -75mm POST FILLED WITH CONCRETE
 -PIPE TO BE GALVANIZED
 -ALL DIMENSIONS HAVE BEEN CONVERTED TO MILLIMETRES.

DETAIL 'A' COMMUNITY TRAIL VEHICLE BOLLARD N.T.S.

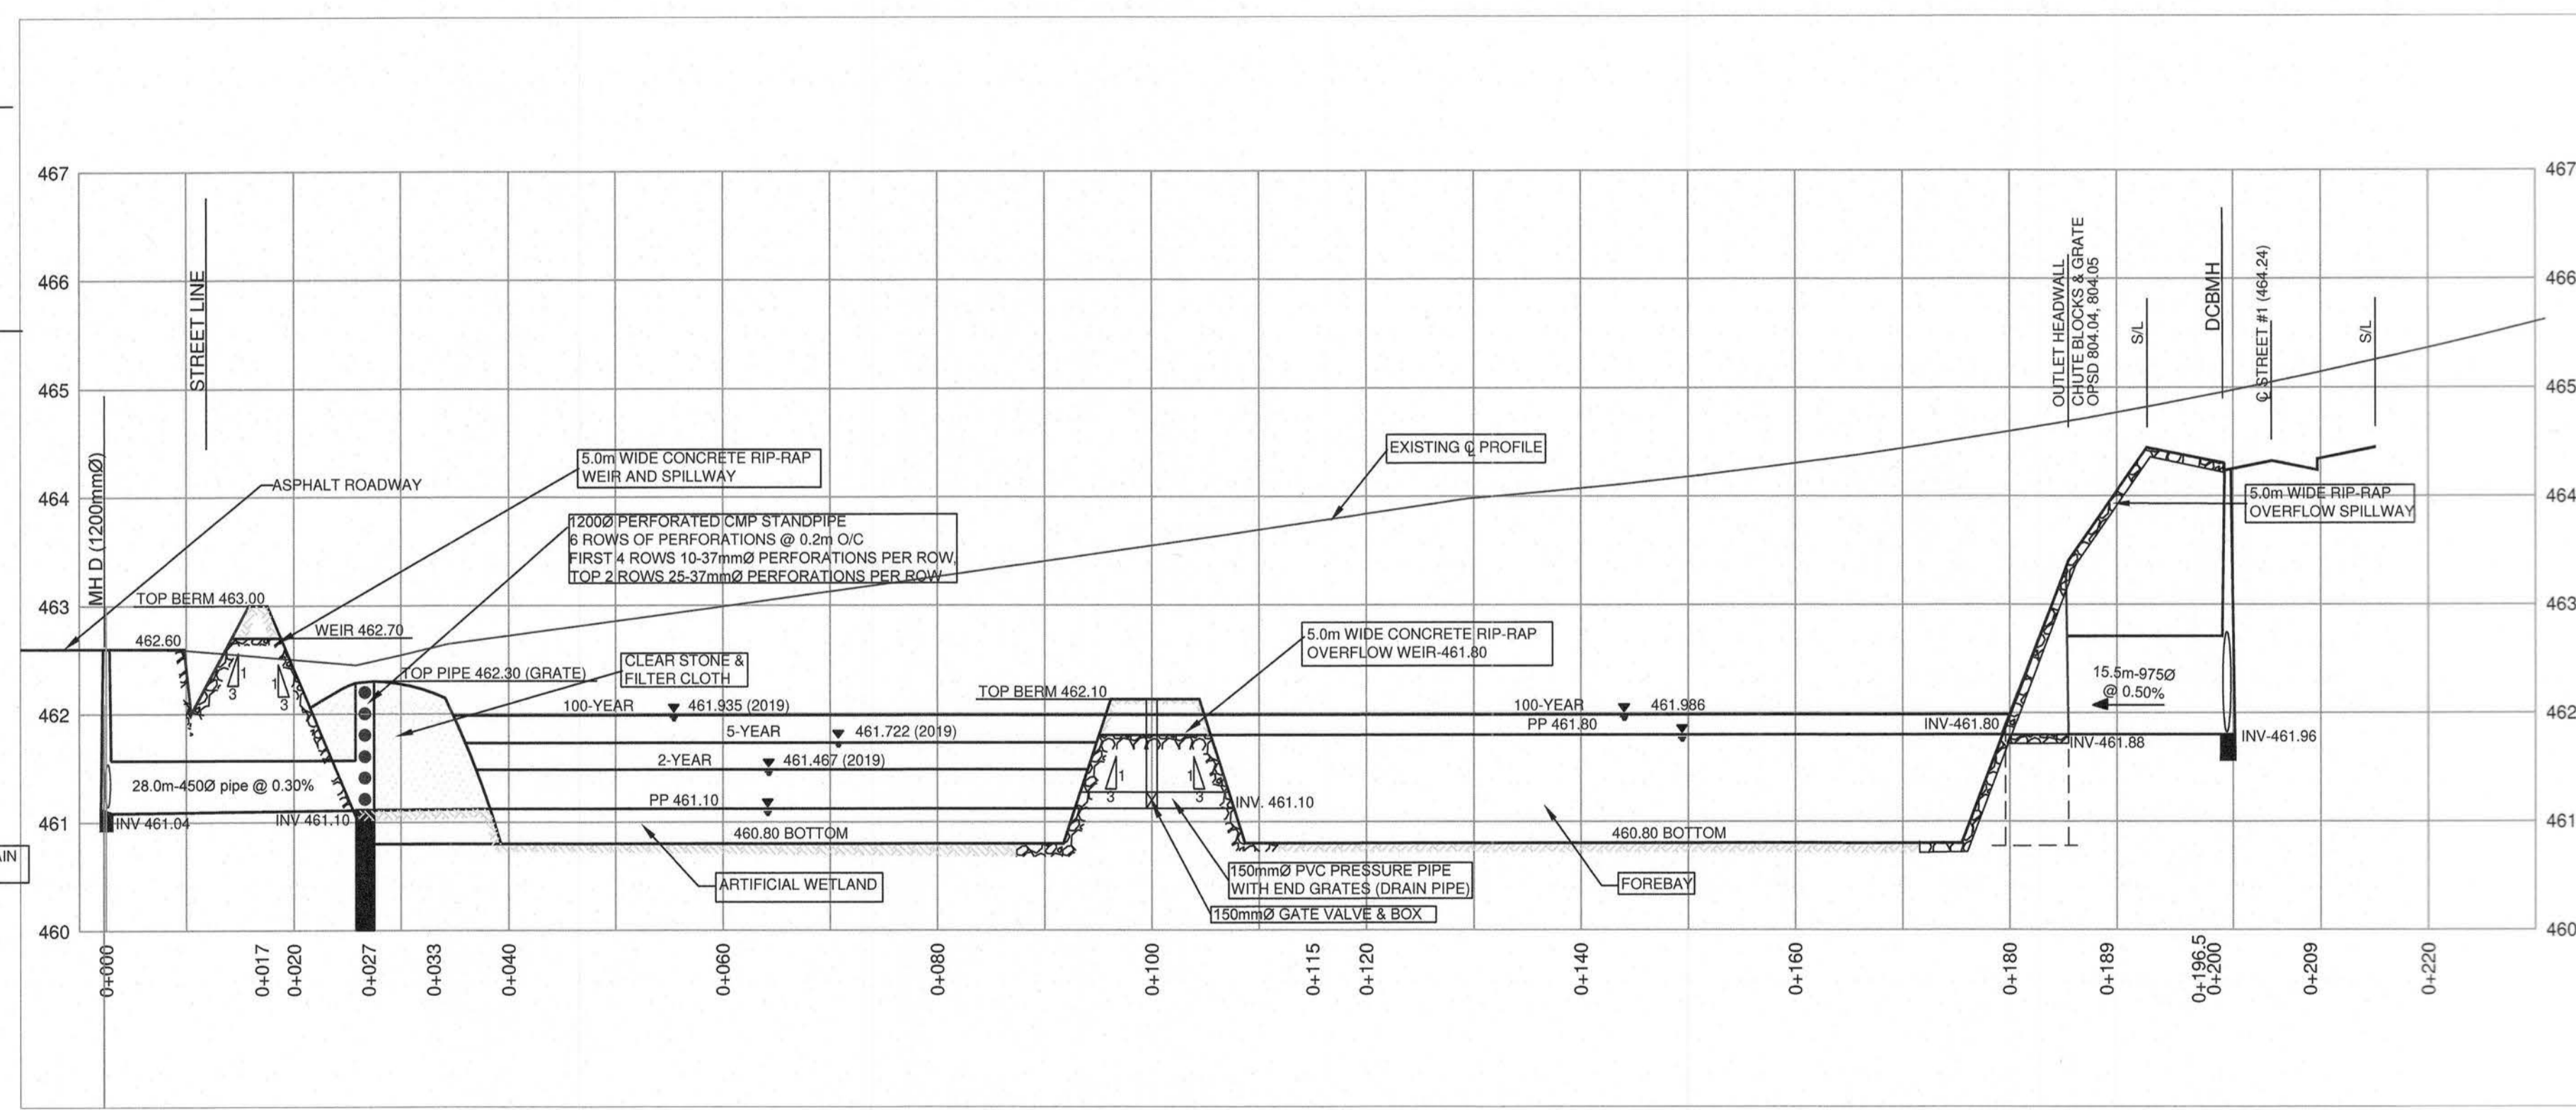

SECTION A-A' N.T.S.

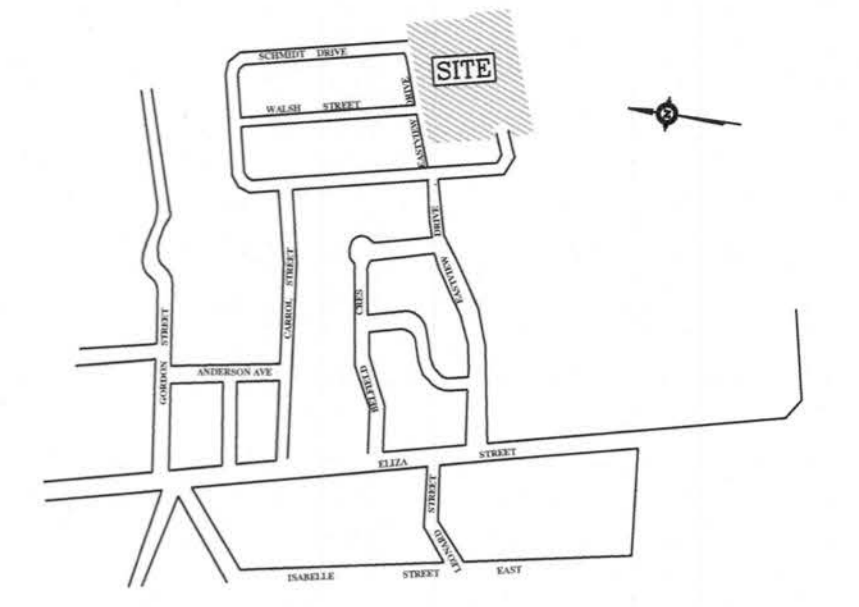

LEGEND

- PROPOSED ELEVATIONS
- CHAIN LINK FENCE
- EXISTING CONTOURS

No.	DESCRIPTION	DATE	INTL.
10	GENERAL REVISIONS	22/06/20	KJB
9	WATER ELEVATIONS CHANGED	07/01/19	KJB
8	GENERAL REVISIONS	30/11/18	KJB
7	GENERAL REVISIONS	02/11/17	KJB
6	GENERAL REVISIONS	14/02/17	KJB
5	STORM POND ELEVATIONS CHANGED	21/07/16	KJB
4	GENERAL REVISIONS	27/10/06	KJB
3	GENERAL REVISIONS	29/09/06	KJB
2	STANDPIPE PERFORATIONS	28/02/06	KJB
1	GENERAL REVISIONS	17/02/06	KJB




APPROVED:
 K. J. BEHM AND ASSOCIATES INC.
 CONSULTING ENGINEERS
 55 ERB STREET EAST, SUITE 101
 WATERLOO, ONTARIO N2K 4K8
 PHONE (519) 742 3510 FAX (519) 742 3462

EASTRIDGE LANDING
 SUBDIVISION PHASE I-V
 ARTHUR, ONTARIO

STORMWATER
 MANAGEMENT
 PLAN

DRAWN	SM	SCALE	DWG. No.
DESIGN	KJB	1 : 500	SWM1
CHECKED	KJB	DATE	JULY 2006
PROJECT No.	260606		

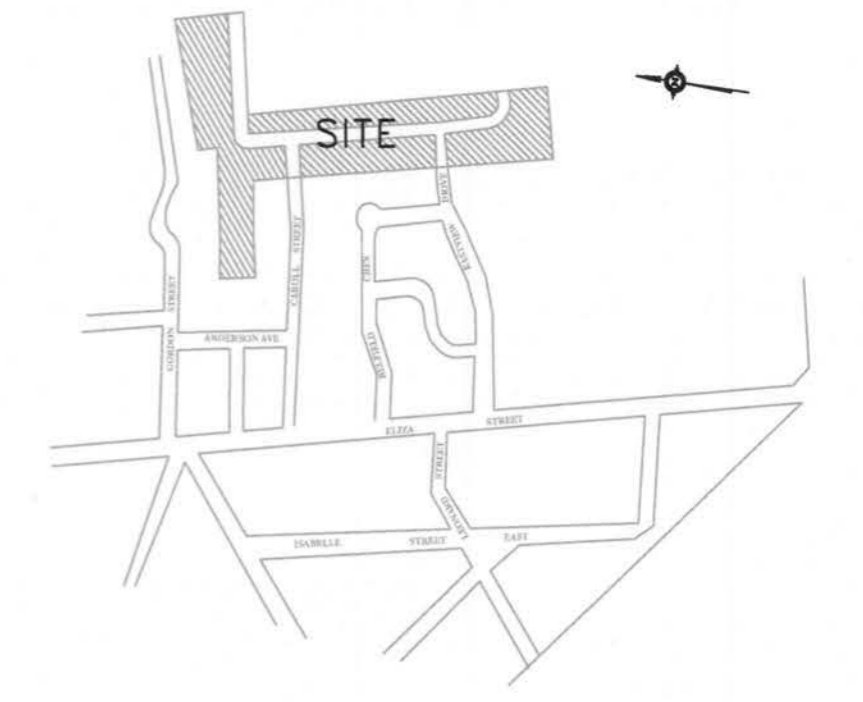

SITE LOCATION
N.T.S.

- BENCH MARKS:**
1. TOP OF STORM MANHOLE IN BOULEVARD AT SOUTHWEST CORNER OF ELIZA STREET AND GORDON STREET ELEV 462.03
 2. TOP OF SANITARY MANHOLE IN CUL-DE-SAC ON FARREL STREET. ELEV 462.31
 3. TOP OF SANITARY MANHOLE AT EXISTING EAST LIMIT OF EASTVIEW AVENUE. ELEV 464.27

- NOTES:**
1. 150mm ϕ Watermain shall be C900 PVC Class 150(DR18) B137.3 with Ring-Tie joints and Tracer Wire. Tracer Wire shall be 12 gauge 7 strand copper with plastic coating and shall be connected to both on bottom flange of fire hydrant. 38mm ϕ Watermains shall be Type 'K' copper pipe. Watermains and services shall be installed minimum 2.0 m below finished grade above the main or service.
 2. Watermain fittings -Ductile Iron,mechanical joint,AWWA C110 approved, pressure rating 1035 kPa. -PVC bends and tees to be used with mechanical joint restraints.
 3. Watermain valves shall be Mueller "Super Seal" Resilient Gate Valve, mechanical joint.
 4. Watermain Valve Boxes shall be VB3100, 3 place No.6 round base screw type as manufactured by BIBBY-ST CROIX FOUNDRIES INC., Cambridge, Ontario.
 5. Hydrants shall be Canada Valve New Century Type Compression or McAnby M-59, with "Storm" bumper connection. All hydrants to be painted yellow with black "Storm" cap.
 6. Water services to be 20mm single Type 'K' copper pipe.
 7. Anodes: DZP-24, 10.9 kg shall be installed on all connections to existing iron watermains. DZP-12, 5.4 kg shall be installed on all iron fittings, valves etc.
 8. Main stops, curb stops, unions and service boxes shall be in accordance with the Township of Wellington North Specifications.
 9. Sanitary sewer shall be 200mm PVC-SDR35 meeting the current ASTM D3034 Specifications and CSA-182.2.
 10. Sanitary Services shall be 100mm PVC-SDR28 meeting the current CSA-182.2 Specifications. Service connections to be at a minimum grade of 2%. All connections to new mains shall have manufactured tees. All new connections to existing mains shall use stainless steel straps and saddles. Sanitary Services shall be 100mm PVC-SDR28 meeting the current.
 11. Sanitary sewer mainline fittings shall be PVC-SDR35 meeting the current ASTM D3034-73 Specifications and CSA-182.2.
 12. Storm sewers 375mm and less shall be either Concrete E.S. or PVC Ultra-Rib as per CSA-182.4
 13. All storm services shall be 100mm PVC-SDR28 and connected to mainline with prefabricated tee or "Kou-N-Tee"
 14. All catchbasin leads (250mm Single, 300mm Double) shall be PVC-SDR35.
 15. All sewer pipes and watermains to be installed in Class 'B' Bedding per OFSD 802.01 and 802.03.
 16. Pavement design for all roads shall be:
450mm Granular 'B' road base
150mm Granular 'A' road base
50mm HL4 Binder Course Asphalt
30mm HL3 (fine) Surface Course Asphalt
 17. Concrete Curbs and sidewalks shall be poured using 30MPa strength @ 28 days.
 18. All watermains and sewers to be tested in accordance with Township of Centre Wellington Specifications or as noted in the Contract Documents.
 19. Road subdrains to be installed if required as determined by site conditions at time of construction. Subdrains shall be 100mm ϕ perforated plastic drainage tile c/w geotextile filter sock.
 20. Concrete Curb to be barrier as per OFSD 800.10.
 21. Water Service Boxes to be located at limit of easement.
 22. Sump Pumps to discharge to storm services.
 23. Driveways shall be:
150mm Granular 'B'
150mm Granular 'A'
50mm HL3 Asphalt
 24. All structures shall allow for an adjustment of between 150mm-300mm with modulus.
 25. This plan shall be read in conjunction with drawing #2-Grading and Erosion Control Plan and the approved Site Plan and the approved Landscaping Plan (by others).
 26. Road Section to be in accordance with Township Standard Drawing R1 (see section Drawing #63).

* WATERMAIN TO CROSS UNDER STORM WITH A MINIMUM OF 0.5m CLEARANCE.

No.	DESCRIPTION	DATE	INTL.
3	AS-CONSTRUCTED U/G SERVICES	20/07/07	KJB
2	GENERAL REVISIONS	27/10/06	KJB
1	GENERAL REVISIONS	25/09/06	KJB





CHECKED: APPROVED:

K. J. BEHM AND ASSOCIATES INC.
CONSULTING ENGINEERS
60 NEW DUNDAS RD., KITCHENER, ONTARIO, N2P 2N6
PHONE: (519) 742 3510 FAX: (519) 742 3462



**EASTRIDGE LANDING
SUBDIVISION PHASES I AND II
ARTHUR, ONTARIO**

**PLAN AND PROFILE
CARROL STREET
STA. 0+880 TO STA. 1+124.08**

DRAWN	SM	SCALE	1 : 500	DWG. No.
DESIGN	KJB	DATE	JUNE 2006	4
CHECKED	KJB	PROJECT No.	280606	

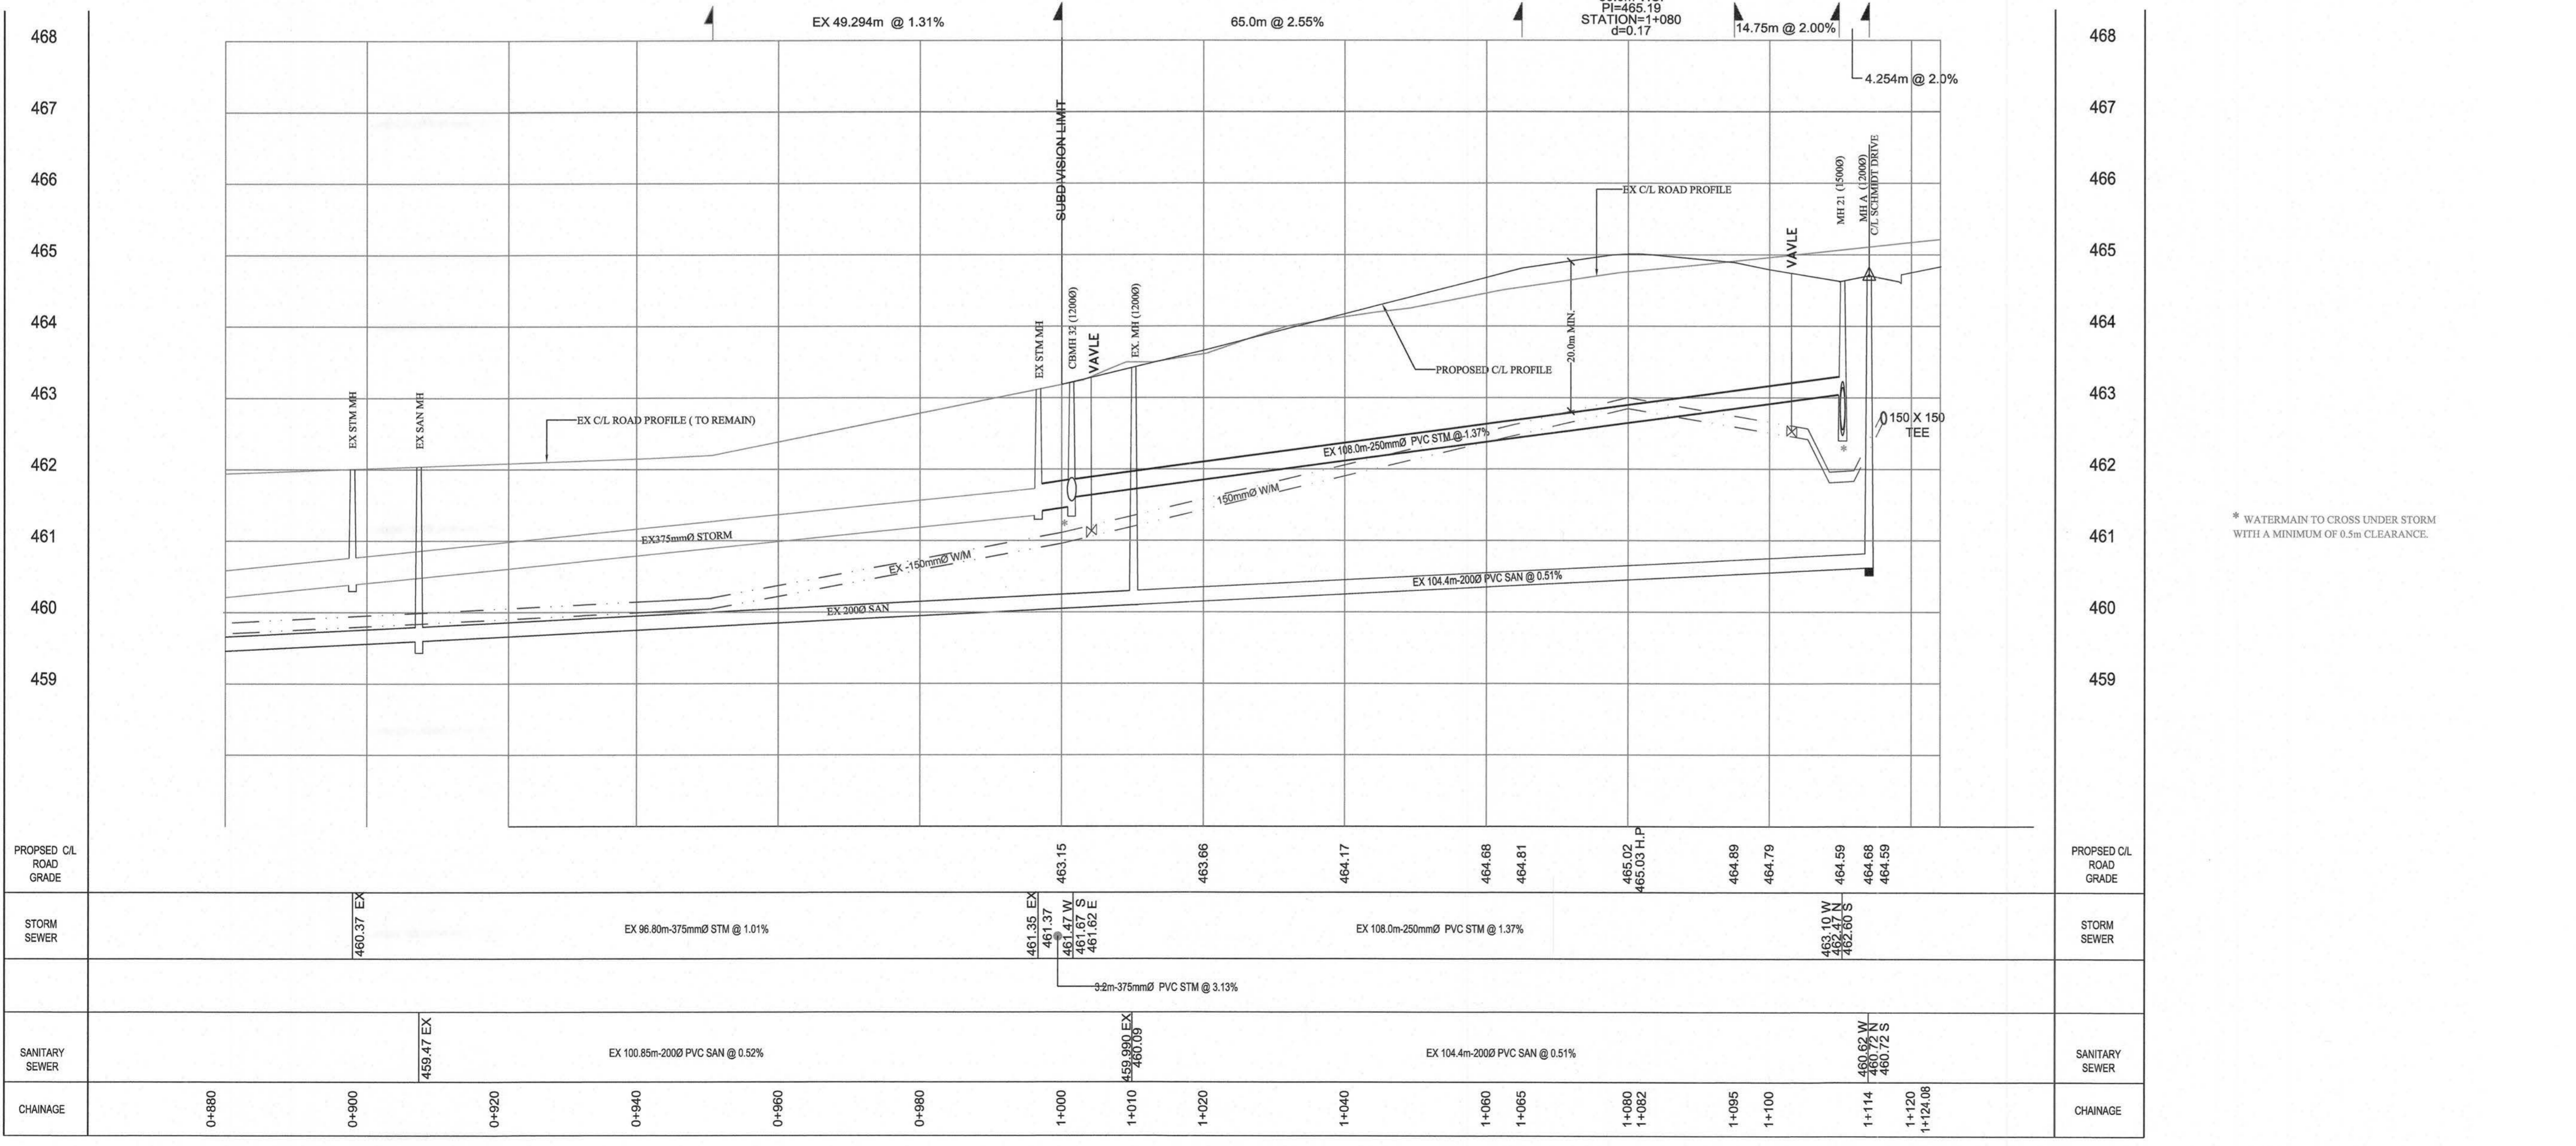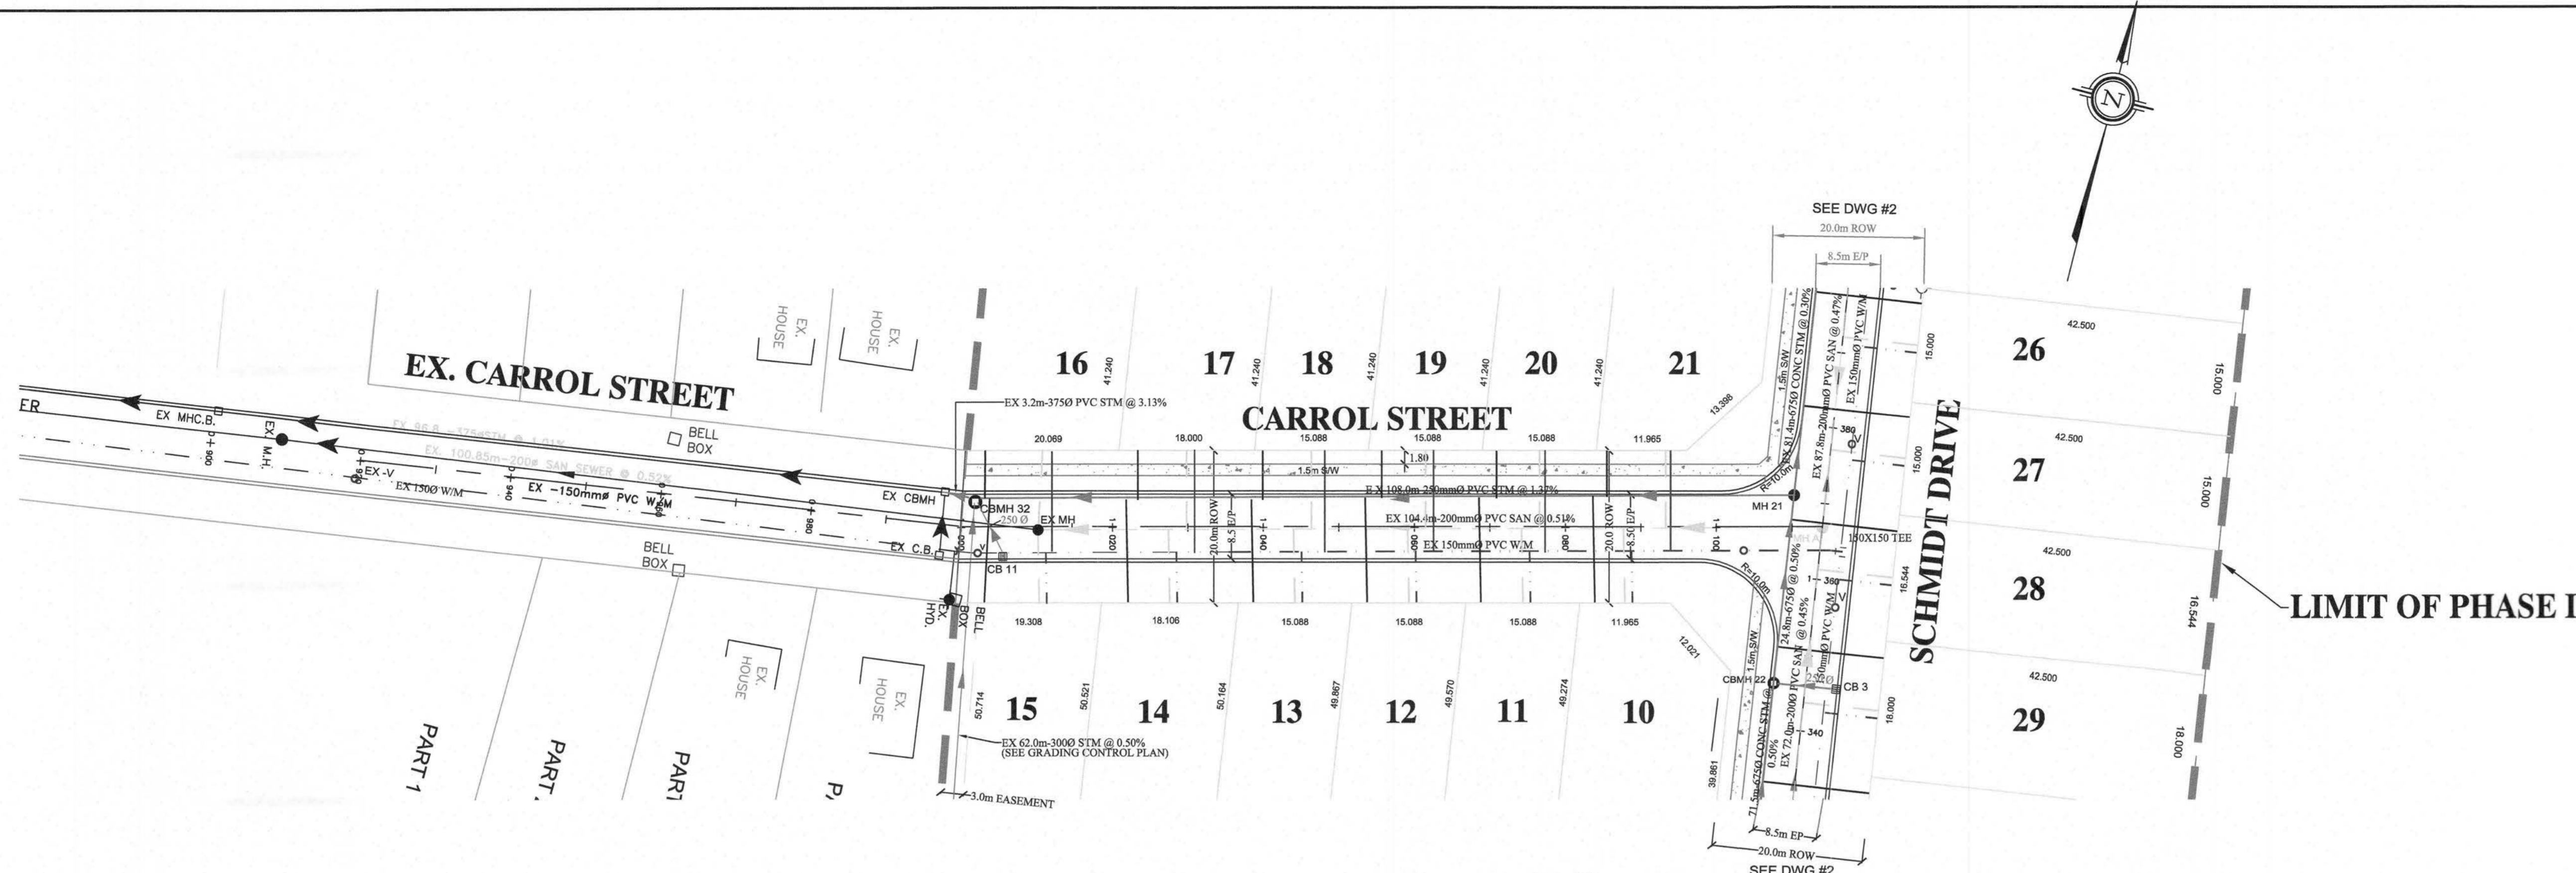


PROPOSED C/L ROAD GRADE	468	467	466	465	464	463	462	461	460	459	PROPOSED C/L ROAD GRADE						
STORM SEWER											STORM SEWER						
SANITARY SEWER											SANITARY SEWER						
CHAINAGE	0+880	0+900	0+920	0+940	0+960	0+980	1+000	1+010	1+020	1+040	1+060	1+080	1+100	1+114	1+120	1+124.08	CHAINAGE

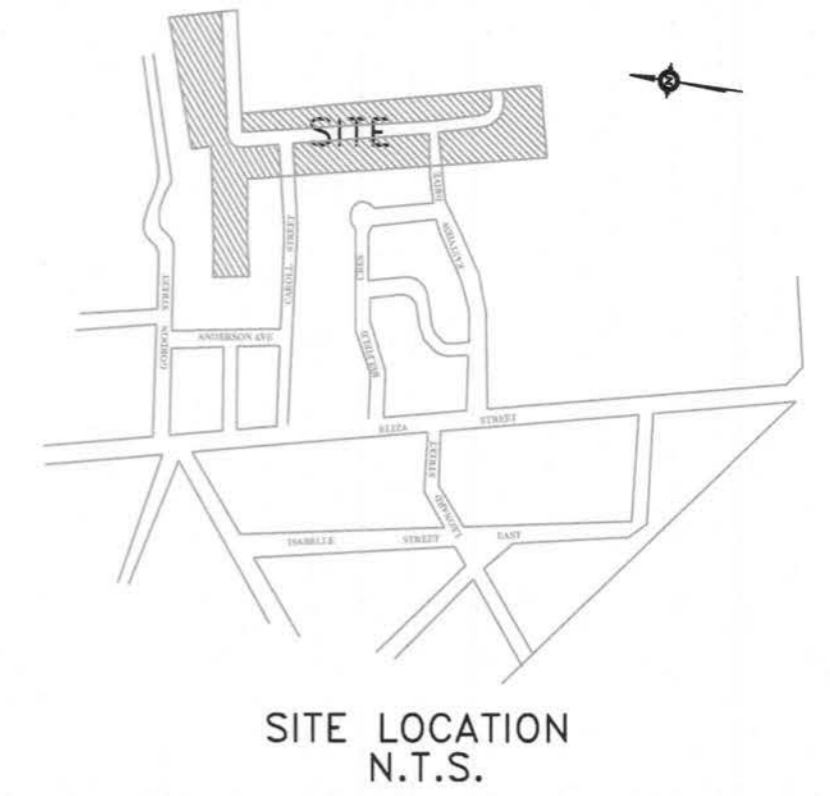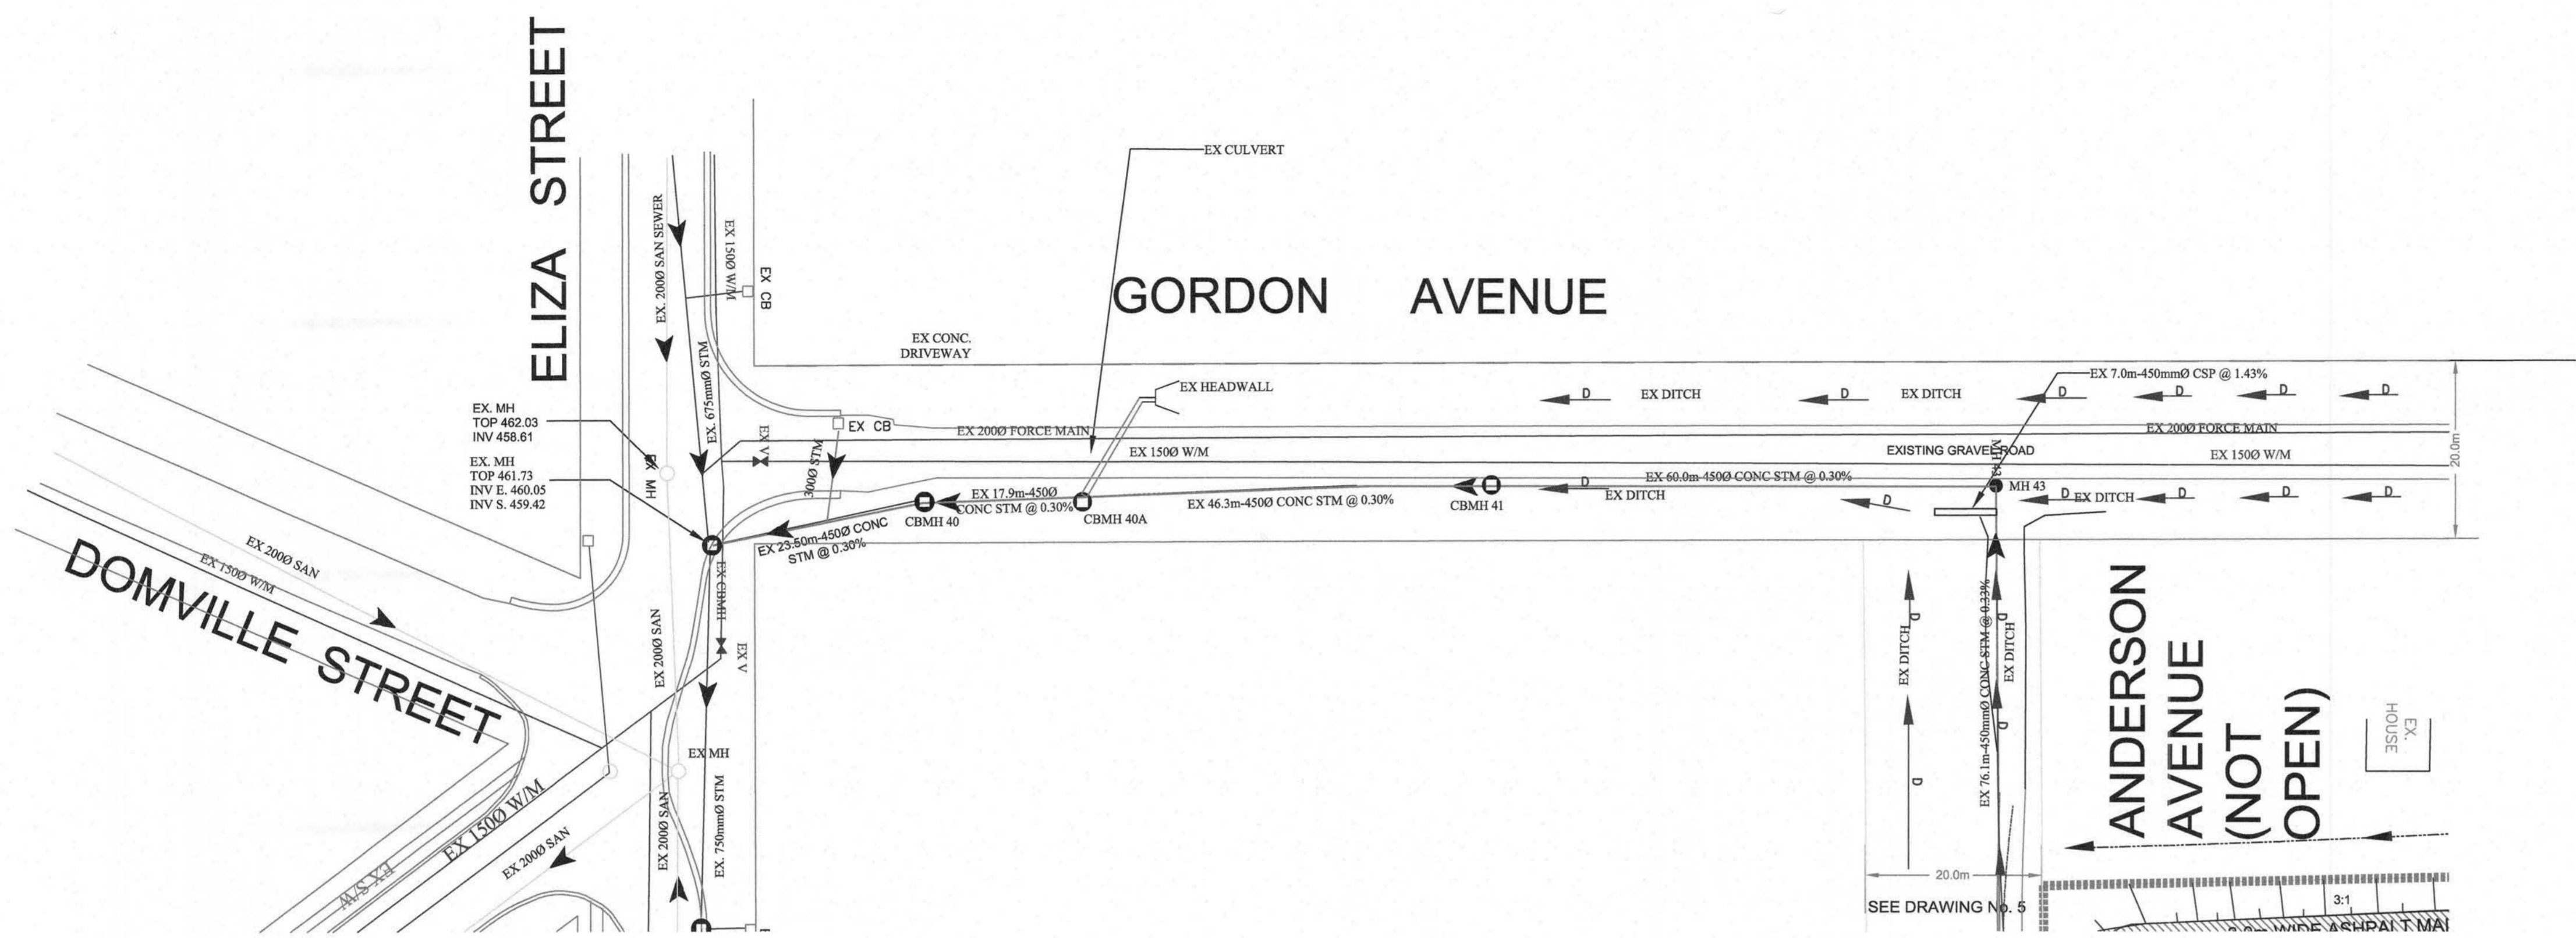

- BENCH MARKS:**
1. TOP OF STORM MANHOLE IN BOULEVARD AT SOUTHWEST CORNER OF ELIZA STREET AND GORDON STREET ELEV 462.03
 2. TOP OF SANITARY MANHOLE IN CUL-DE-SAC ON FARREL STREET. ELEV 462.31
 3. TOP OF SANITARY MANHOLE AT EXISTING EAST LIMIT OF EASTVIEW ANNUE. ELEV 464.27

- NOTES:**
1. 150mm² Watermain shall be C900 PVC Class 150(DR18), B137.3 with Ring-Tile joints and Tracer Wire. Tracer Wire shall be 12 gauge, 7 strand copper with plastic coating and shall be connected to bolt on bottom flange of fire hydrant. 38mm² Watermain shall be Type 'K' copper pipe. Watermain and services shall be installed minimum 2.0 m below finished grade above the main or service.
 2. Watermain fittings - Ductile Iron, mechanical joint AWWA C110 approved, pressure rating 1035 kPa.
 3. Watermain valves shall be Mueller "Super Seal" Resilient Gate Valve, mechanical joint.
 4. Watermain Valve Boxes shall be VES100, 3 piece No.6 round base screw type as manufactured by BIBBY-ST CROIX FOUNDRIES INC., Cambridge, Ontario.
 5. Hydrants shall be Canada Valve New Century Type Compression or Molybly 14.56 with "Storz" pump connection. All hydrants to be painted yellow with black "Storz" cap.
 6. Water services to be 20mm single Type 'K' copper pipe.
 7. Anodes - DZP-24, 10.8 kg shall be installed on all connections to existing iron watermain.
 8. Main stops, curb stops, unions and service boxes shall be in accordance with the Township of Wellington North Specifications.
 9. Sanitary sewer shall be 200mm PVC-SDR35 meeting the current ASTM D3034 Specifications and CSA-182.2.
 10. Sanitary Services shall be 100mm PVC-SDR28 meeting the current CSA-182.2 Specifications. Service connections to be at a minimum grade of 2%. All connections to new mains shall have manufactured tees. All new connections to existing mains shall use stainless steel straps and saddles. Sanitary Services shall be 100mm PVC-SDR28 meeting the current.
 11. Sanitary sewer mainline fittings shall be PVC-SDR35 meeting the current ASTM D3034-73 Specifications and CSA-182.2.
 12. Storm sewers 375mm and less shall be either: Concrete E.S. or PVC Ultra-Rib as per CSA-182.4
 13. All storm services shall be 100mm PVC-SDR28 and connected to mainline with pretensioned tee or "No-Ar-Tee"
 14. All catchbasin leads (250mm Single, 300mm Double) shall be PVC-SDR35.
 15. All sewer pipes and watermain to be installed in Class 'B' Bedding per OPSD 802.01 and 802.03.
 16. Pavement design for all roads shall be:
450mm Granular 'B' road base
150mm Granular 'A' road base
50mm H-4 Binder Course Asphalt
35mm H-3 (Fine) Surface Course Asphalt
 17. Concrete Curbs and sidewalks shall be poured using 30MPa strength @ 28 days.
 18. All watermain and sewers to be tested in accordance with Township of Centre Wellington Specifications or as noted in the Contract Documents.
 19. Road subdrains to be installed if required as determined by site conditions at time of construction. Subdrains shall be 100mm² perforated elastic drainage the one geotextile filter sock.
 20. Concrete Curb to be barrier as per OPSD 600.10
 21. Water Service Boxes to be located at limit of easement.
 22. Sump Pumps to discharge to storm services.
 23. Driveways shall be:
150mm Granular 'B'
150mm Granular 'A'
50mm H-3C Asphalt
 24. All structures shall allow for an adjustment of between 150mm-300mm with modulus.
 25. This plan shall be read in conjunction with dwg #2- Grading and Erosion Control Plan and the approved Site Plan and the approved Landscaping Plan (by others).
 26. Road Section to be in accordance with Township Standard Drawing R1 (see section Drawing #G3).

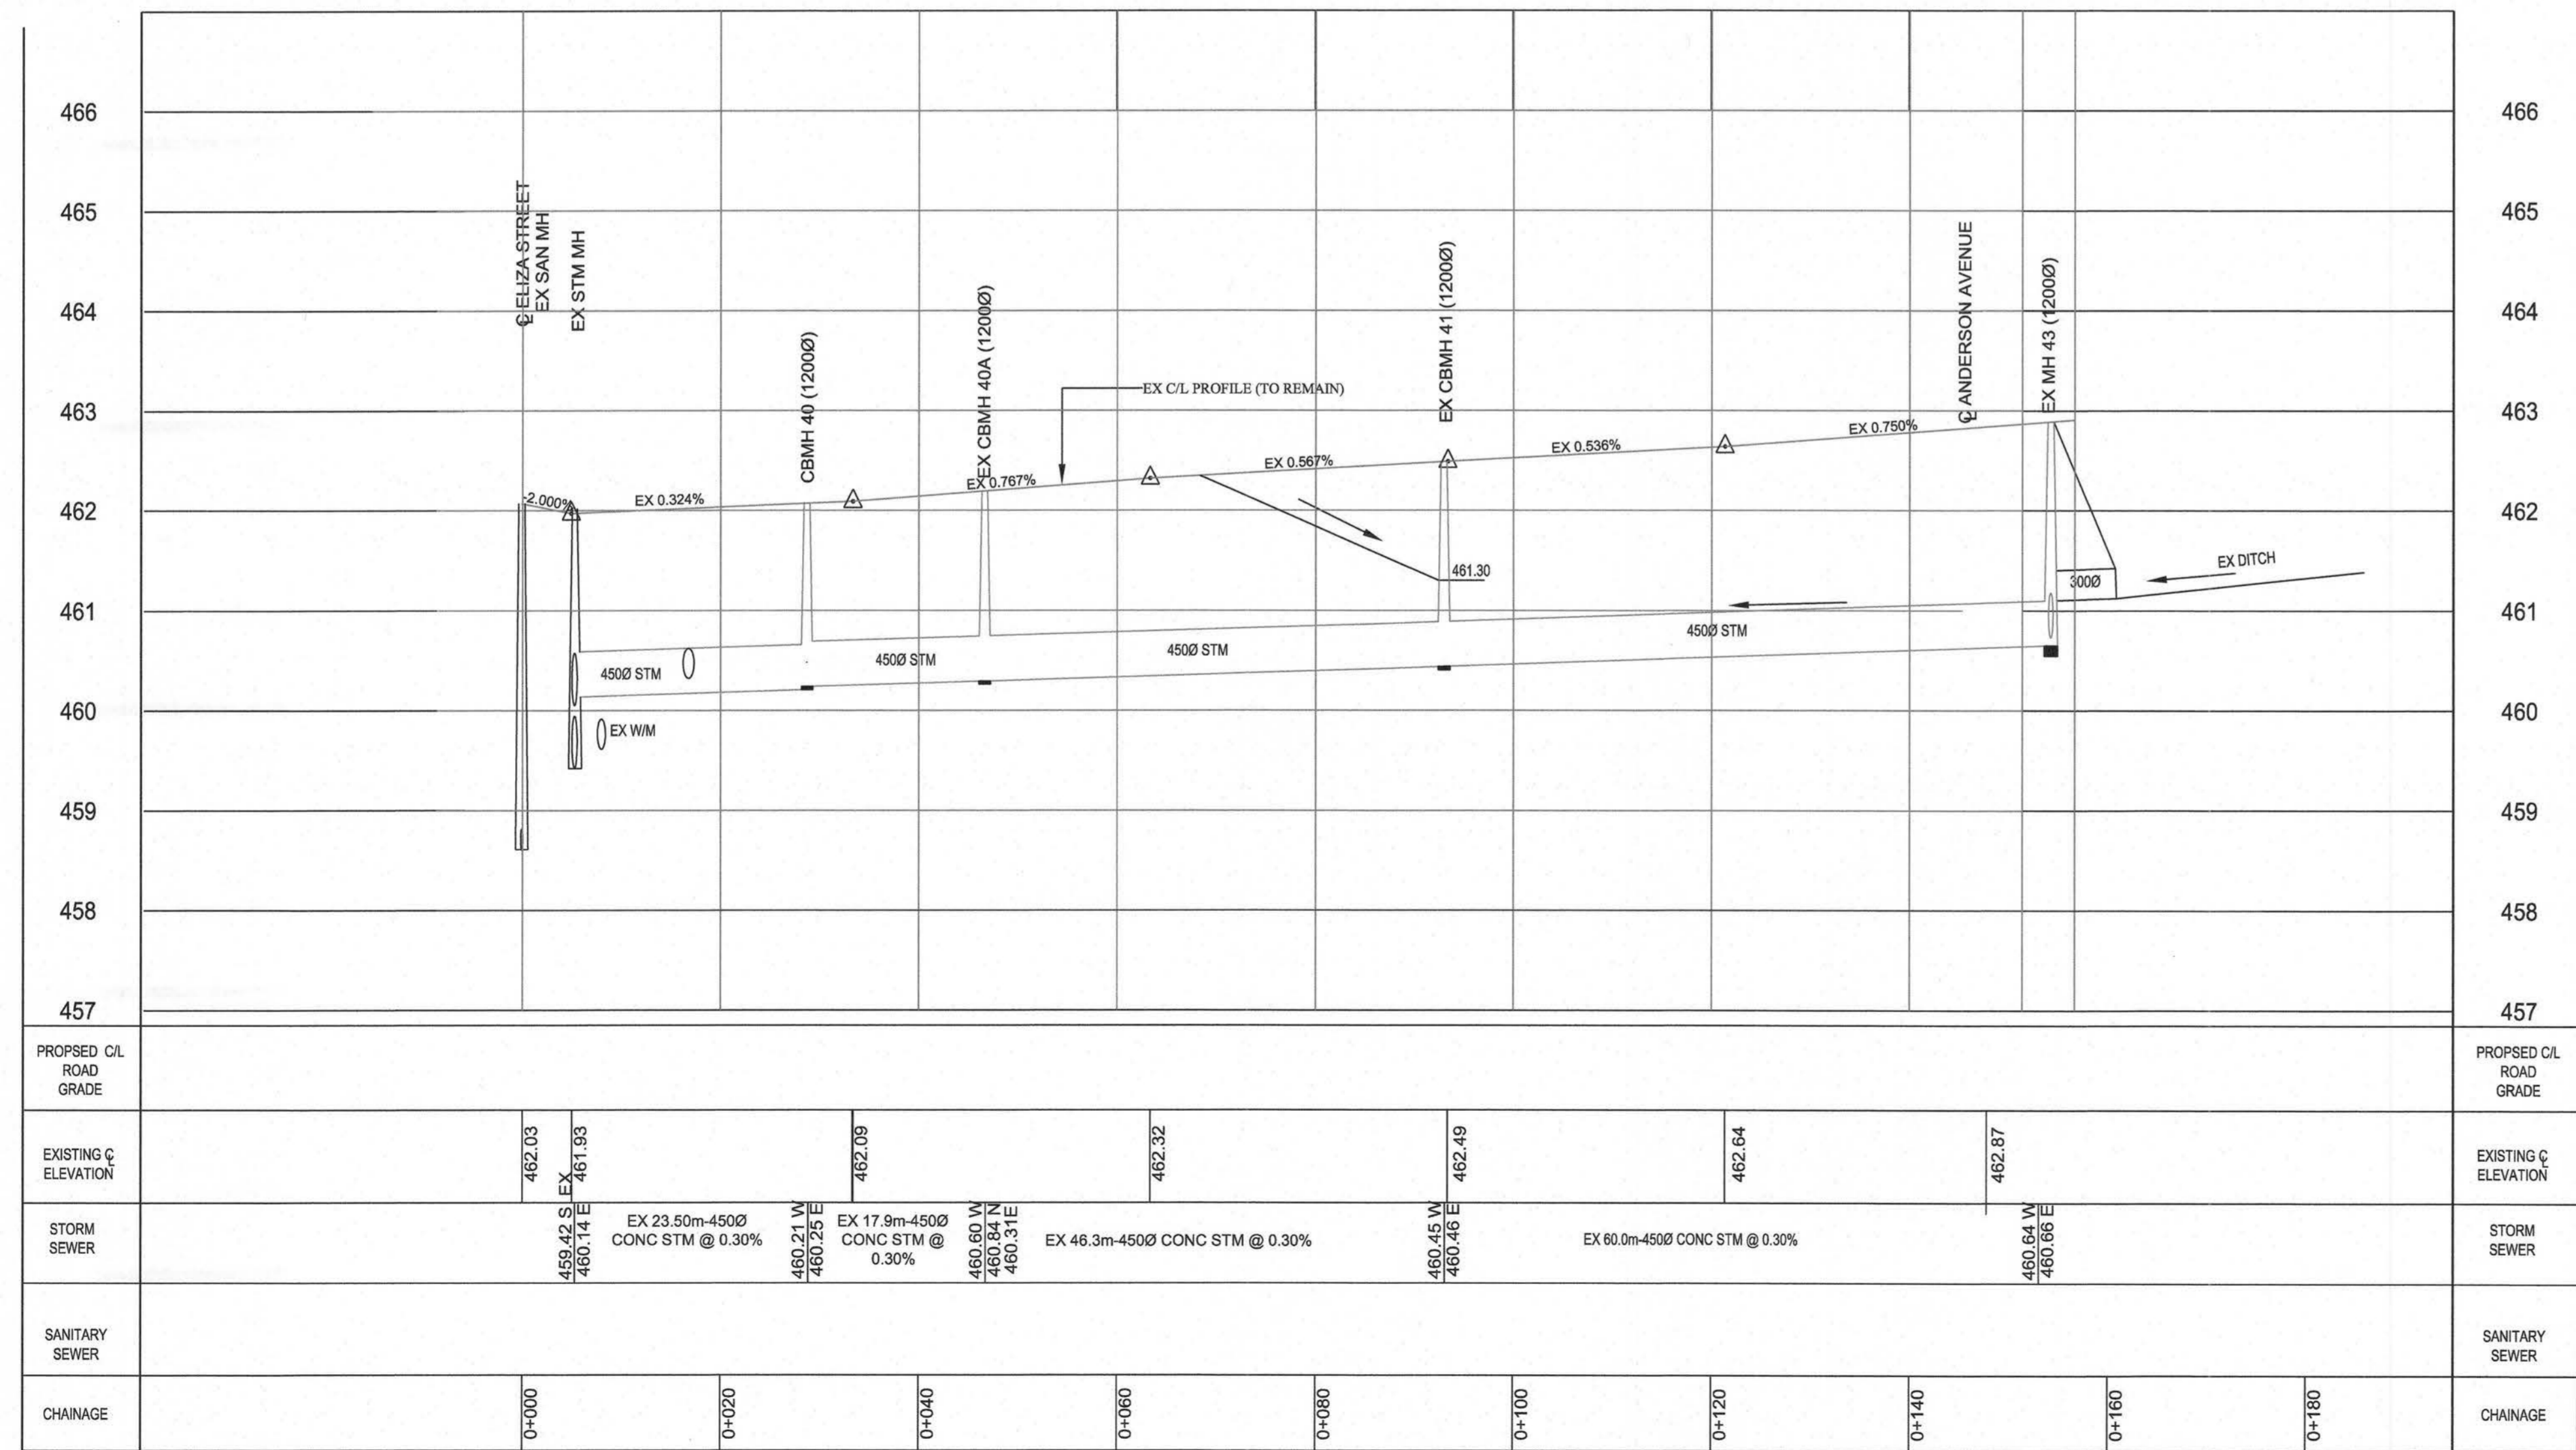

No.	DESCRIPTION	DATE	INTL.
2	AS-CONSTRUCTED U/G SERVICES	20/07/07	KJB
1	GENERAL REVISIONS	29/09/06	KJB



CHECKED: _____ APPROVED: _____

K. J. BEHM AND ASSOCIATES INC.
 CONSULTING ENGINEERS
 60 NEW DUNDEE RD., KITCHENER, ONTARIO, N2P 2N6
 PHONE (519) 742-3510 FAX (519) 742-3462

EASTRIDGE LANDING
SUBDIVISION PHASES I AND II
 ARTHUR, ONTARIO


PLAN AND PROFILE
GORDON AVENUE
STA.0-000 TO STA. 0+150

DRAWN SM	SCALE 1 : 500	DWG. No. 6
DESIGN KJB	DATE JUNE 2006	
CHECKED KJB	PROJECT No. 260608	

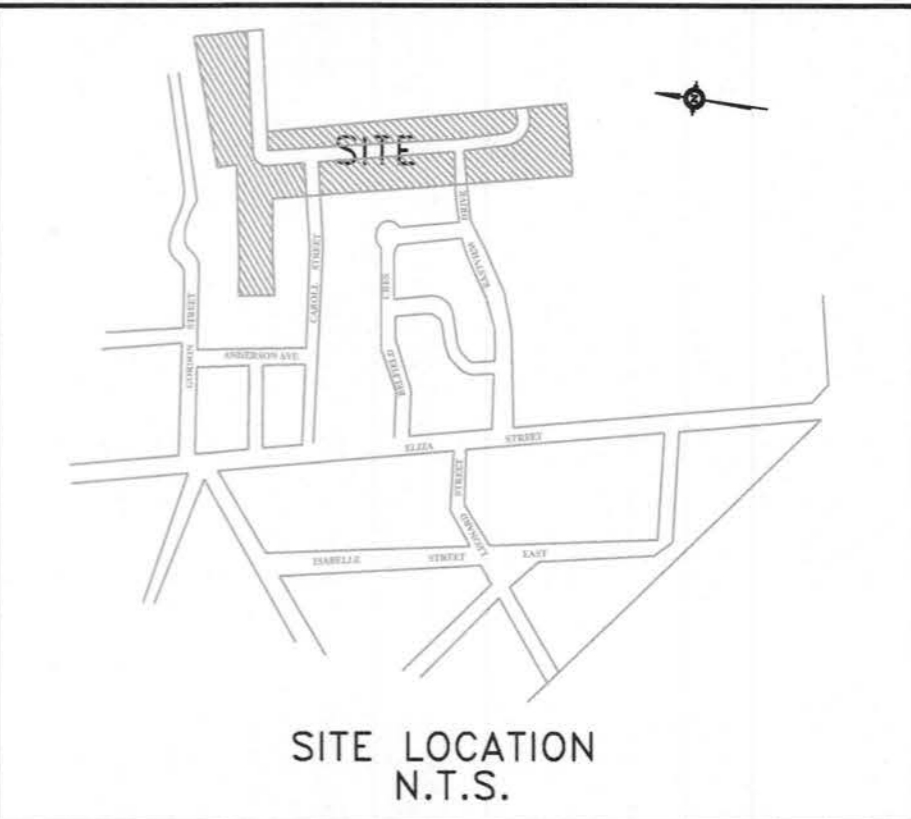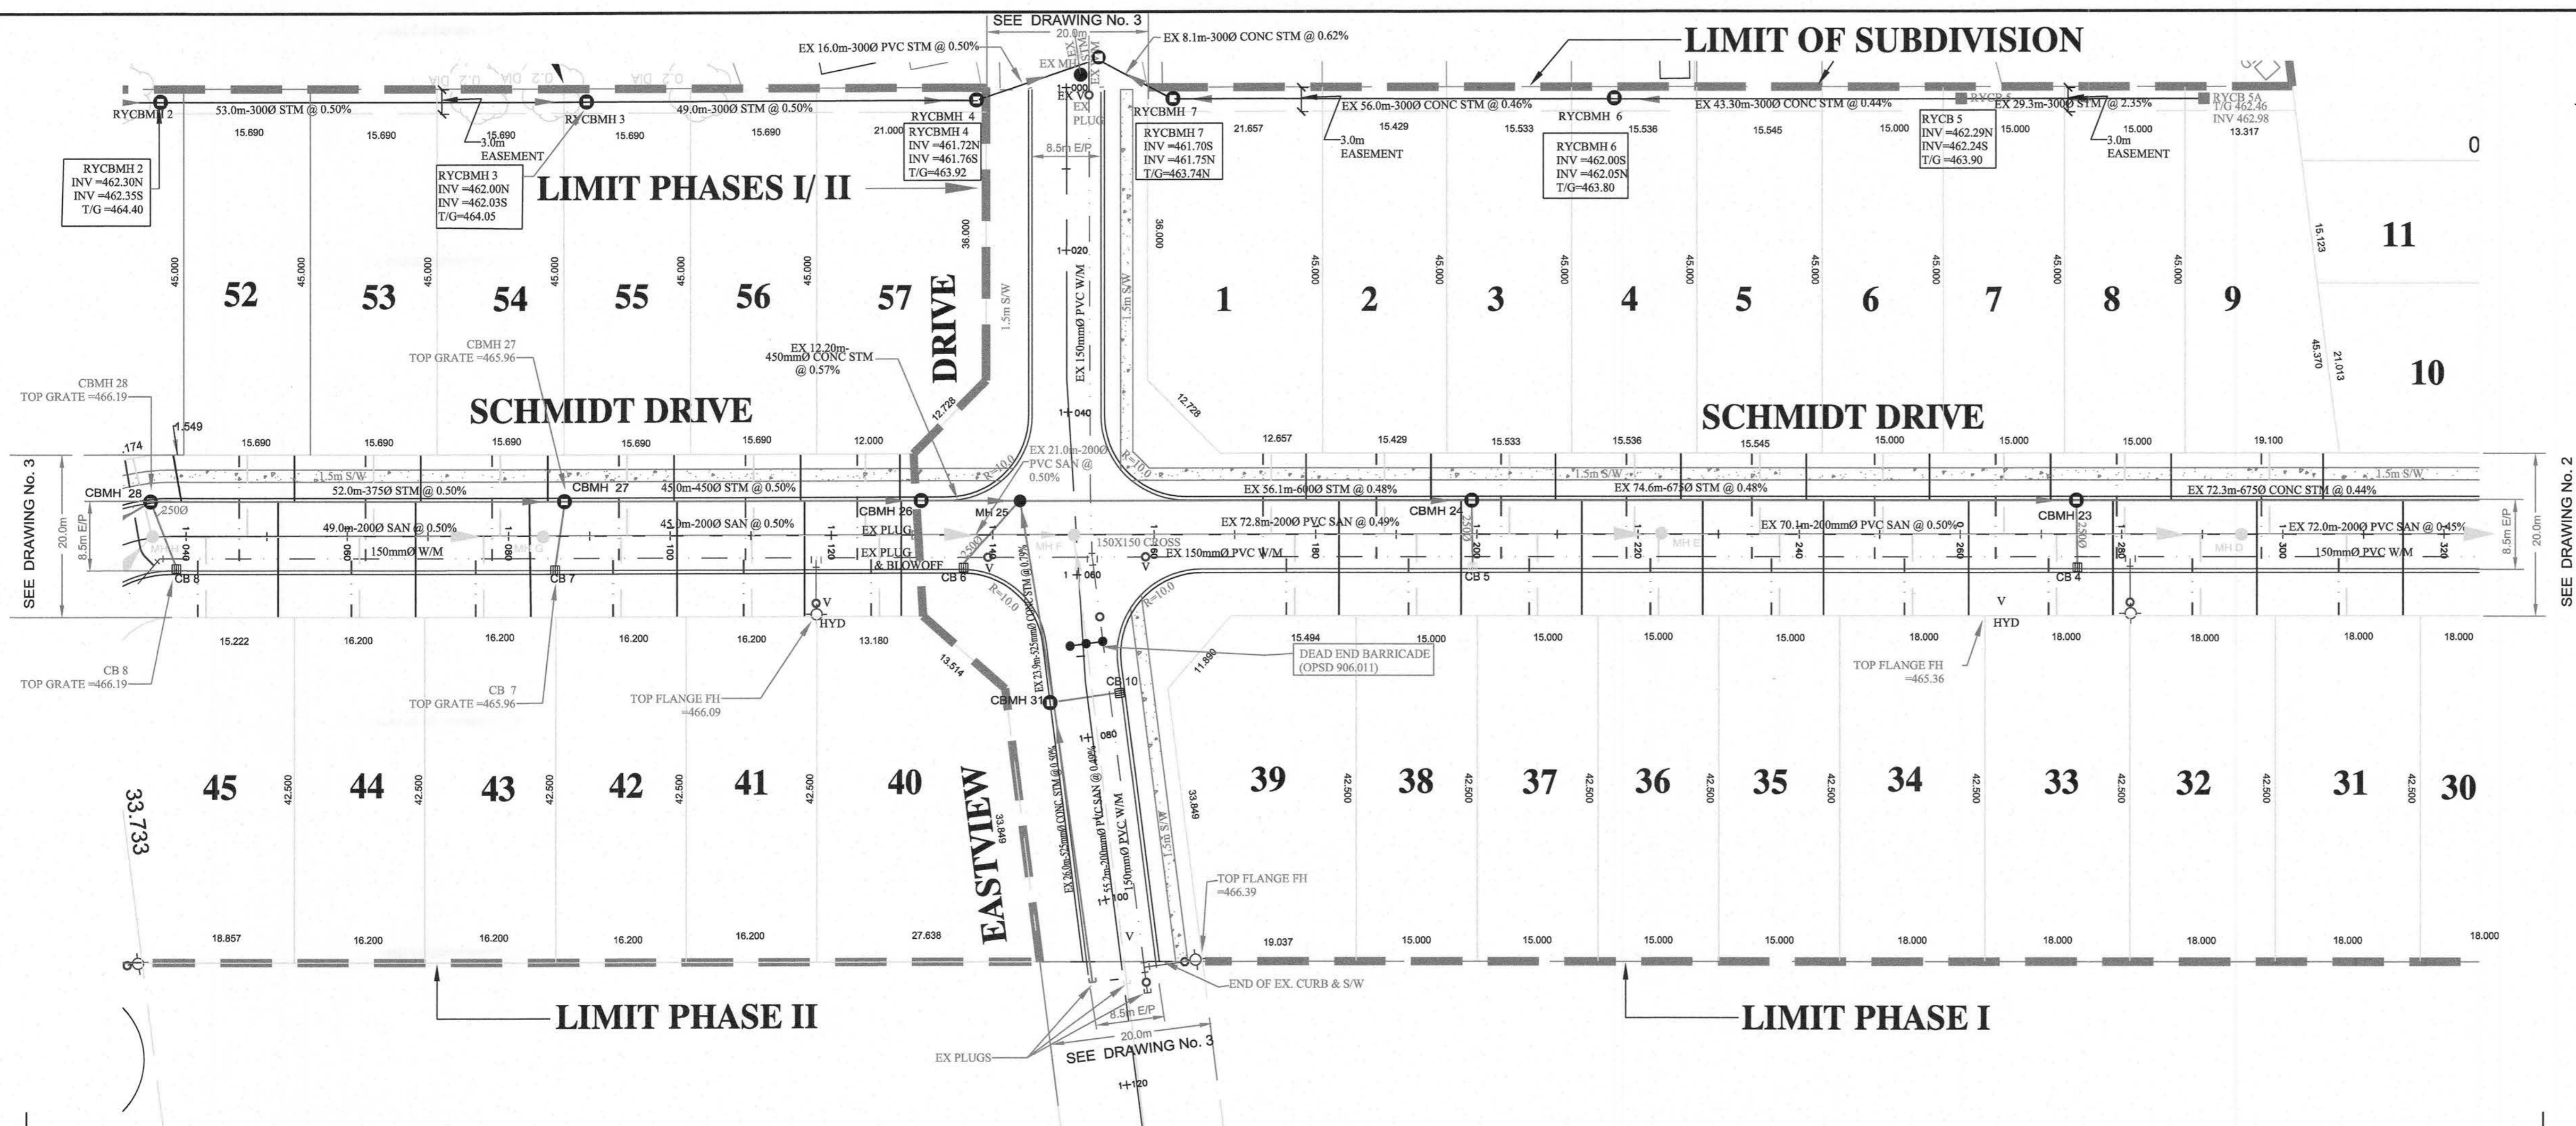

- BENCH MARKS:**
- TOP OF STORM MANHOLE IN BOULEVARD AT SOUTHWEST CORNER OF ELIZA STREET AND GORDON STREET ELEV 462.03
 - TOP OF SANITARY MANHOLE IN CUL-DE-SAC ON FARREL STREET. ELEV 462.31
 - TOP OF SANITARY MANHOLE AT EXISTING EAST LIMIT OF EASTVIEW AVENUE. ELEV 464.27

- NOTES:**
- 150mm \varnothing Watermain shall be C900 PVC Class 150(DR19), B137.3 with Ring-Tite joints and Tracer Wire. Tracer Wire shall be 12 gauge 7 strand copper with plastic coating and shall be connected to bolt on bottom flange of the hydrant. 150mm \varnothing Watermain shall be Type 'K' copper pipe. Watermain and services shall be installed minimum 2.0 m below finished grade above the main or service.
 - Watermain fittings - Ductile Iron, mechanical joint, AWWA C110 approved, pressure rating 1035 kPa. PVC bands and ties to be used with mechanical joint restraints.
 - Watermain valves shall be Mueller "Super Seal" Resilient Gate Valve, mechanical joint.
 - Watermain Valve Boxes shall be V83100, 3 place No.6 round base screw type as manufactured by BIRBY-ST. CROOK FOUNDRIES INC., Cambridge, Ontario.
 - Hydrants shall be Canada Valve New Century Type Compression or Modelly 4-56 with "Storz" pump connection. All hydrants to be painted yellow with black "Storz" cap.
 - Water services to be 20mm single Type 'K' copper pipe.
 - Anodes - DZP-24, 10.9 kg shall be installed on all connections to existing iron watermain.
 - DZP-12, 5.4 kg shall be installed on all iron fittings, valves etc.
 - Main stops, curb stops, unions and service boxes shall be in accordance with the Township of Wellington North Specifications.
 - Sanitary sewer shall be 200mm PVC-SDR35 meeting the current ASTM D3034 Specifications and CSA-182.2.
 - Sanitary Services shall be 100mm PVC-SDR28 meeting the current CSA-182.2 Specifications. Service connections to be at a minimum grade of 2%. All connections to new mains shall have manufactured tees. All new connections to existing mains shall use stainless steel straps and saddles. Sanitary Services shall be 100mm PVC-SDR28 meeting the current ASTM D3034-73 Specifications and CSA-182.2.
 - Sanitary sewer manhole fittings shall be PVC-SDR35 meeting the current ASTM D3034-73 Specifications and CSA-182.2.
 - All storm services shall be 100mm PVC-SDR28 and connected to mainline with prefabricated tees or "Kor-A-Tee".
 - All catchbasin tees (250mm Single, 300mm Double) shall be PVC-SDR35.
 - All sewer pipes and watermain to be installed in Class 'B' Bedding per OPSD 802.01 and 802.03.
 - Pavement design for all roads shall be:
450mm Granular 'B' road base
150mm Granular 'A' road base
50mm H-4 Binder Course Asphalt
35mm H-3 (fine) Surface Course Asphalt
 - All watermain and sewers to be tested in accordance with Township of Centre Wellington Specifications or as noted in the Contract Documents.
 - Road subdrains to be installed if required as determined by site conditions at time of construction. Subdrains shall be 100mm \varnothing perforated plastic drainage tile on geotextile filter sock.
 - Concrete Curb to be better as per OPSD 600.10.
 - Water Service Boxes to be located at limit of easement.
 - Sump Pumps to discharge to storm services.
 - Driveways shall be:
150mm Granular 'B'
100mm Granular 'A'
50mm H-3C Asphalt
 - All structures shall allow for an adjustment of between 150mm-300mm with modulus.
 - The plan shall be read in conjunction with drawing #2- Grading and Erosion Control Plan and the approved Site Plan and the approved Landscaping Plan (by others).
 - Road Section to be in accordance with Township Standard Drawing R1 (see section Drawing #G3).

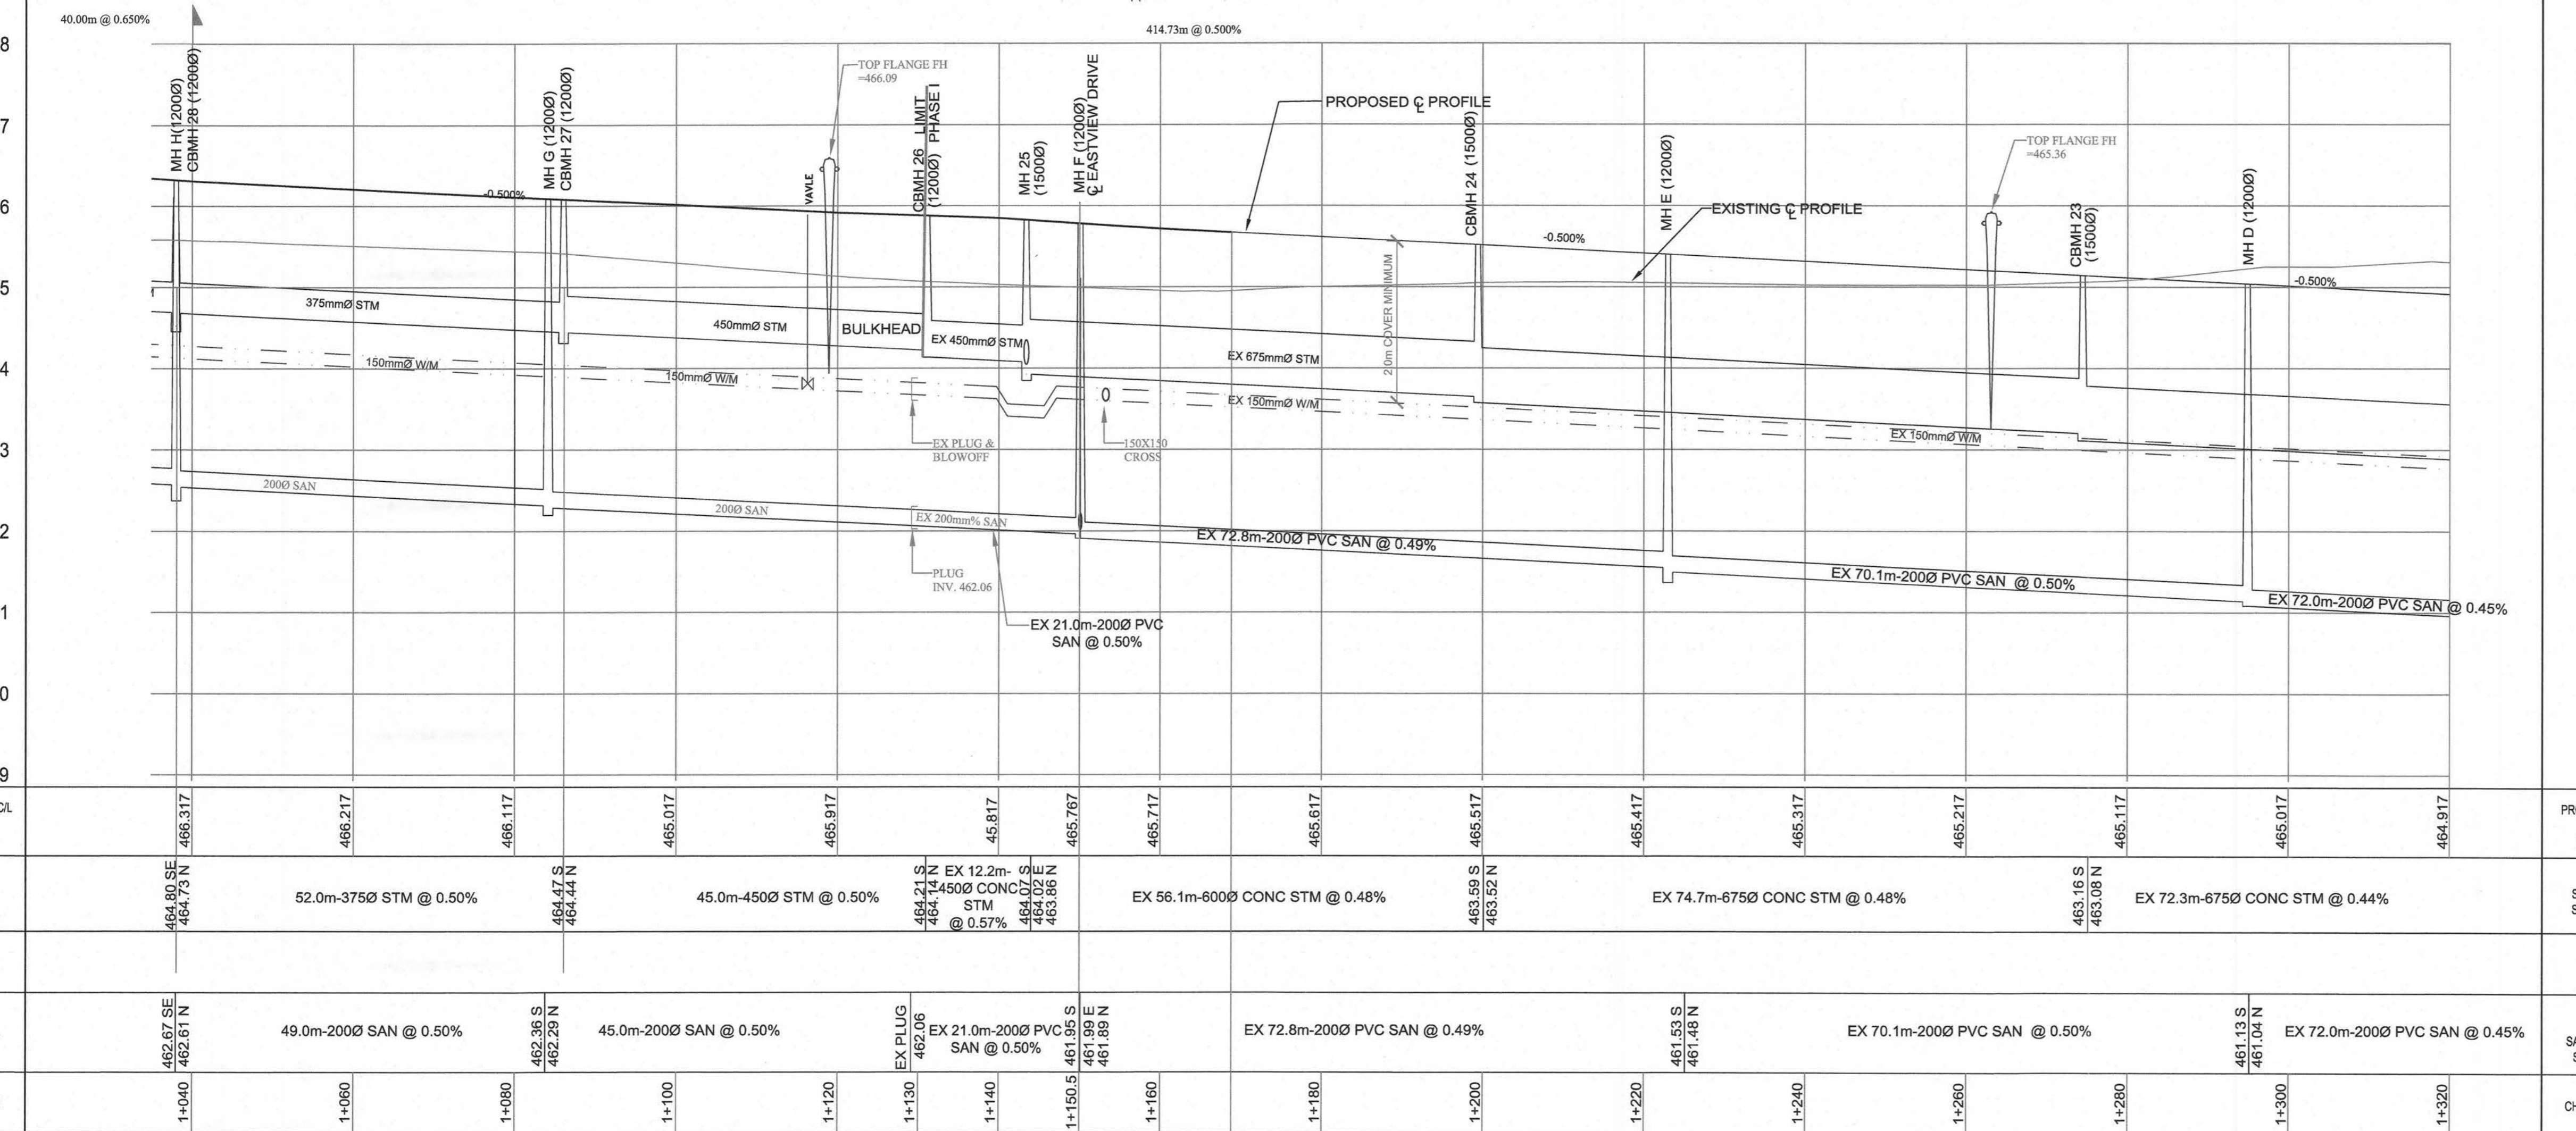

No.	DESCRIPTION	DATE	INTL.
3	AS-CONSTRUCTED U/G SERVICES	20/07/07	KJB
2	GENERAL REVISIONS	27/10/06	KJB
1	GENERAL REVISIONS	29/09/06	KJB







CHECKED: _____ APPROVED: _____
K. J. BEHM AND ASSOCIATES INC.
 CONSULTING ENGINEERS
 60 NEW DUNDEE RD., KITCHENER, ONTARIO, N2P 2N6
 PHONE (519) 742 3510 FAX (519) 742 3462



EASTRIDGE LANDING
SUBDIVISION PHASES I AND II
 ARTHUR, ONTARIO

PLAN AND PROFILE
SCHMIDT DRIVE
 STA. 1+040 TO STA.1+320

DRAWN	SM	SCALE	1 : 500	DWG. No.	1
DESIGN	KJB	DATE			
CHECKED	KJB				
PROJECT No.	260608	GENERAL REVISIONS	27/10/06	KJB	

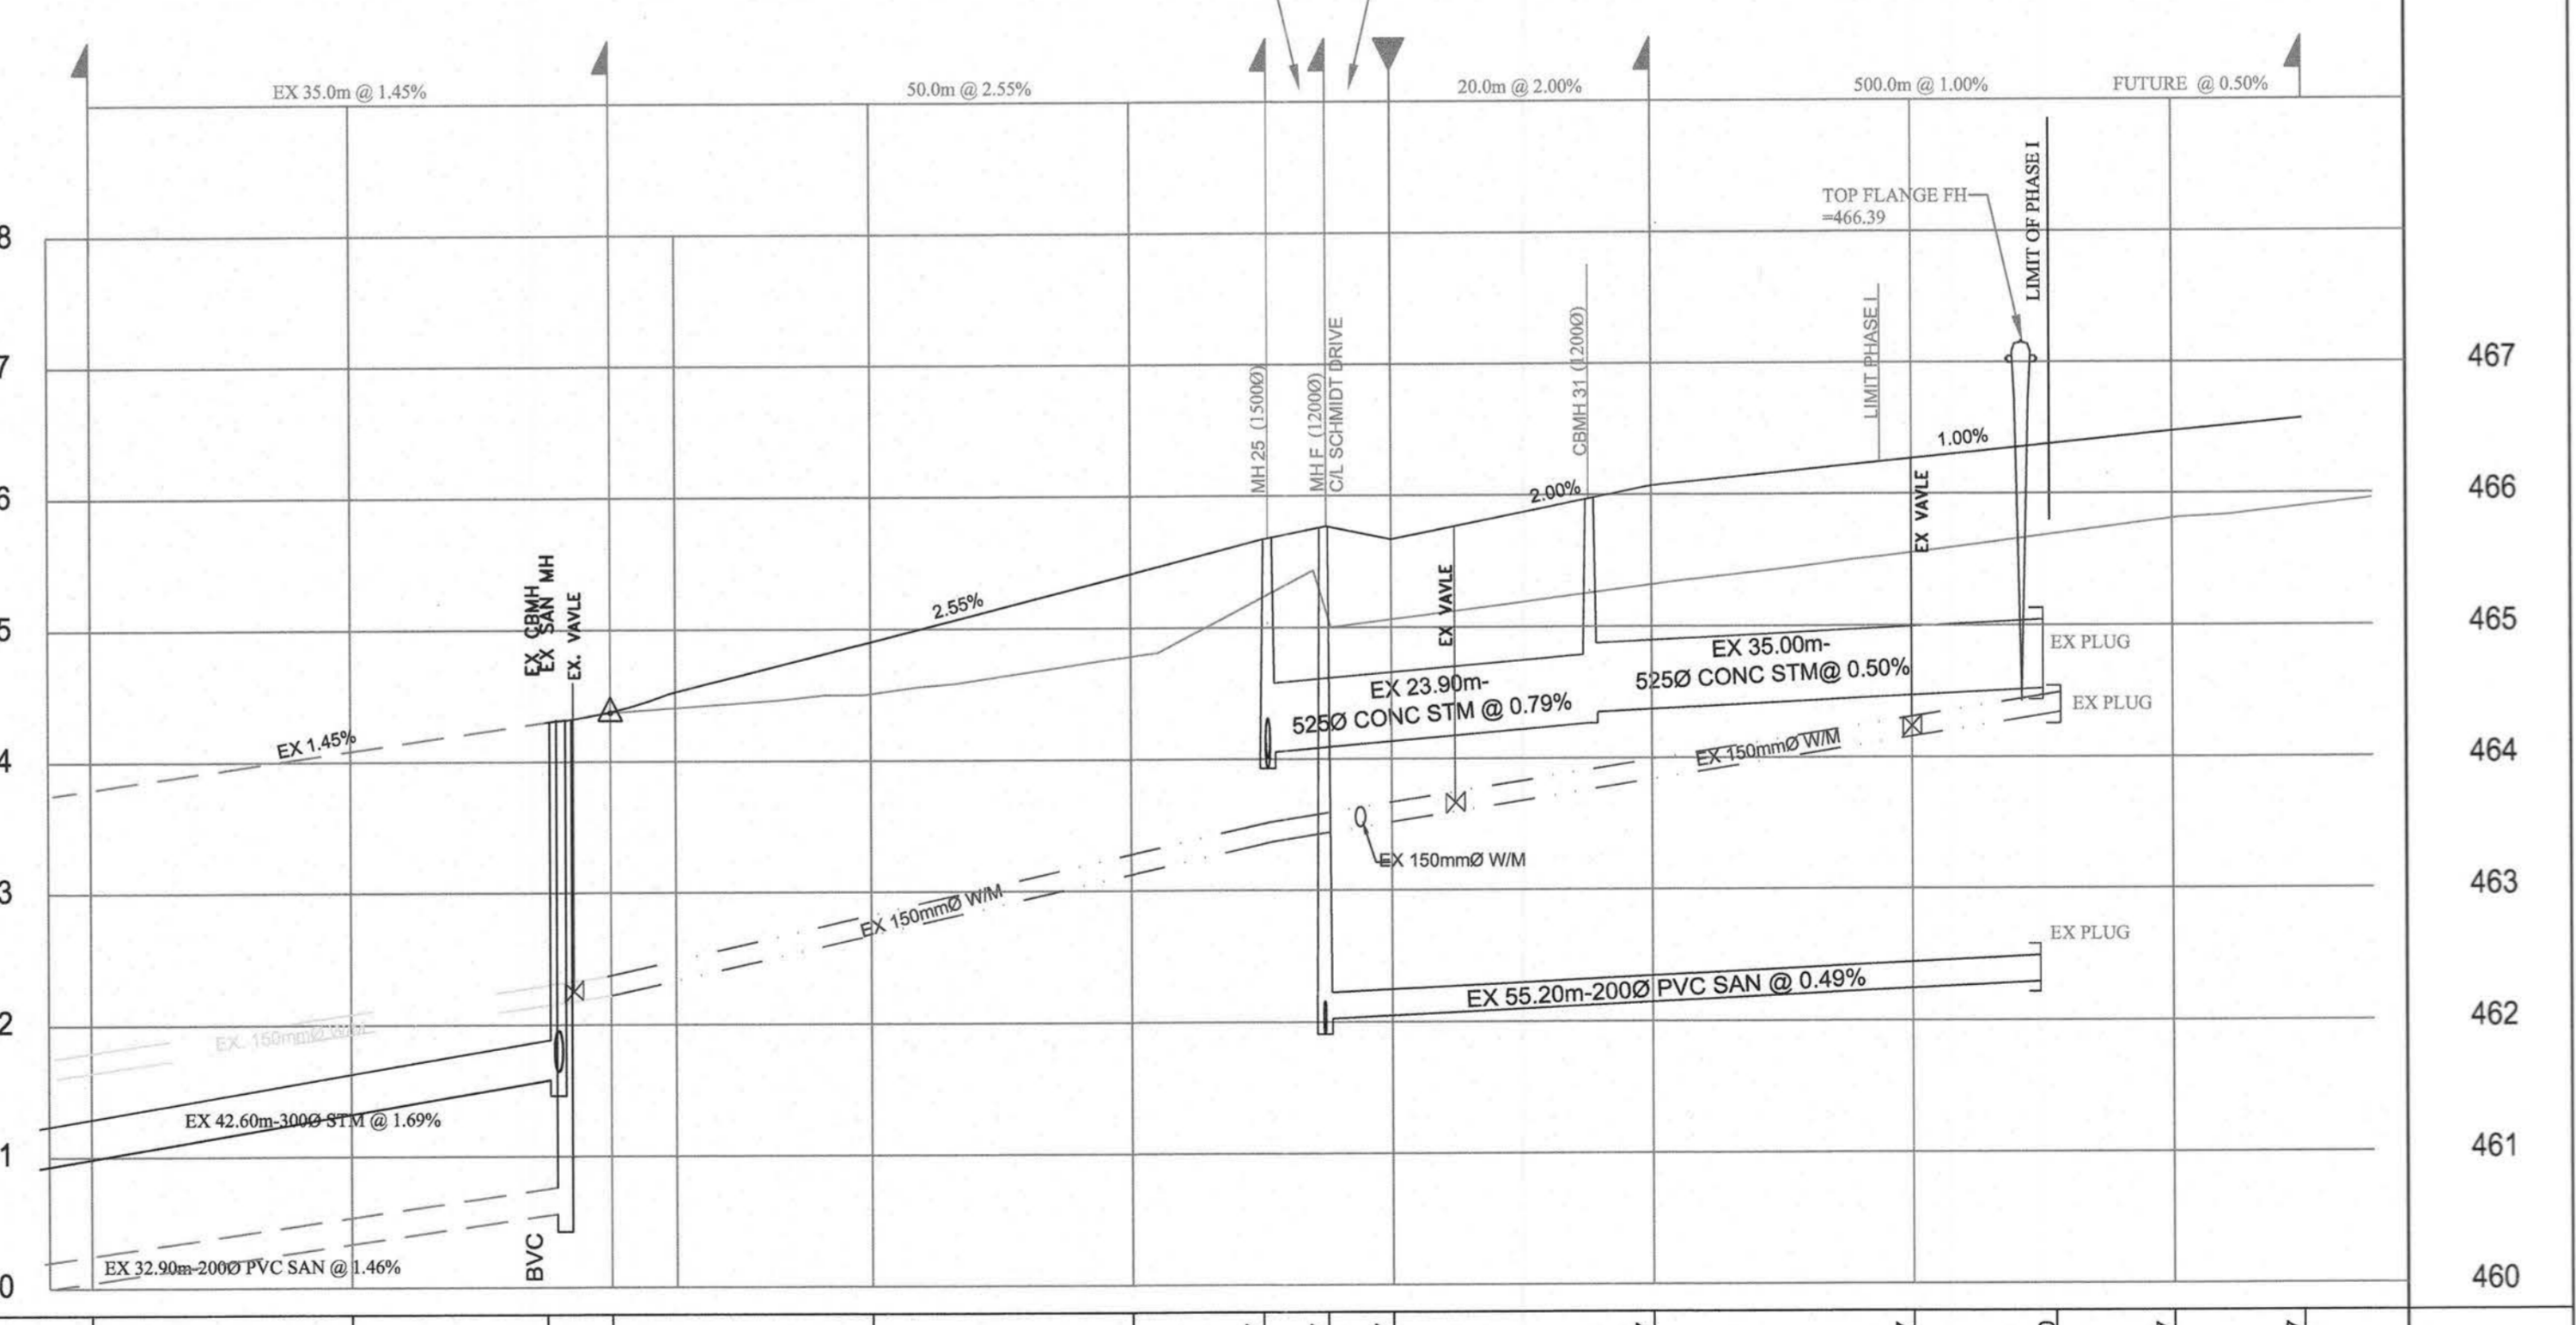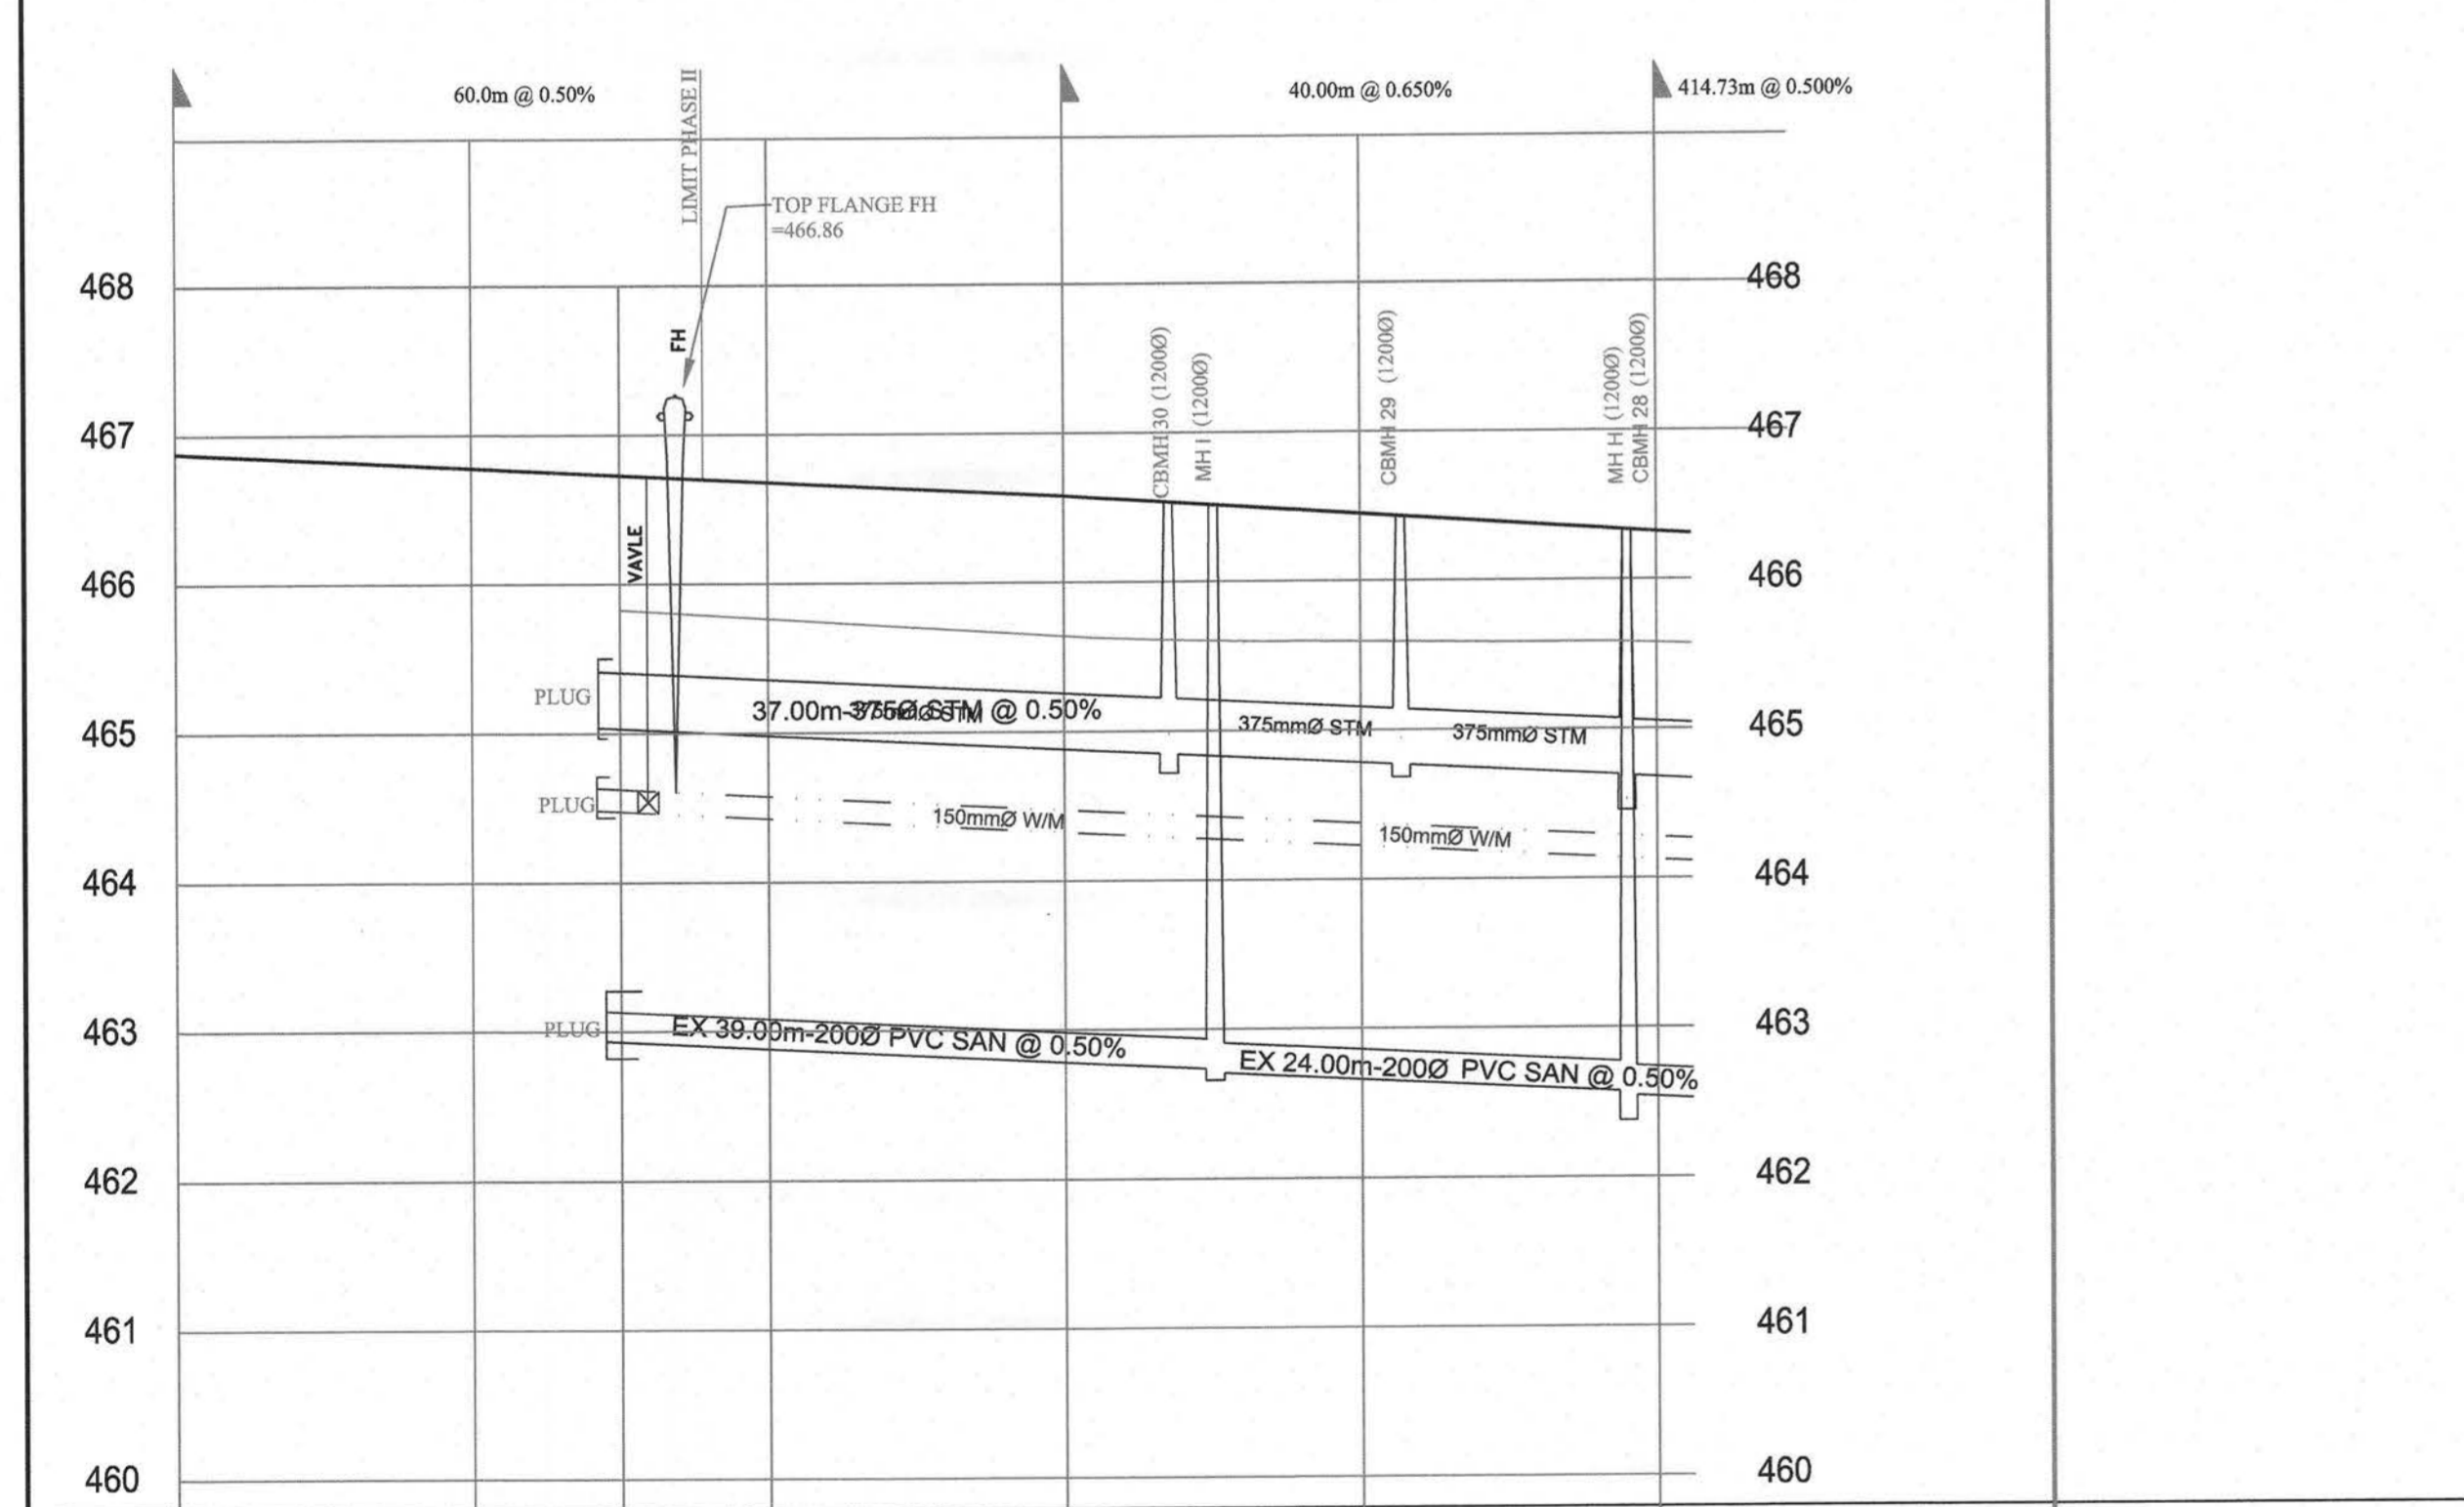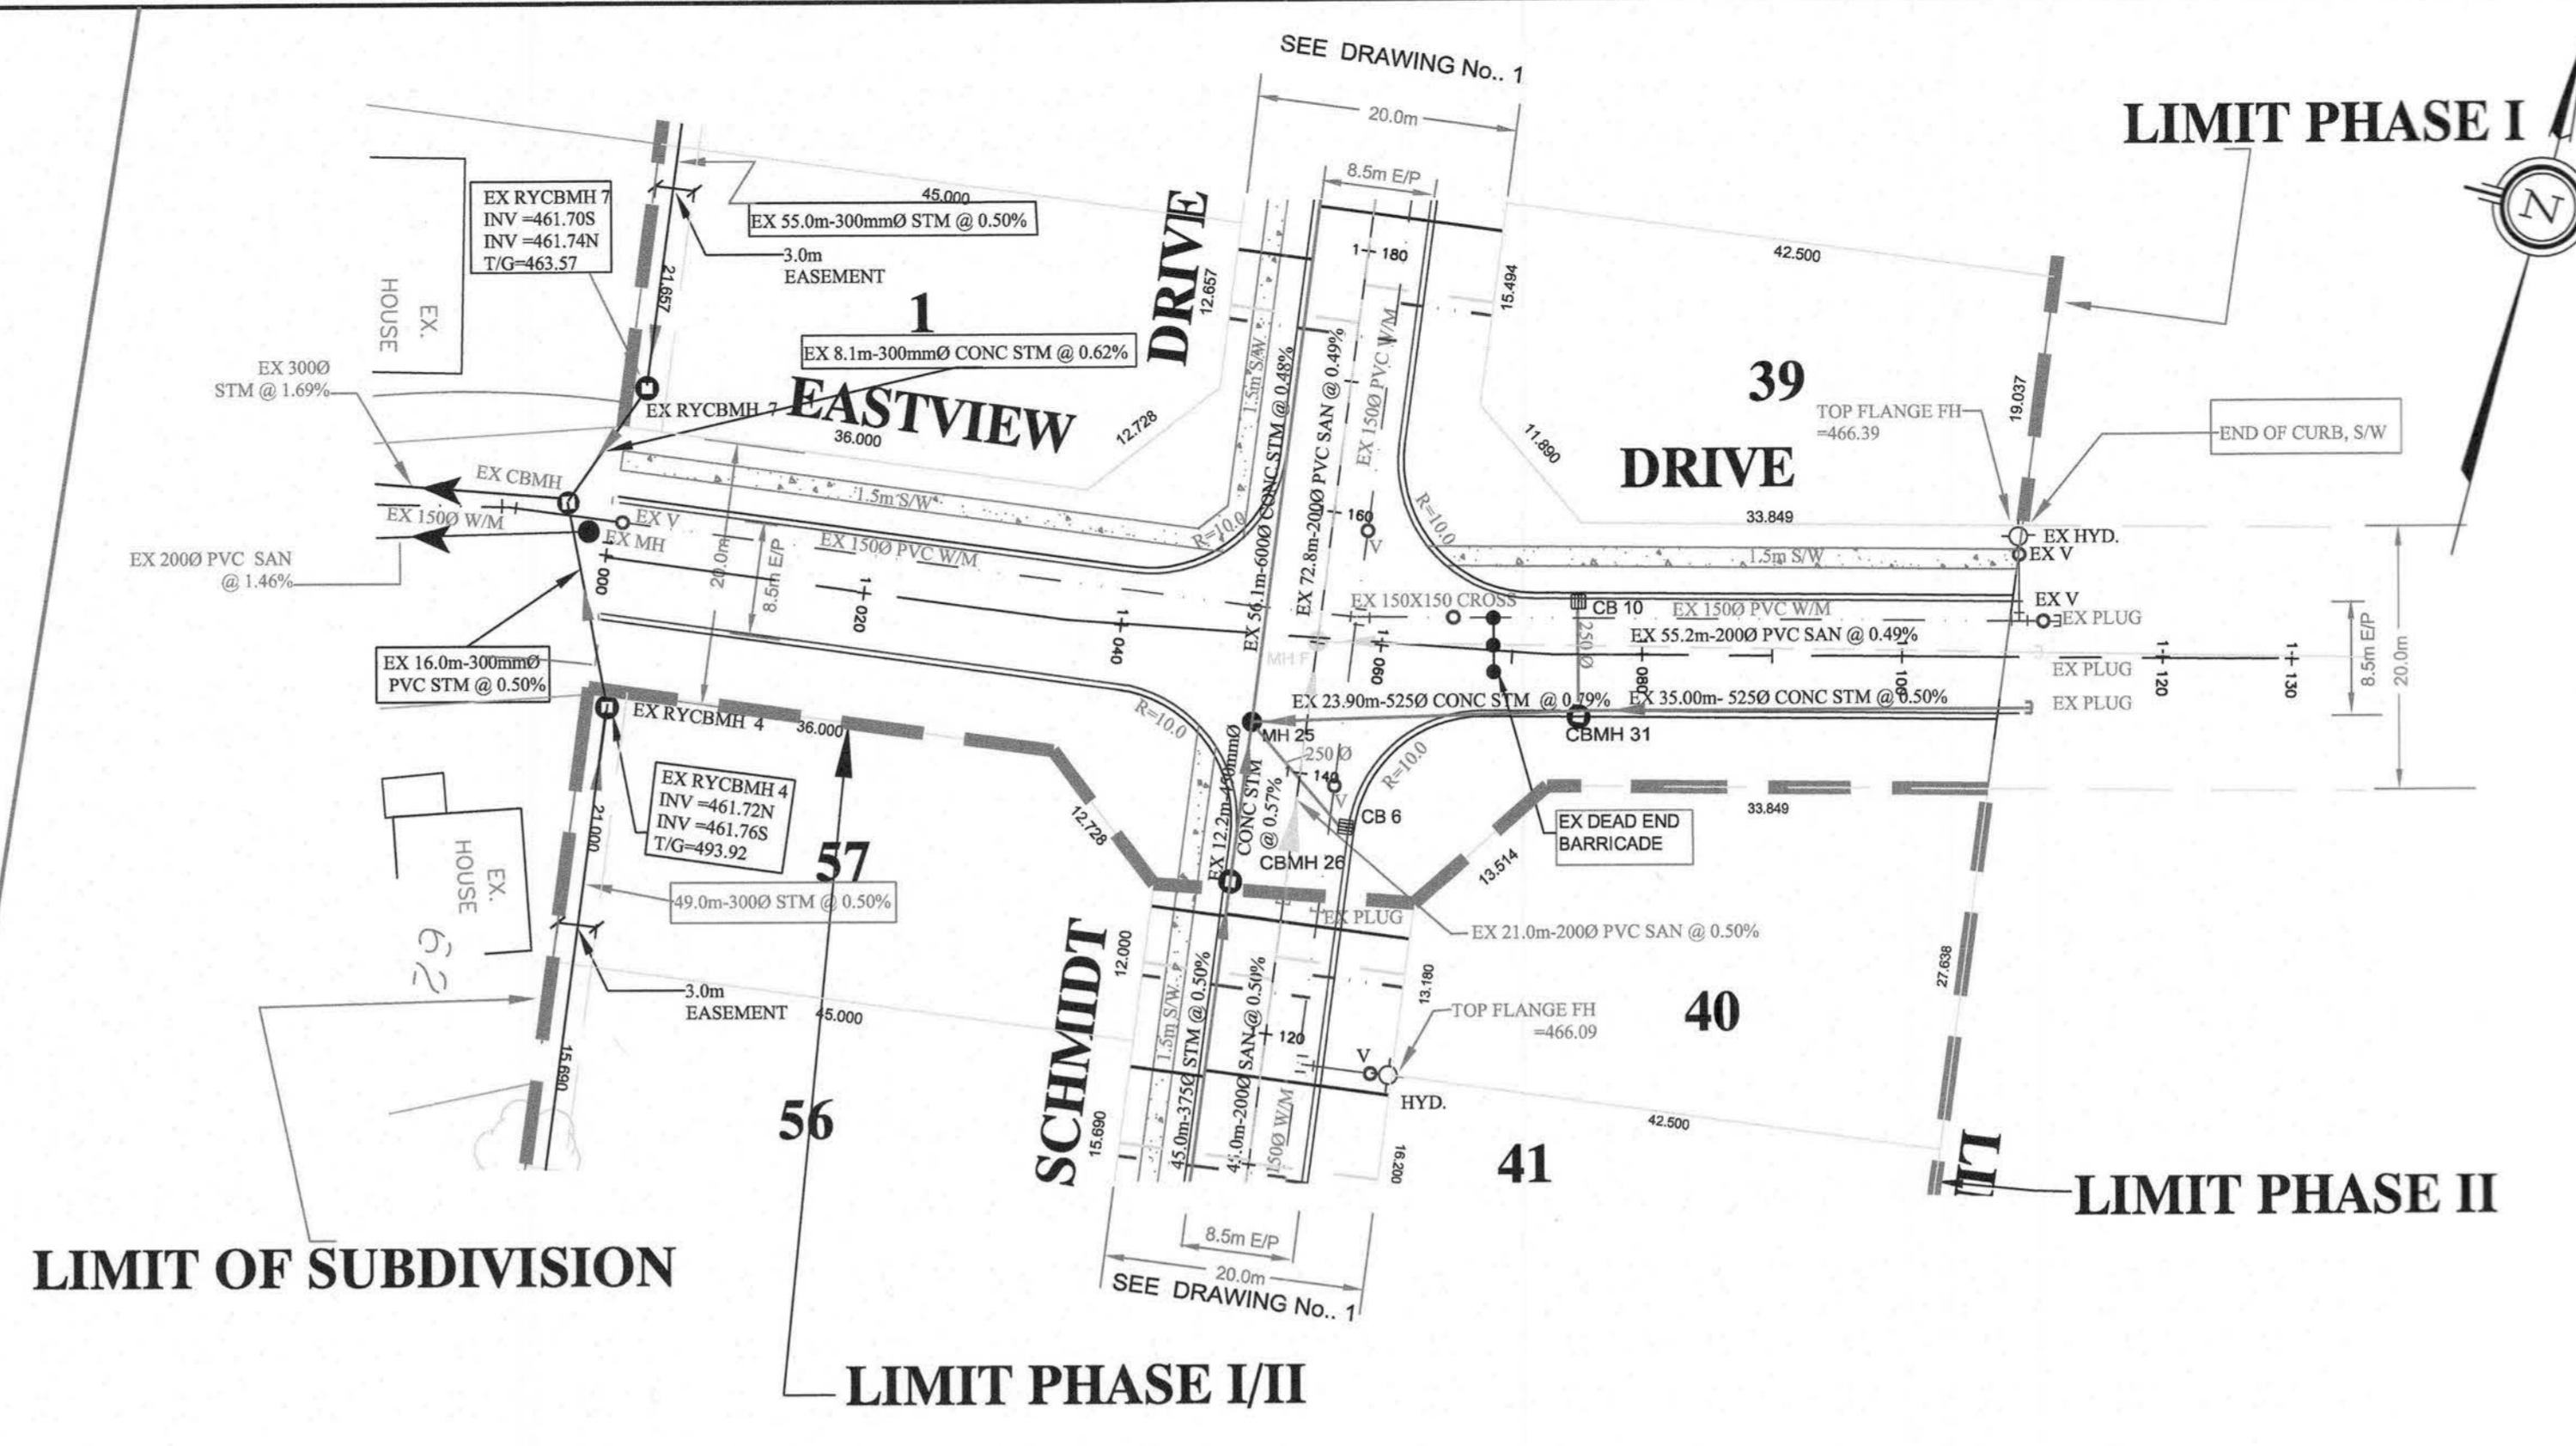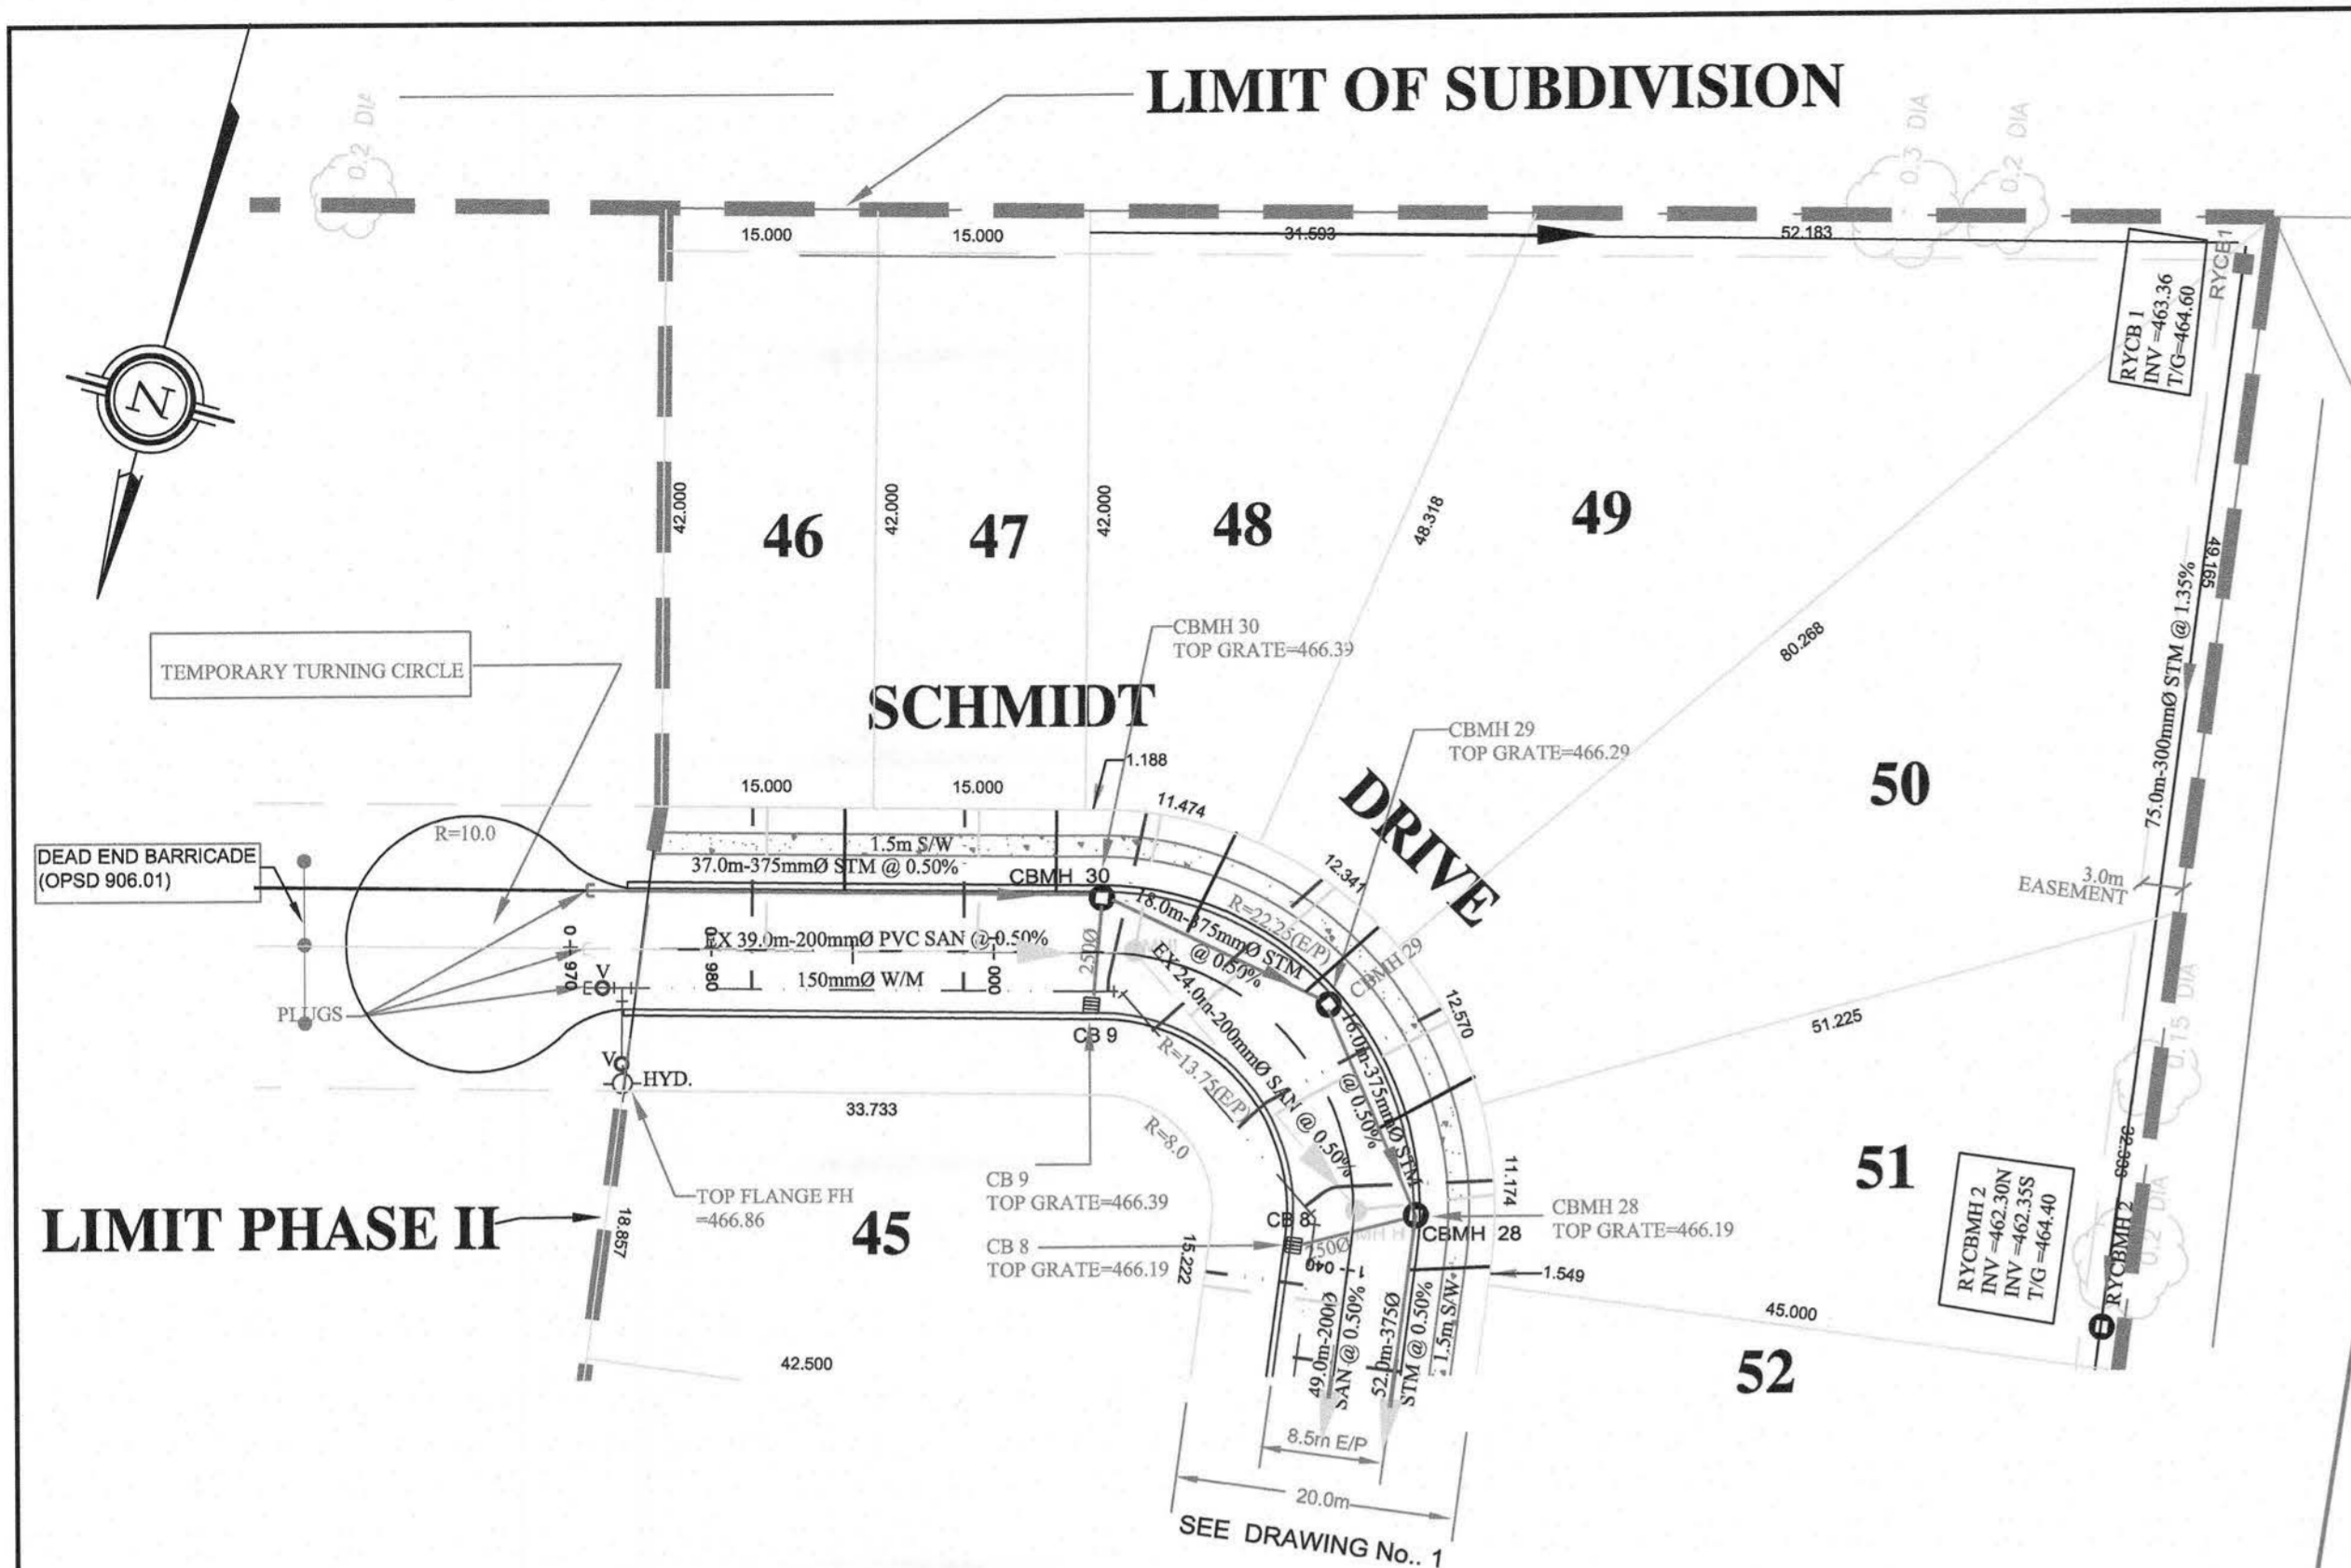


PROPOSED CL ROAD GRADE	466.877	466.777	466.677	466.577	466.447	466.317	466.177	466.037	440.137	440.017	439.897	356.737	356.6
------------------------	---------	---------	-------

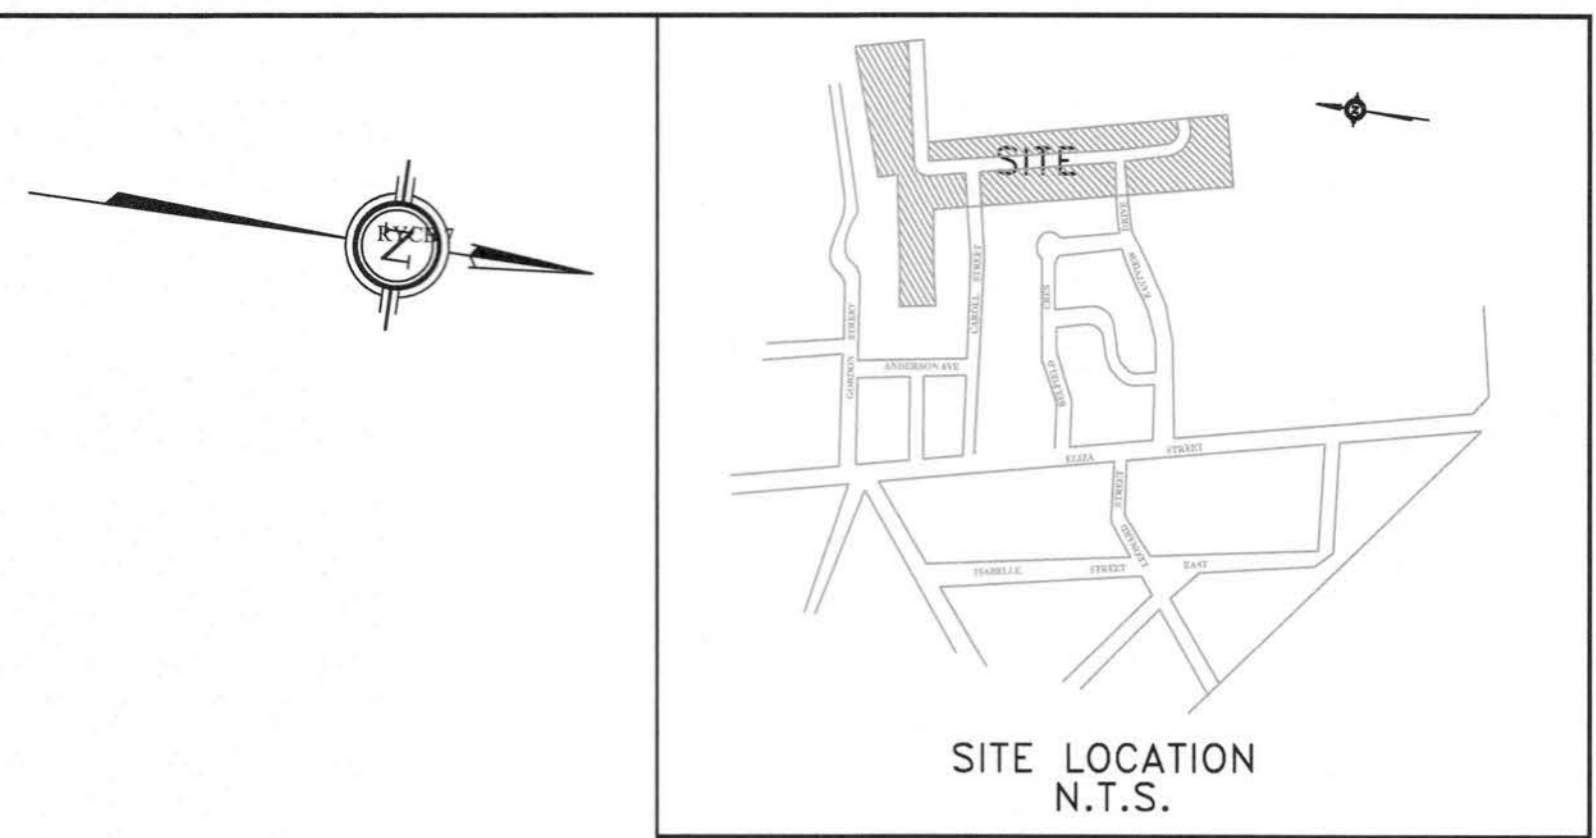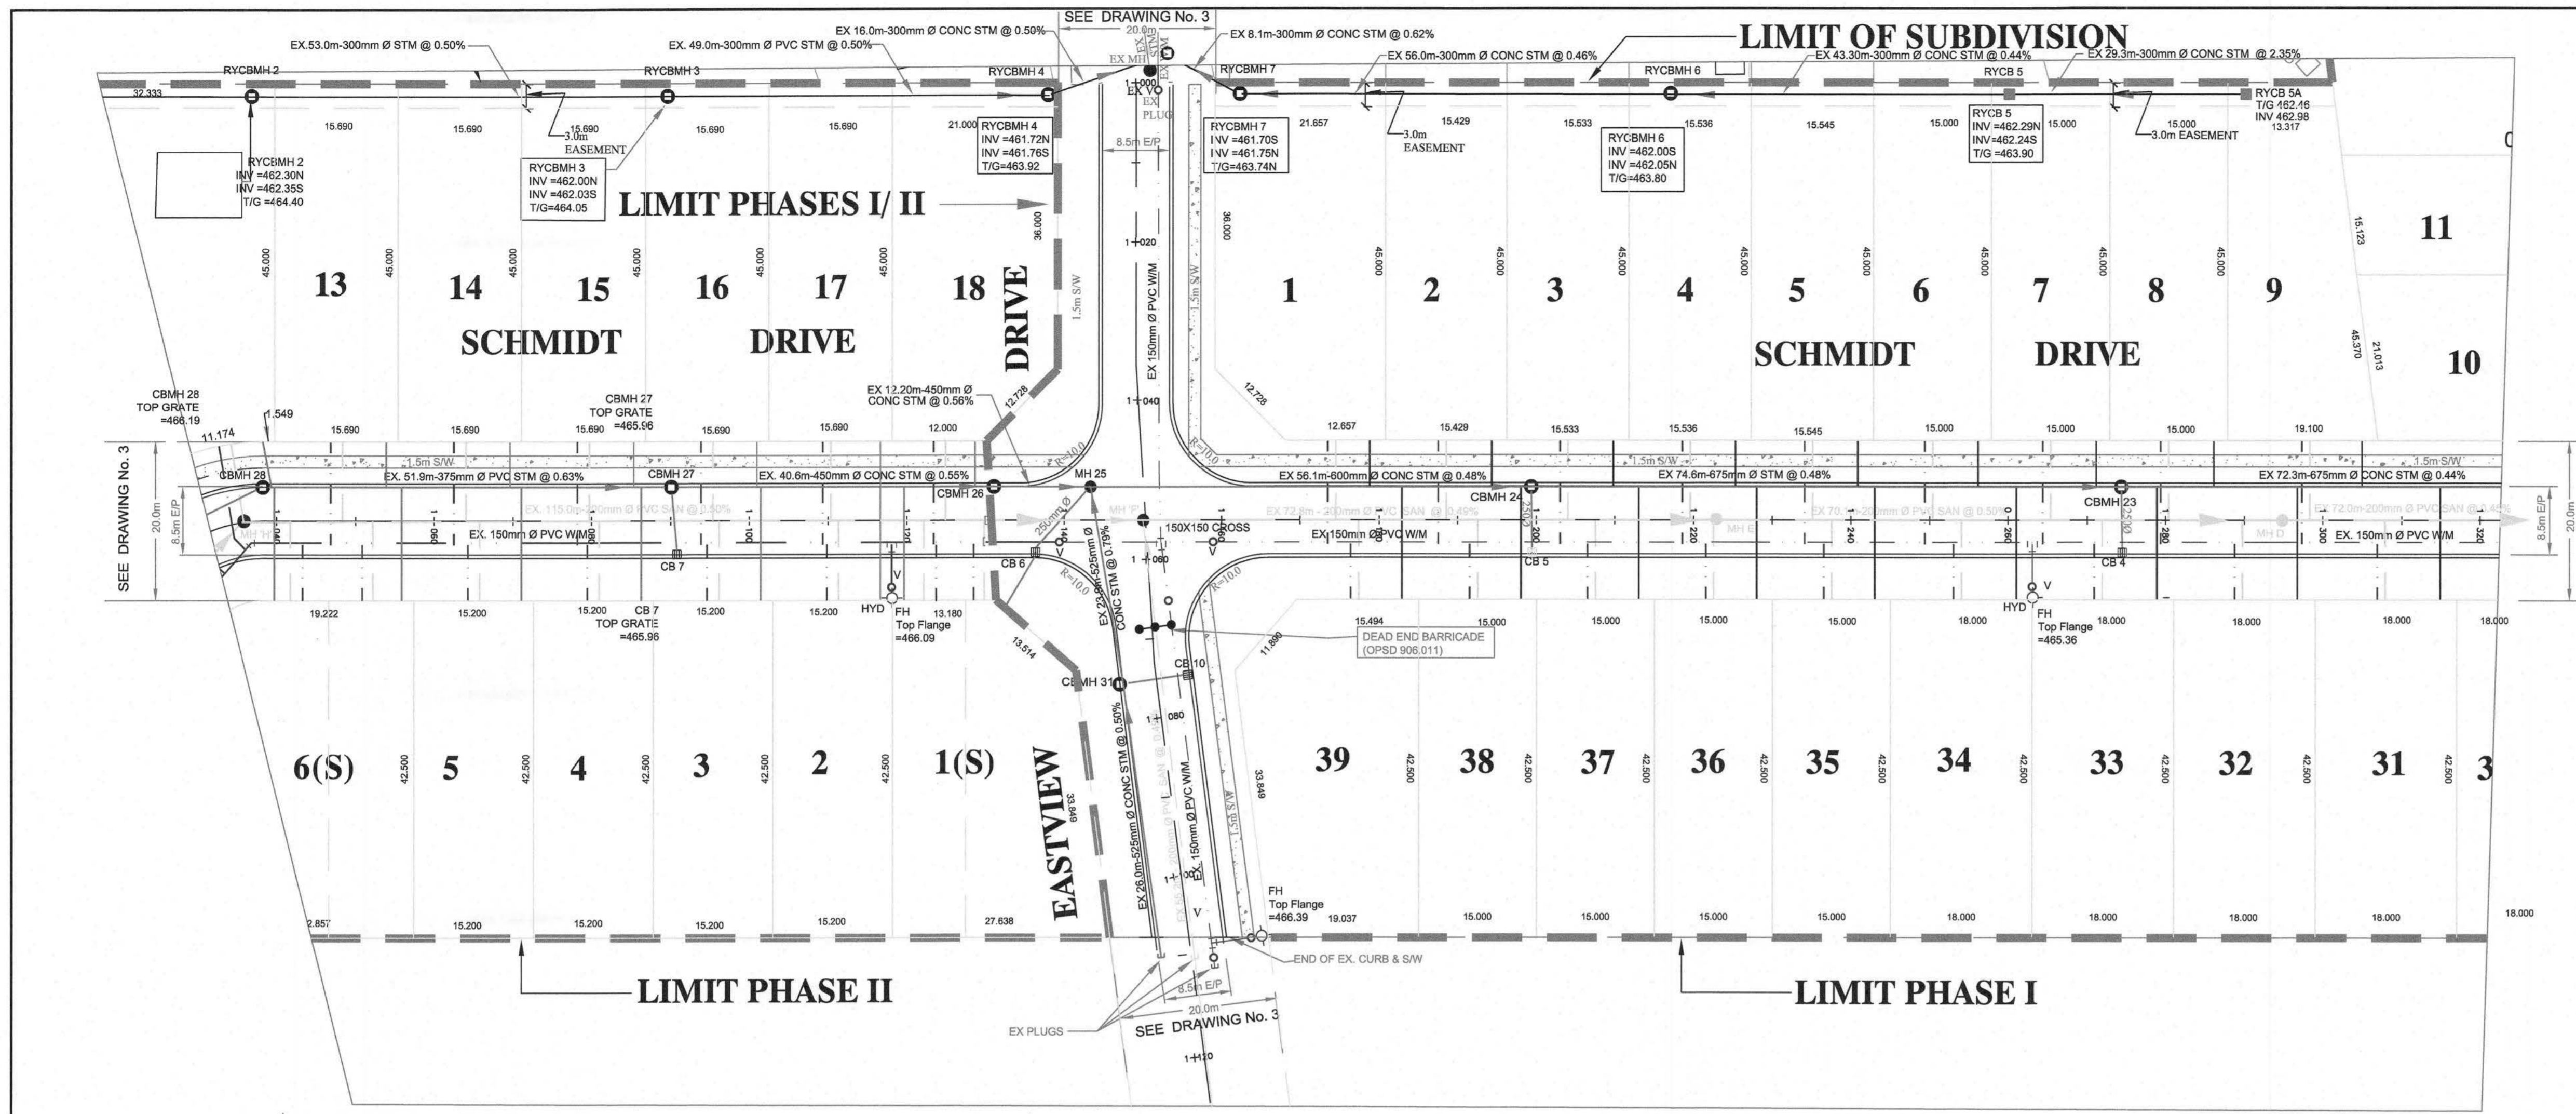

BENCH MARKS:

- NOTES:**
- 150mmØ Watermain shall be C900 PVC Class 150(DR18), B13.3 with Ring-Tie joints and Tracer Wire. Tracer Wire shall be 12 gauge, 7 strand copper with plastic coating and shall be connected to both on bottom flange of fire hydrant. 30mmØ Watermains shall be Type 'K' copper pipe. Watermains and services shall be installed minimum 2.0 m below finished grade above the main or service.
 - Watermain fittings - Ductile iron, mechanical joint, AWWA C110 approved, pressure rating 1500 kPa. -PVC bends and tees to be used with mechanical joint restraints.
 - Watermain valves shall be Mueller "Super Seal" Resilient Gate Valve, mechanical joint.
 - Watermain Valve Boxes shall be VB3100, 3 piece No. 6 round base screw type as manufactured by BIBBY-ST CROIX FOUNDRIES INC., Cambridge, Ontario.
 - Hydrants shall be Canada Valve New Century Type Compression or McAvity M-59, with "Storm" pumper connection. All hydrants to be painted yellow with black "Storm" cap.
 - Water services to be 20mm single Type 'K' copper pipe.
 - Anodes: DZP-24, 10.9 kg shall be installed on all connections to existing iron watermains. DZP-12, 5.4 kg shall be installed on all iron fittings, valves etc. in accordance with the Township of Wellington North Specifications.
 - Sanitary sewer shall be 200mm PVC-SDR35 meeting the current ASTM D3034 Specifications and CSA-182.2.
 - Sanitary Services shall be 100mm PVC-SDR35 meeting the current CSA-182.2 Specifications. Service connections to be at a minimum grade of 2%. All connections to new mains shall have manufactured tees. All new connections to existing mains shall use stainless steel straps and saddles. Sanitary Services shall be 100mm PVC-SDR35 meeting the current.
 - Sanitary sewer mainline fittings shall be PVC-SDR35 meeting the current ASTM D3034-73 Specifications and CSA-182.2.
 - Storm sewers 375mm and less shall be either Concrete E.S. or PVC Ultra-Rib as per CSA-182.4.
 - All storm services shall be 100mm PVC-SDR28 and connected to mainline with prefabricated tee or "Koo-N-Tee".
 - All catchbasin leads (250mm Single, 300mm Double) shall be PVC-SDR35.
 - All sewer pipes and watermains to be installed in Class 'B' bedding per OPSD 802.01 and 802.03.
 - Pavement design for all roads shall be: 150mm Granular 'B' road base 50mm H.4 Binder Course Asphalt 40mm H.L.3 (fine) Surface Course Asphalt
 - Concrete Curbs and sidewalks shall be poured using 30MPa strength @ 28 days.
 - All watermains and sewers to be tested in accordance with Township of Centre Wellington Specifications or as noted in the Contract Documents.
 - Road subdrains to be installed if required as determined by site conditions at time of construction. Subdrains shall be 100mmØ perforated plastic drainage tile c/w geotextile filter sock.
 - Concrete Curb to be barrier as per OPSD 600.10
 - Water Service Boxes to be located at limit of easement.
 - Sump Pumps to discharge to storm services.
 - Driveways shall be: 150mm Granular 'B' 150mm Granular 'A' 50mm H.L.3C Asphalt
 - All structures shall allow for an adjustment of between 150mm-300mm with modulus.
 - This plan shall be read in conjunction with drawing #2: Grading and Erosion Control Site Plan and the approved Landscaping Plan (by others).
 - Road Section to be in accordance with Township Standard Drawing R1 (see section Drawing #03).

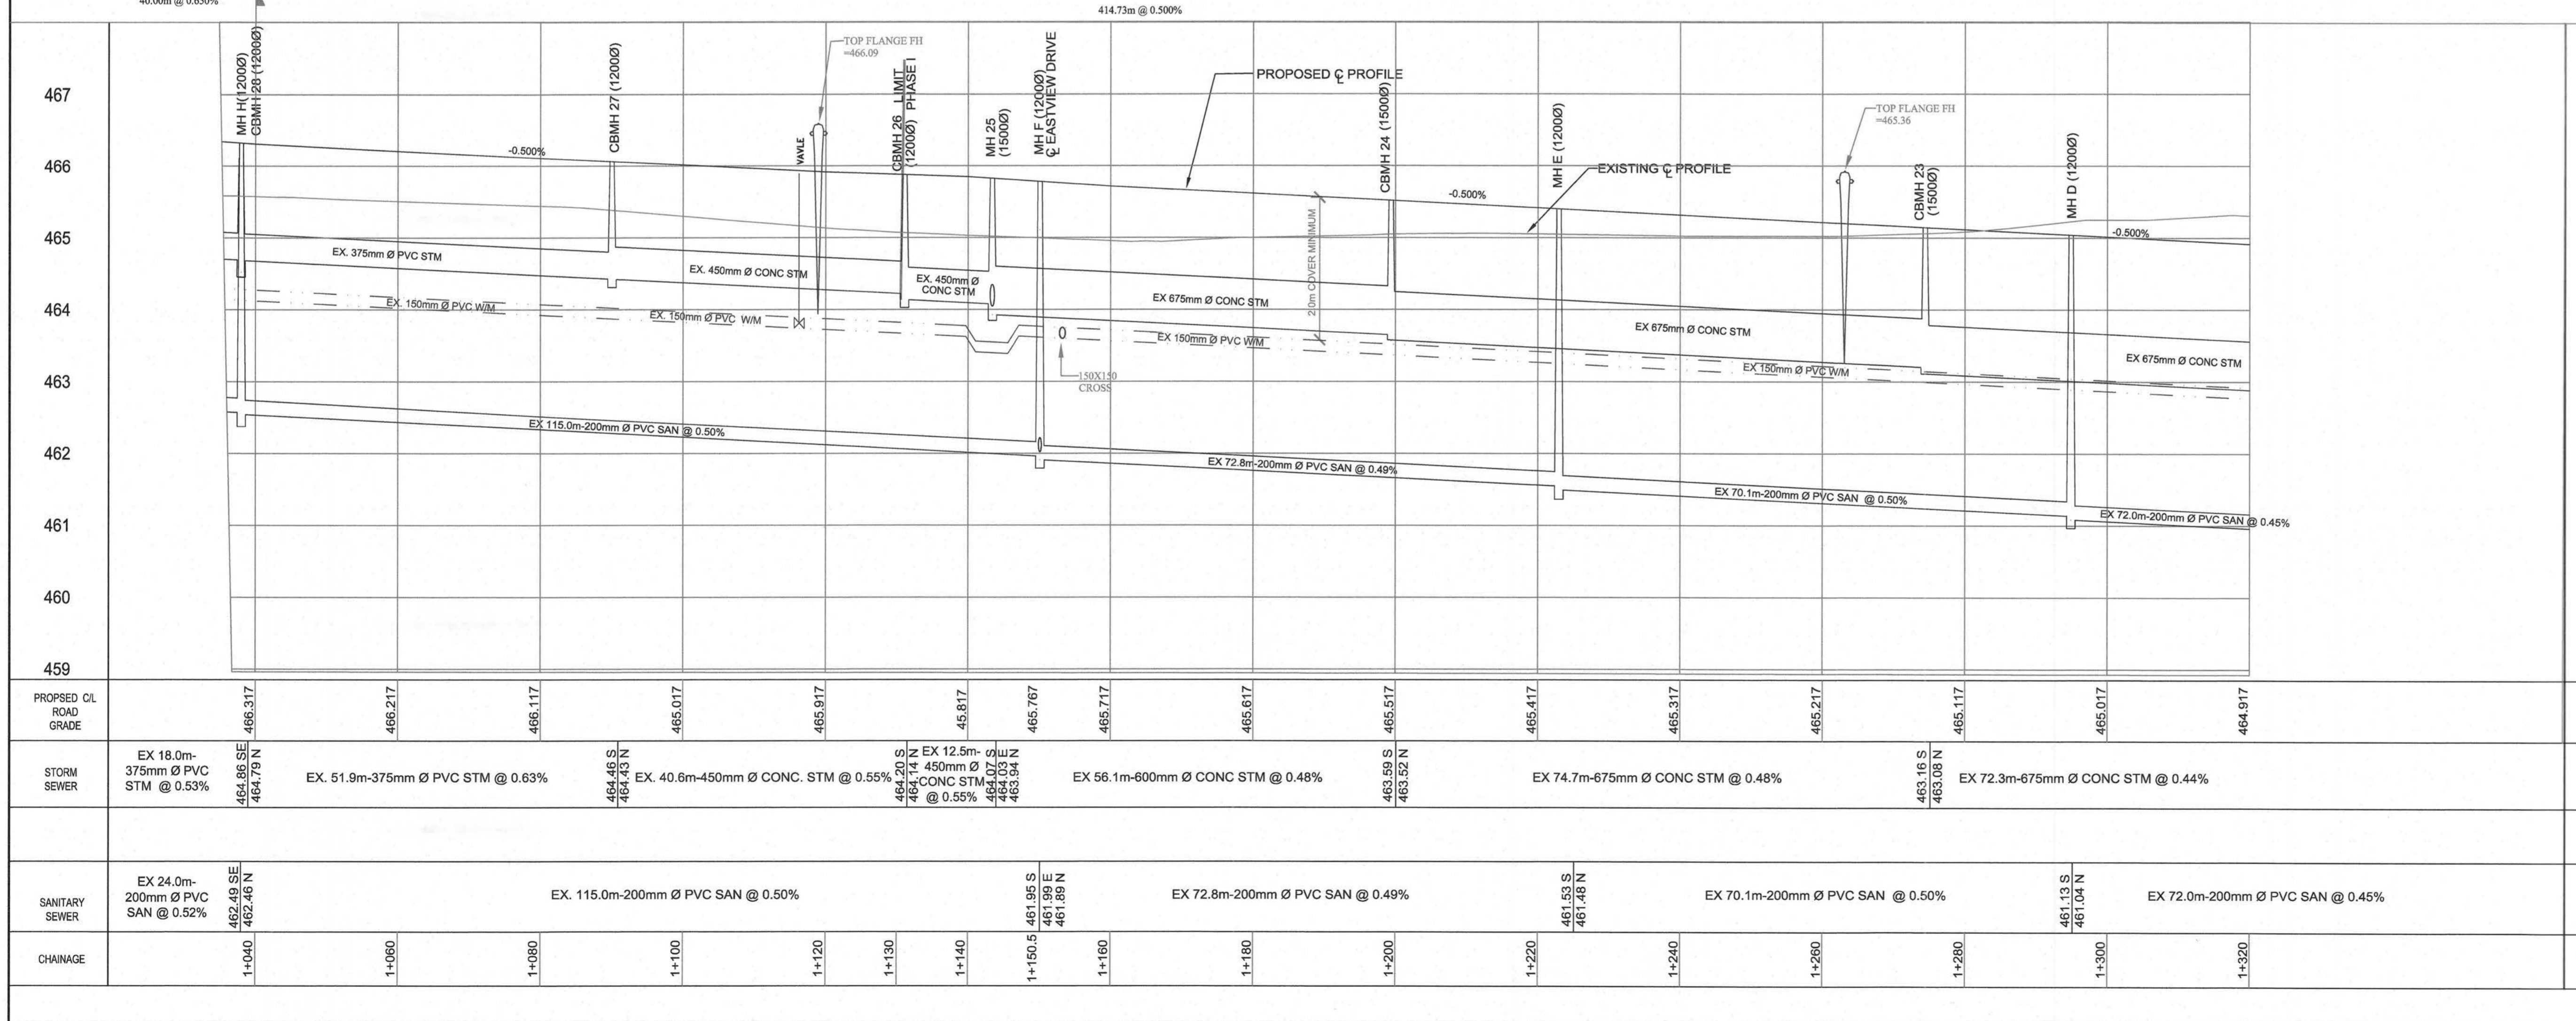

467			
466			
465			
464			
463			
462			
461			
460			
459			
PROPOSED CL ROAD GRADE	466.517	466.217	466.117
STORM SEWER	EX 18.0m-375mm Ø PVC STM @ 0.53%	EX 51.9m-375mm Ø PVC STM @ 0.63%	EX 40.6m-450mm Ø CONC. STM @ 0.55%
SANITARY SEWER	EX 24.0m-200mm Ø PVC SAN @ 0.52%	EX 115.0m-200mm Ø PVC SAN @ 0.50%	EX 72.8m-200mm Ø PVC SAN @ 0.49%
CHAINAGE	1+040	1+060	1+080
	1+100	1+120	1+130
	1+140	1+150.5	1+160
	1+180	1+200	1+220
	1+240	1+260	1+280
	1+300	1+320	
PROPOSED CL ROAD GRADE	464.86 SE	464.78 N	464.46 S
STORM SEWER	EX 56.1m-600mm Ø CONC STM @ 0.48%	EX 74.7m-675mm Ø CONC STM @ 0.48%	EX 72.3m-675mm Ø CONC STM @ 0.44%
SANITARY SEWER	EX 115.0m-200mm Ø PVC SAN @ 0.50%	EX 70.1m-200mm Ø PVC SAN @ 0.50%	EX 72.0m-200mm Ø PVC SAN @ 0.45%
CHAINAGE	1+040	1+060	1+080
	1+100	1+120	1+130
	1+140	1+150.5	1+160
	1+180	1+200	1+220
	1+240	1+260	1+280
	1+300	1+320	

6	"AS CONSTRUCTED"	26/10/10	KJB
5	GENERAL REVISIONS	30/07/10	KJB
4	GENERAL REVISIONS PHASE II	30/05/10	KJB
3	AS-CONSTRUCTED U/G SERVICES	20/07/07	KJB
2	GENERAL REVISIONS	27/10/06	KJB
1	GENERAL REVISIONS	29/09/06	KJB

REVISIONS






CHECKED: APPROVED:

K. J. BEHM AND ASSOCIATES INC.
CONSULTING ENGINEERS
60 NEW DUNDEE RD., KITCHENER, ONTARIO, N2P 2N6
PHONE (519) 742 3510 FAX (519) 742 3462

EASTRIDGE LANDING
SUBDIVISION PHASES I AND II
ARTHUR, ONTARIO

PLAN AND PROFILE
SCHMIDT DRIVE
STA. 1+040 TO STA. 1+320

DRAWN	SM	SCALE	1 : 500	DWG. No.	1
DESIGN	KJB	DATE	JUNE 2006		
CHECKED	KJB				
PROJECT No.	260606				KJB

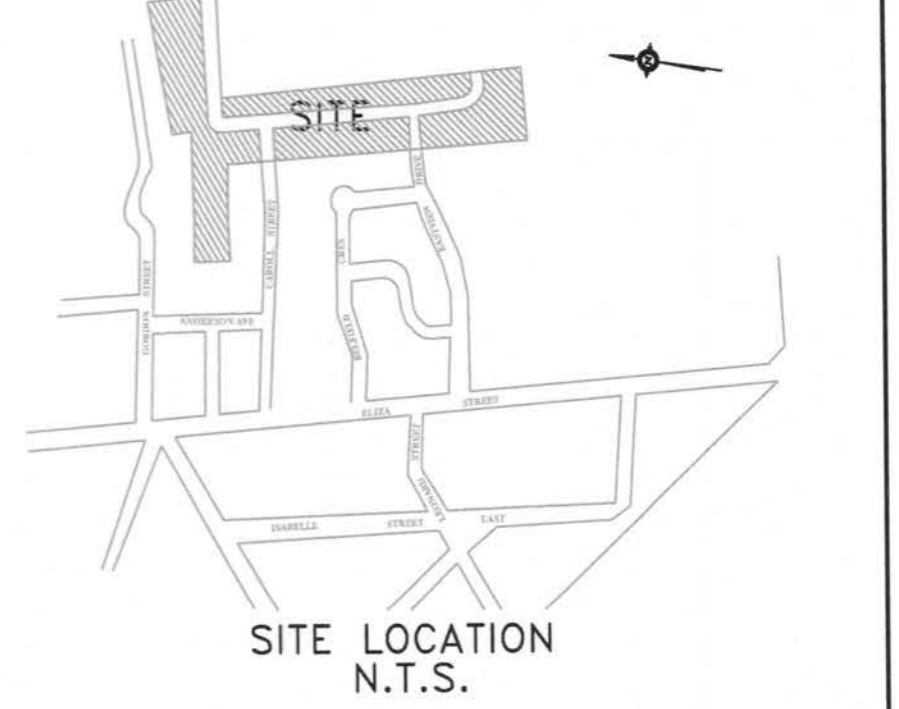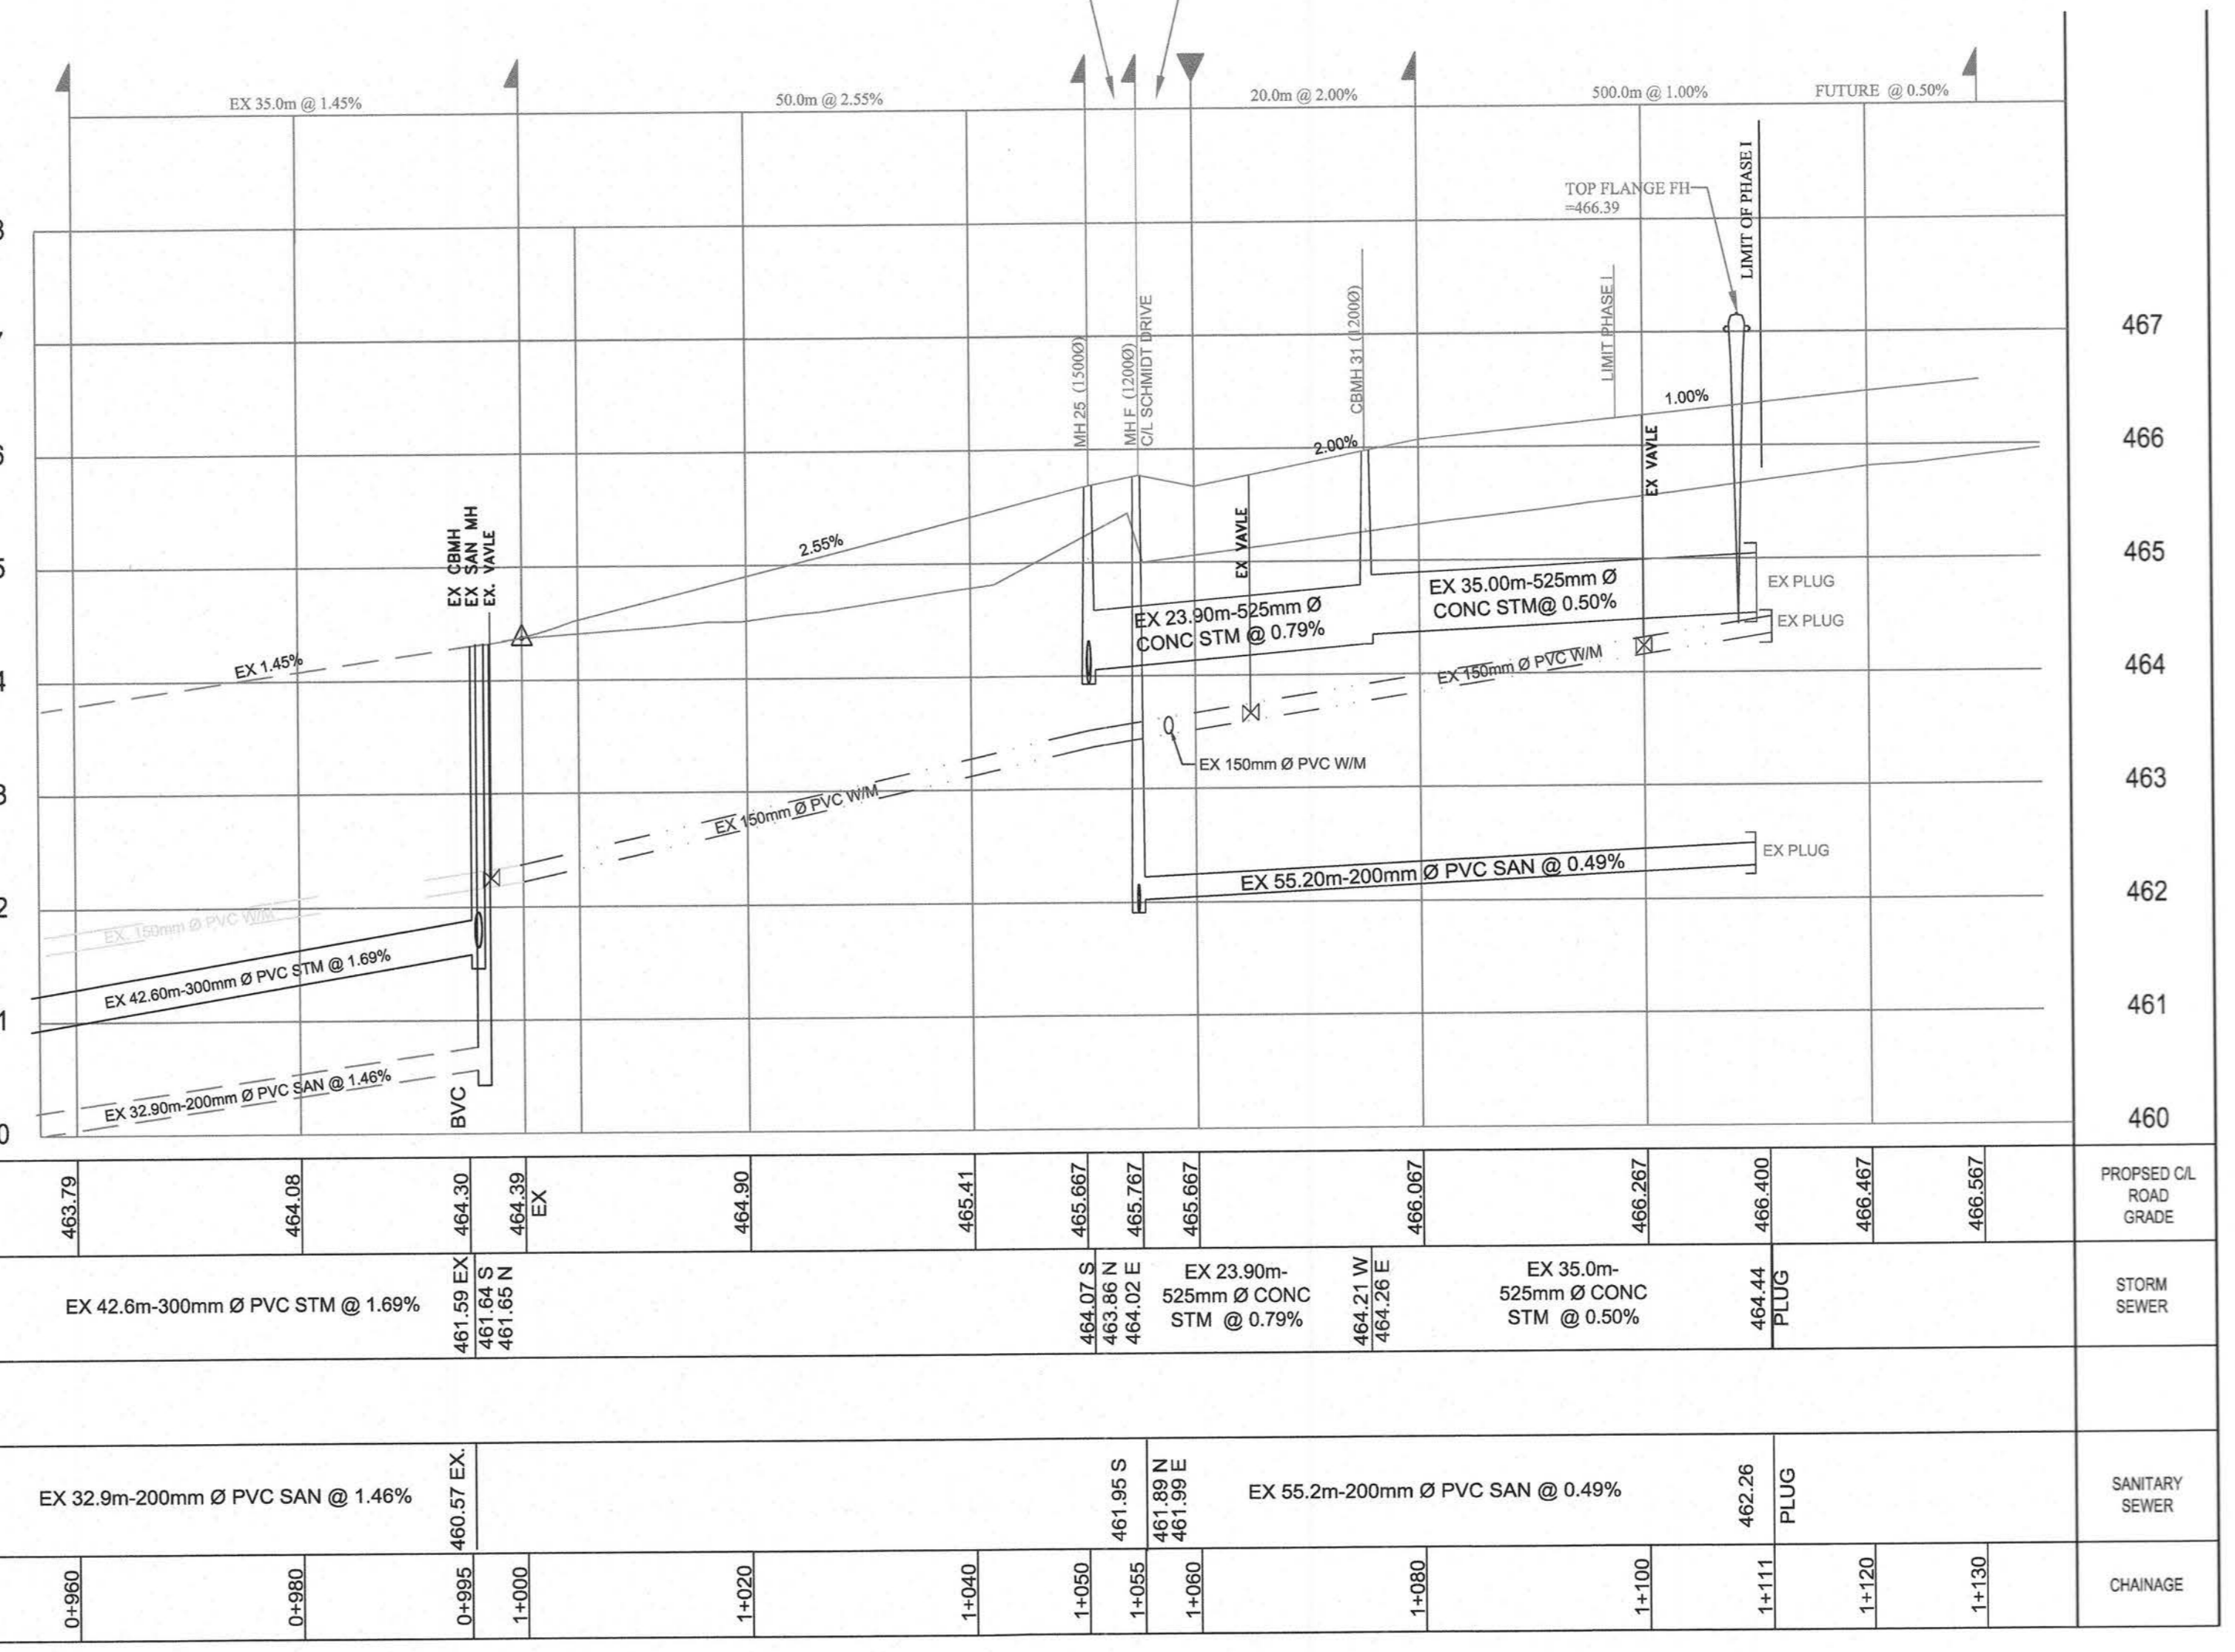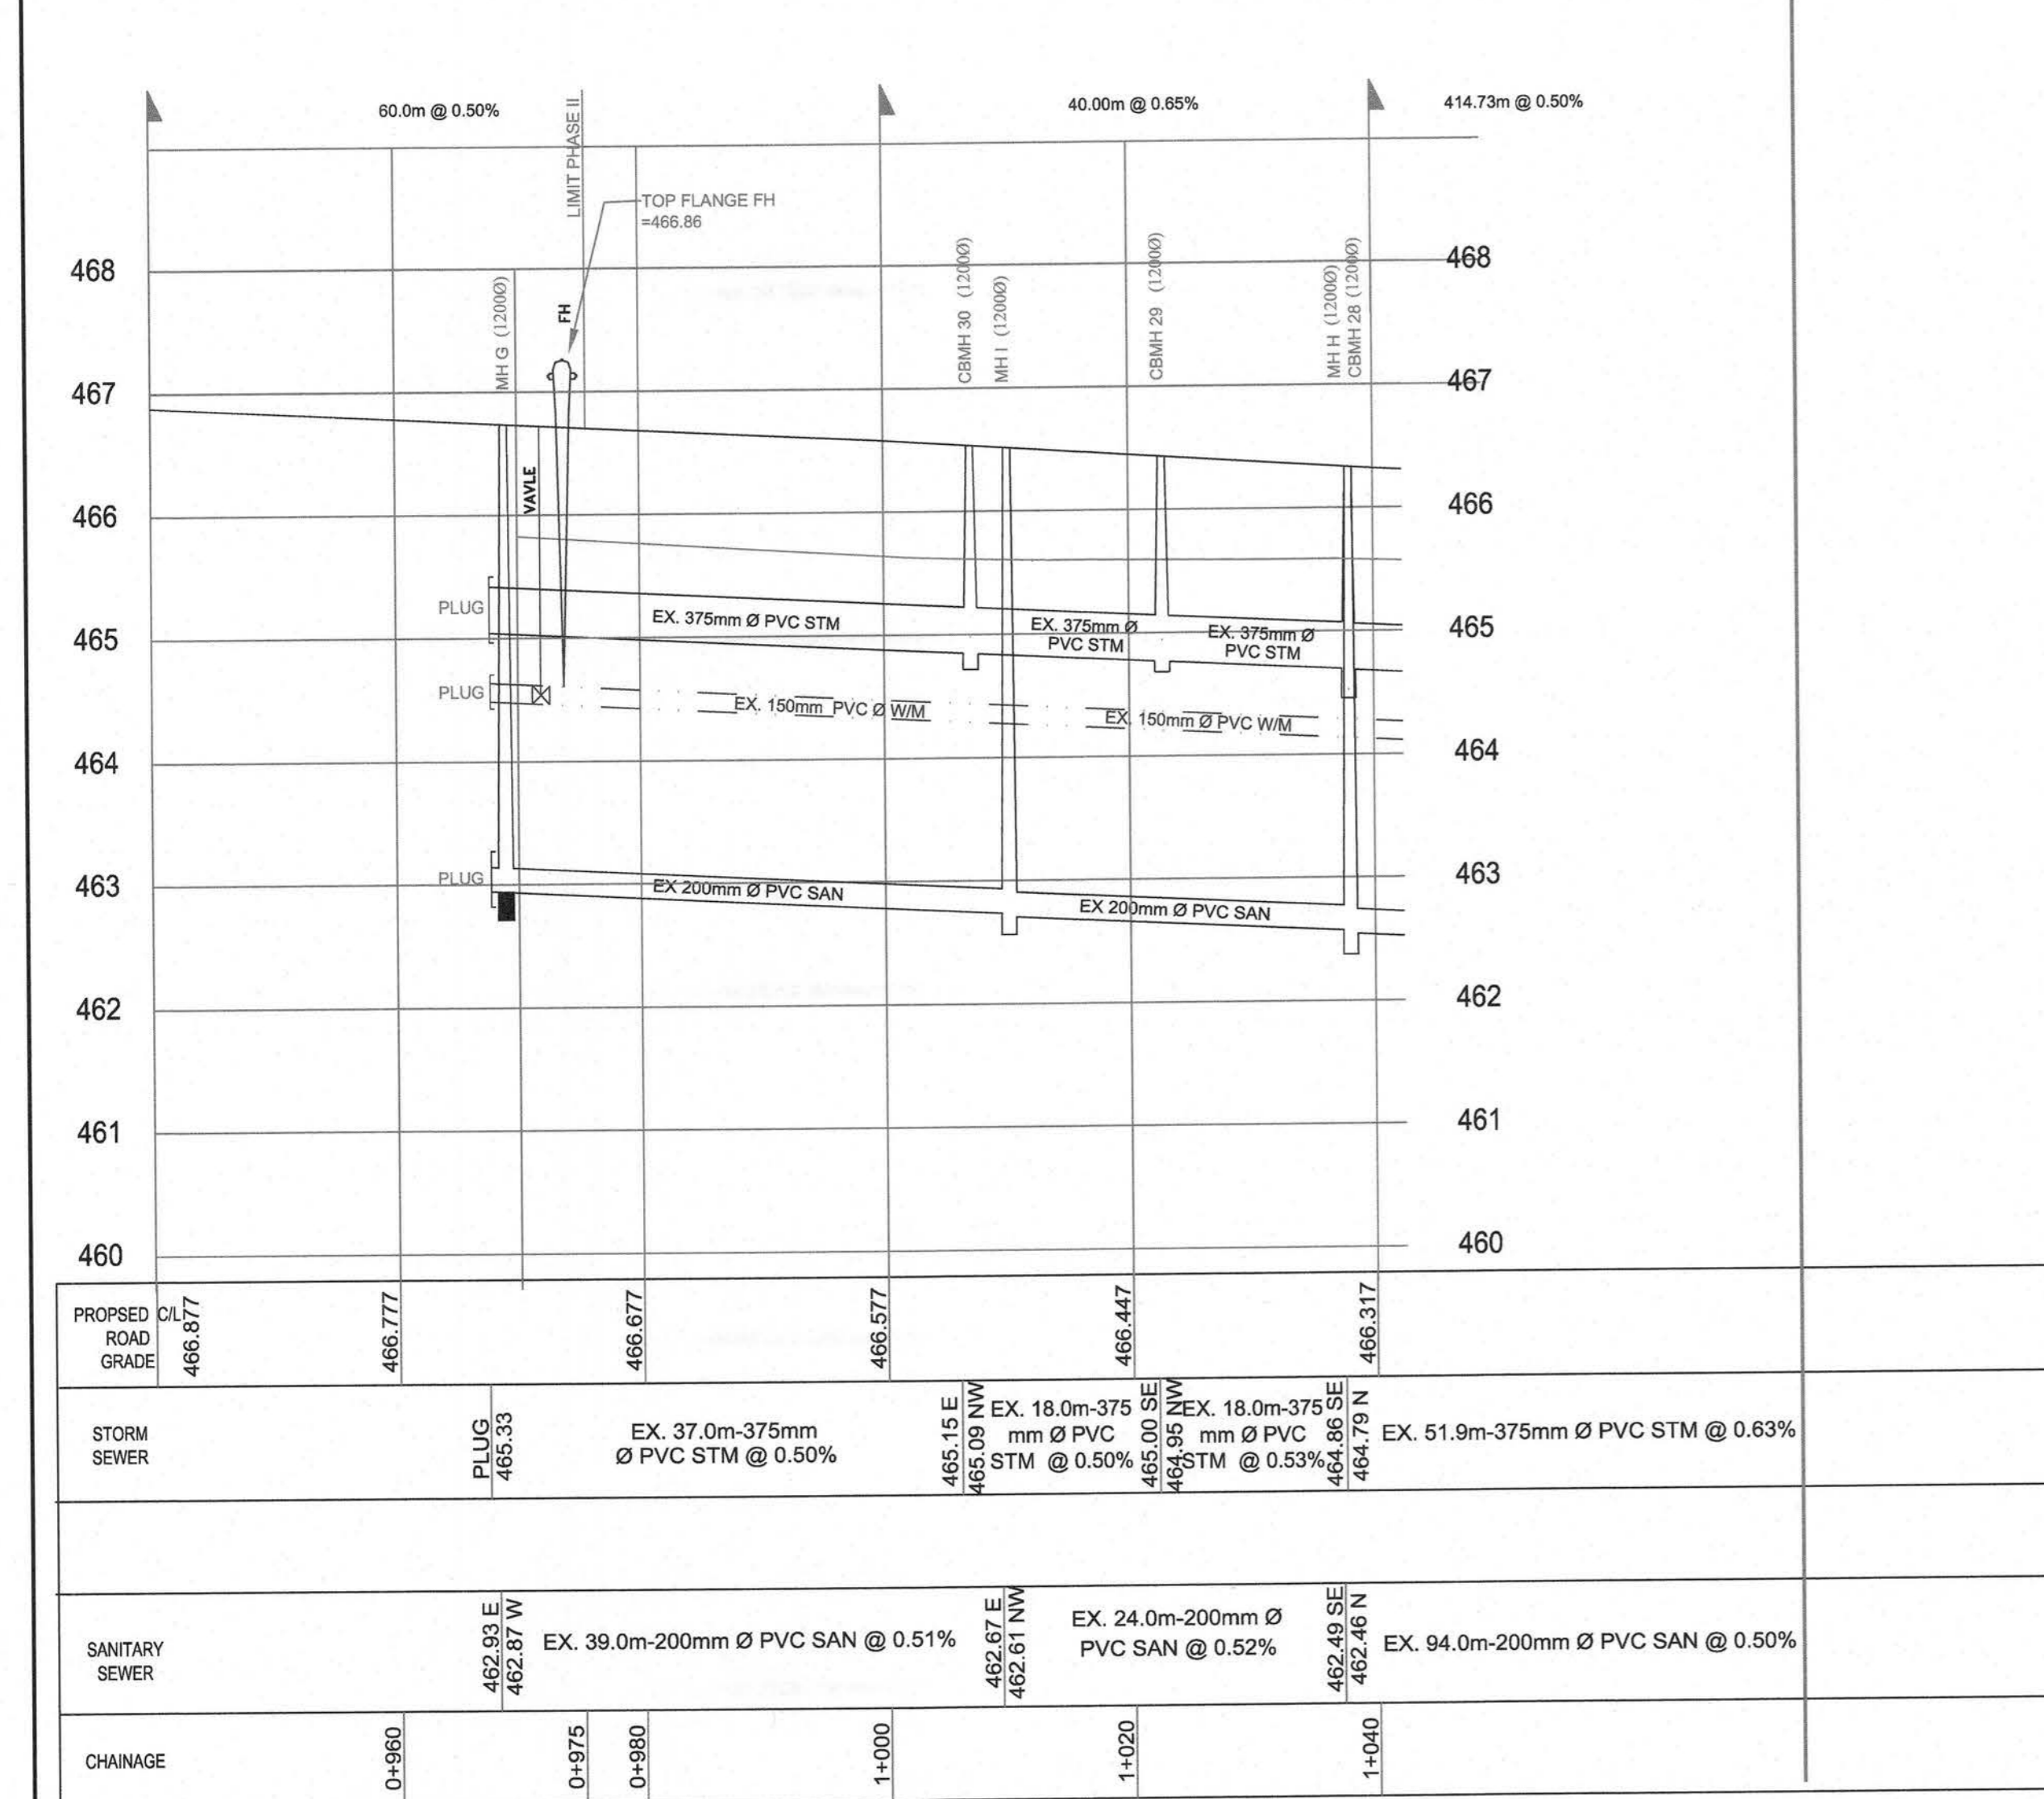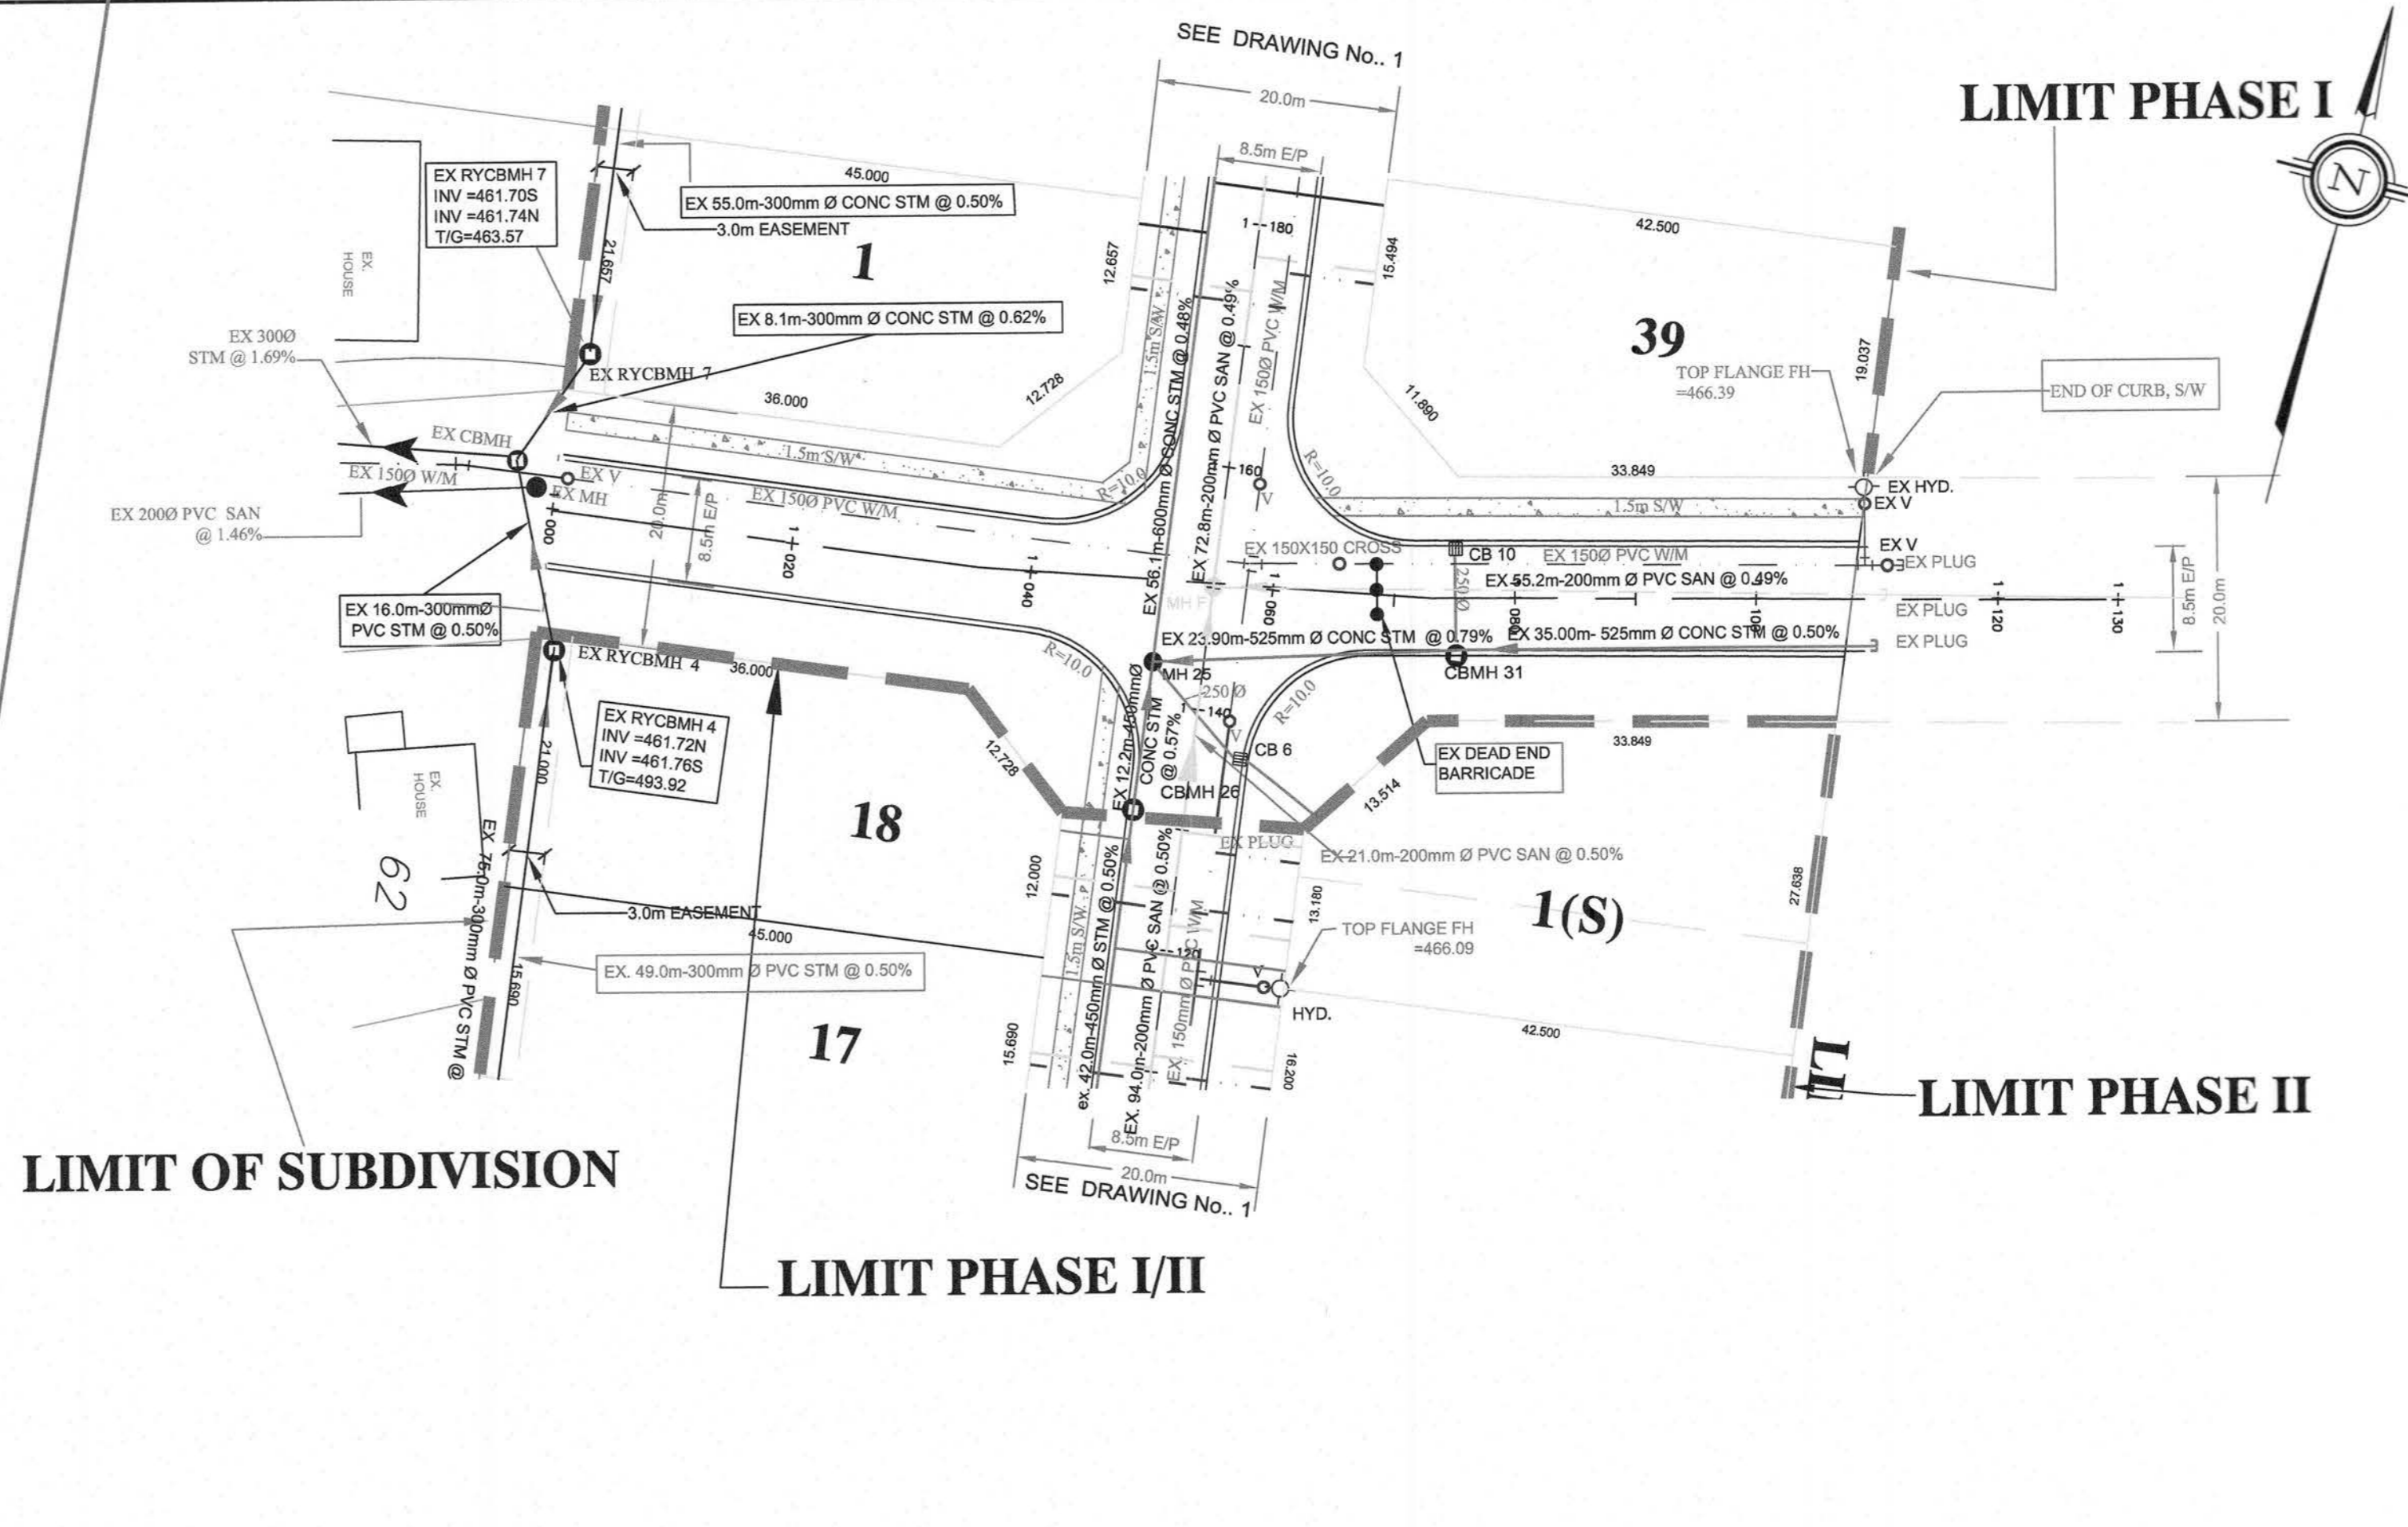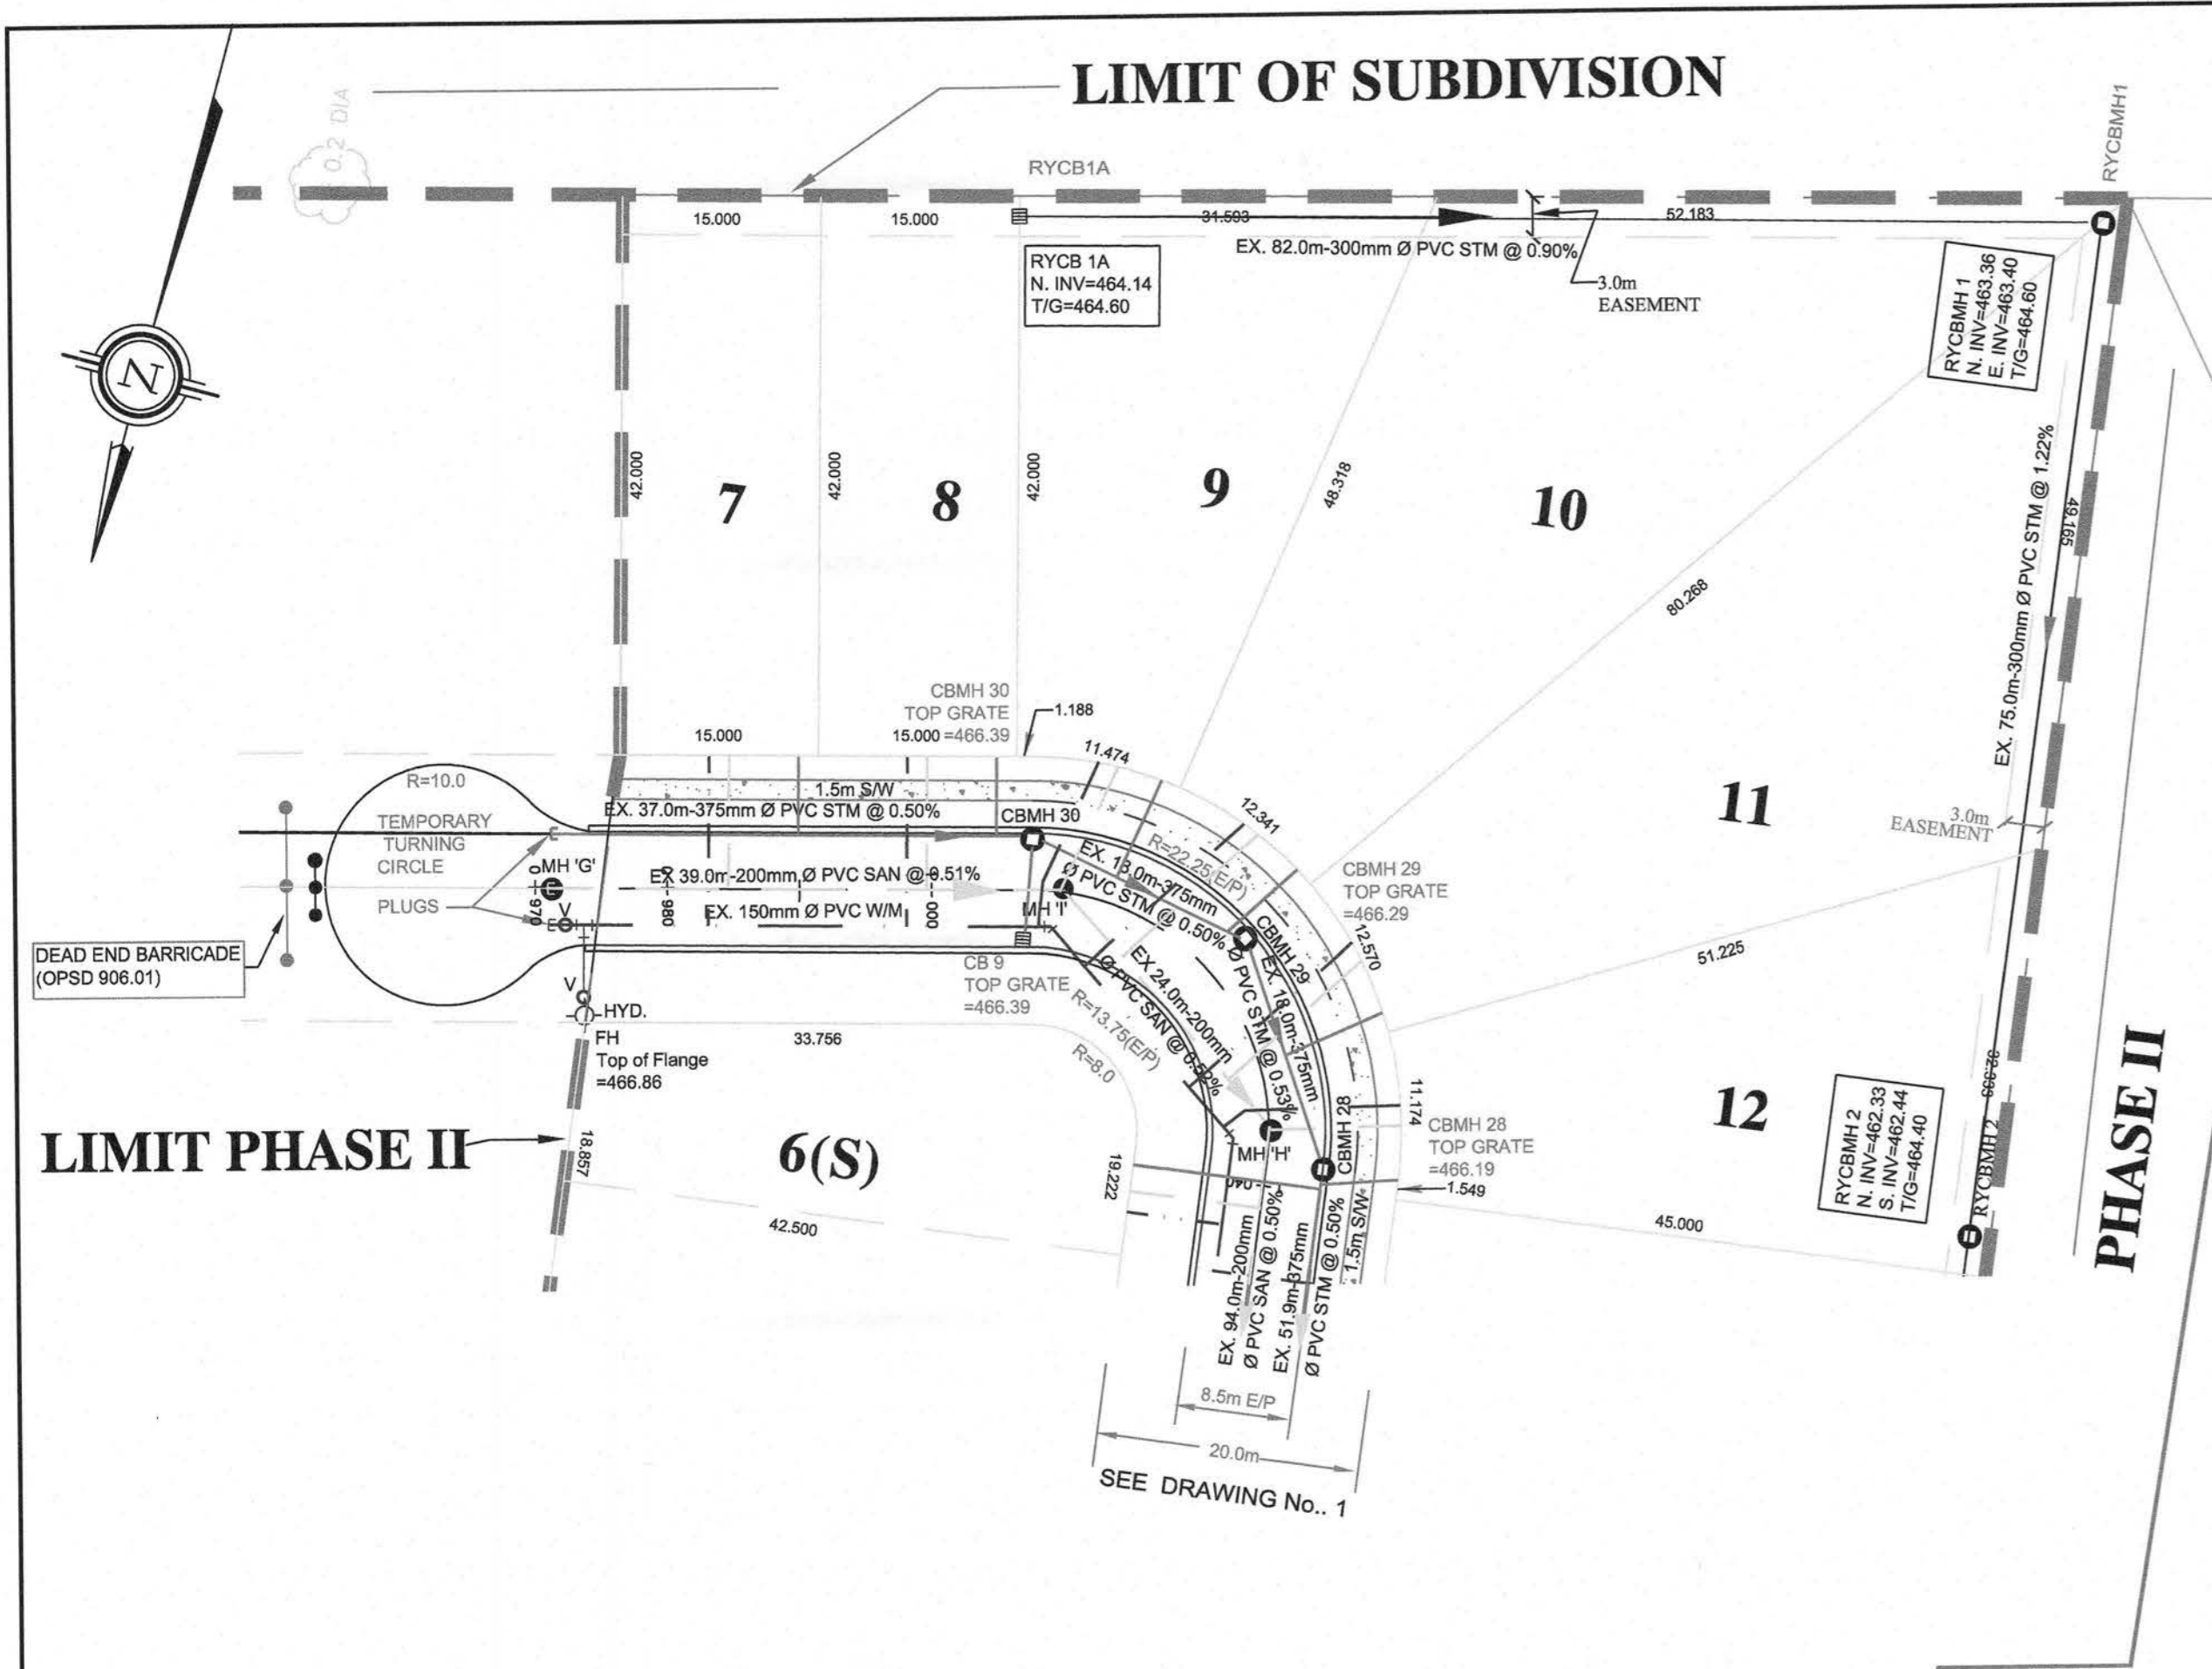

- BENCH MARKS:**
- TOP OF STORM MANHOLE IN BOULEVARD AT SOUTHWEST CORNER OF ELIZA STREET AND GORDON STREET ELEV 462.03
 - TOP OF SANITARY MONHOLE IN CUL-DE-SAC ON FARREL STREET. ELEV 462.31
 - TOP OF SANITARY MANHOLE AT EXISTING EAST LIMIT OF EASTVIEW ANNUUE. ELEV 464.27

- NOTES:**
- 150mm Watermain shall be C900 PVC Class 150(DR18), B137.3 with Ring-Tite joints and Tracer Wire. Tracer Wire shall be 12 gauge, 7 strand copper with plastic coating and shall be connected to both on bottom flange of the hydrant. Storm Watermain shall be Type 'K' copper pipe. Watermain and services shall be installed minimum 2.0 m below finished grade above the main or service.
 - Watermain fittings - Ductile Iron, mechanical joint, AWWA C110 approved, pressure rating 1035 kPa. PVC bands and ties to be used with mechanical joint restraints.
 - Watermain valves shall be Mueller "Super Seal" Resilient Gate Valve, mechanical joint.
 - Watermain Valve Boxes shall be VBS100, 3 slot No. 8 round base screw type as manufactured by BBSB-ST CROIX FOUNDRIES INC., Cambridge, Ontario.
 - Hydrants shall be Canada Valve New Century Type Compression or Midway M-59 with "Slorz" summer connection. All hydrants to be painted yellow with black "Slorz" cap.
 - Water services to be 20mm single Type 'K' copper pipe.
 - Arrestors: DZP-24, 10 kg shall be installed on all connections to existing iron watermain.
 - DZP-12, 5.4 kg shall be installed on all iron fittings, valves etc.
 - Main stops, curb stops, unions and service boxes shall be in accordance with the Township of Wellington North Specifications.
 - Sanitary sewer shall be 200mm PVC-SDR35 meeting the current ASTM D3034 Specifications and CSA-182.2.
 - Sanitary Services shall be 100mm PVC-SDR28 meeting the current CSA-182.2 Specifications. Service connections to be at a minimum grade of 2%. All connections to new mains shall have manufactured tees. All new connections to existing mains shall use stainless steel straps and saddles. Sanitary Services shall be 100mm PVC-SDR28 meeting the current ASTM D3034-73 Specifications and CSA-182.2.
 - Sanitary sewer mainline fittings shall be PVC-SDR35 meeting the current ASTM D3034-73 Specifications and CSA-182.2.
 - Storm sewers 375mm and less shall be either Concrete E.S. or PVC Ultra-50 as per CSA-182.4.
 - All storm services shall be 100mm PVC-SDR28 and connected to mainline with prefabricated tee or "Kor-N-Tee".
 - All cast-iron tees (200mm Single, 300mm Double) shall be PVC-SDR35.
 - All sewer pipes and watermain to be installed in Class 'B' Bedding per OPSD 802.01 and 802.03.
 - Pavement design for all roads shall be:
450mm Granular 'B' road base
150mm Granular 'A' road base
50mm H-4 Binder Course Asphalt
40mm H-3 (fin) Surface Course Asphalt
 - Concrete Curbs and sidewalks shall be poured using 30MPa strength @ 28 days.
 - All watermain and sewers to be tested in accordance with Township of Centre Wellington Specifications or as noted in the Contract Documents.
 - Soil subdrains to be installed if required as determined by site conditions at time of construction. Subdrains shall be 100mm perforated plastic drainage tile on geotextile filter sock.
 - Concrete Curb to be barrier as per OPSD 600.10
 - Water Service Boxes to be located at limit of easement.
 - Sump Pumps to discharge to storm services.
 - Driveways shall be:
150mm Granular 'B'
150mm Granular 'A'
50mm H-3 Asphalt
 - All structures shall allow for an adjustment of between 150mm-300mm with modicum.
 - This plan shall be read in conjunction with drwg #2- Grading and Erosion Control Plan and the approved Site Plan and the approved Landscaping Plan (by others).
 - Road Section to be in accordance with Township Standard Drawing 'R1' (see section Drawing #G3).

No.	DESCRIPTION	DATE	INTL.
6	AS-CONSTRUCTED	26/10/10	KJB
5	GENERAL REVISIONS	30/07/10	KJB
4	GENERAL REVISIONS PHASE II	30/05/10	KJB
3	AS-CONSTRUCTED U/G SERVICES	20/07/07	KJB
2	GENERAL REVISIONS	27/10/06	KJB
1	GENERAL REVISIONS	29/09/06	KJB

REVISIONS

CHECKED: [Signature] APPROVED: [Signature]

K. J. BEHM AND ASSOCIATES INC.
CONSULTING ENGINEERS
60 NEW DUNDEE RD., KITCHENER, ONTARIO, N2P 2N6
PHONE (519) 742 3510 FAX (519) 742 3462

**EASTRIDGE LANDING
SUBDIVISION PHASES I AND II
ARTHUR, ONTARIO**

**PLAN AND PROFILE
SCHMIDT DRIVE
STA. 0+960 TO STA. 1+040**

**PLAN AND PROFILE
EASTVIEW DRIVE
STA. 0+960 TO STA. 1+120**

DRAWN	SM	SCALE	DWG. No.
DESIGN	KJB	1:500	3
CHECKED	KJB	DATE	JUNE 2006
PROJECT No.	260606		